



SNEIÐING A-A

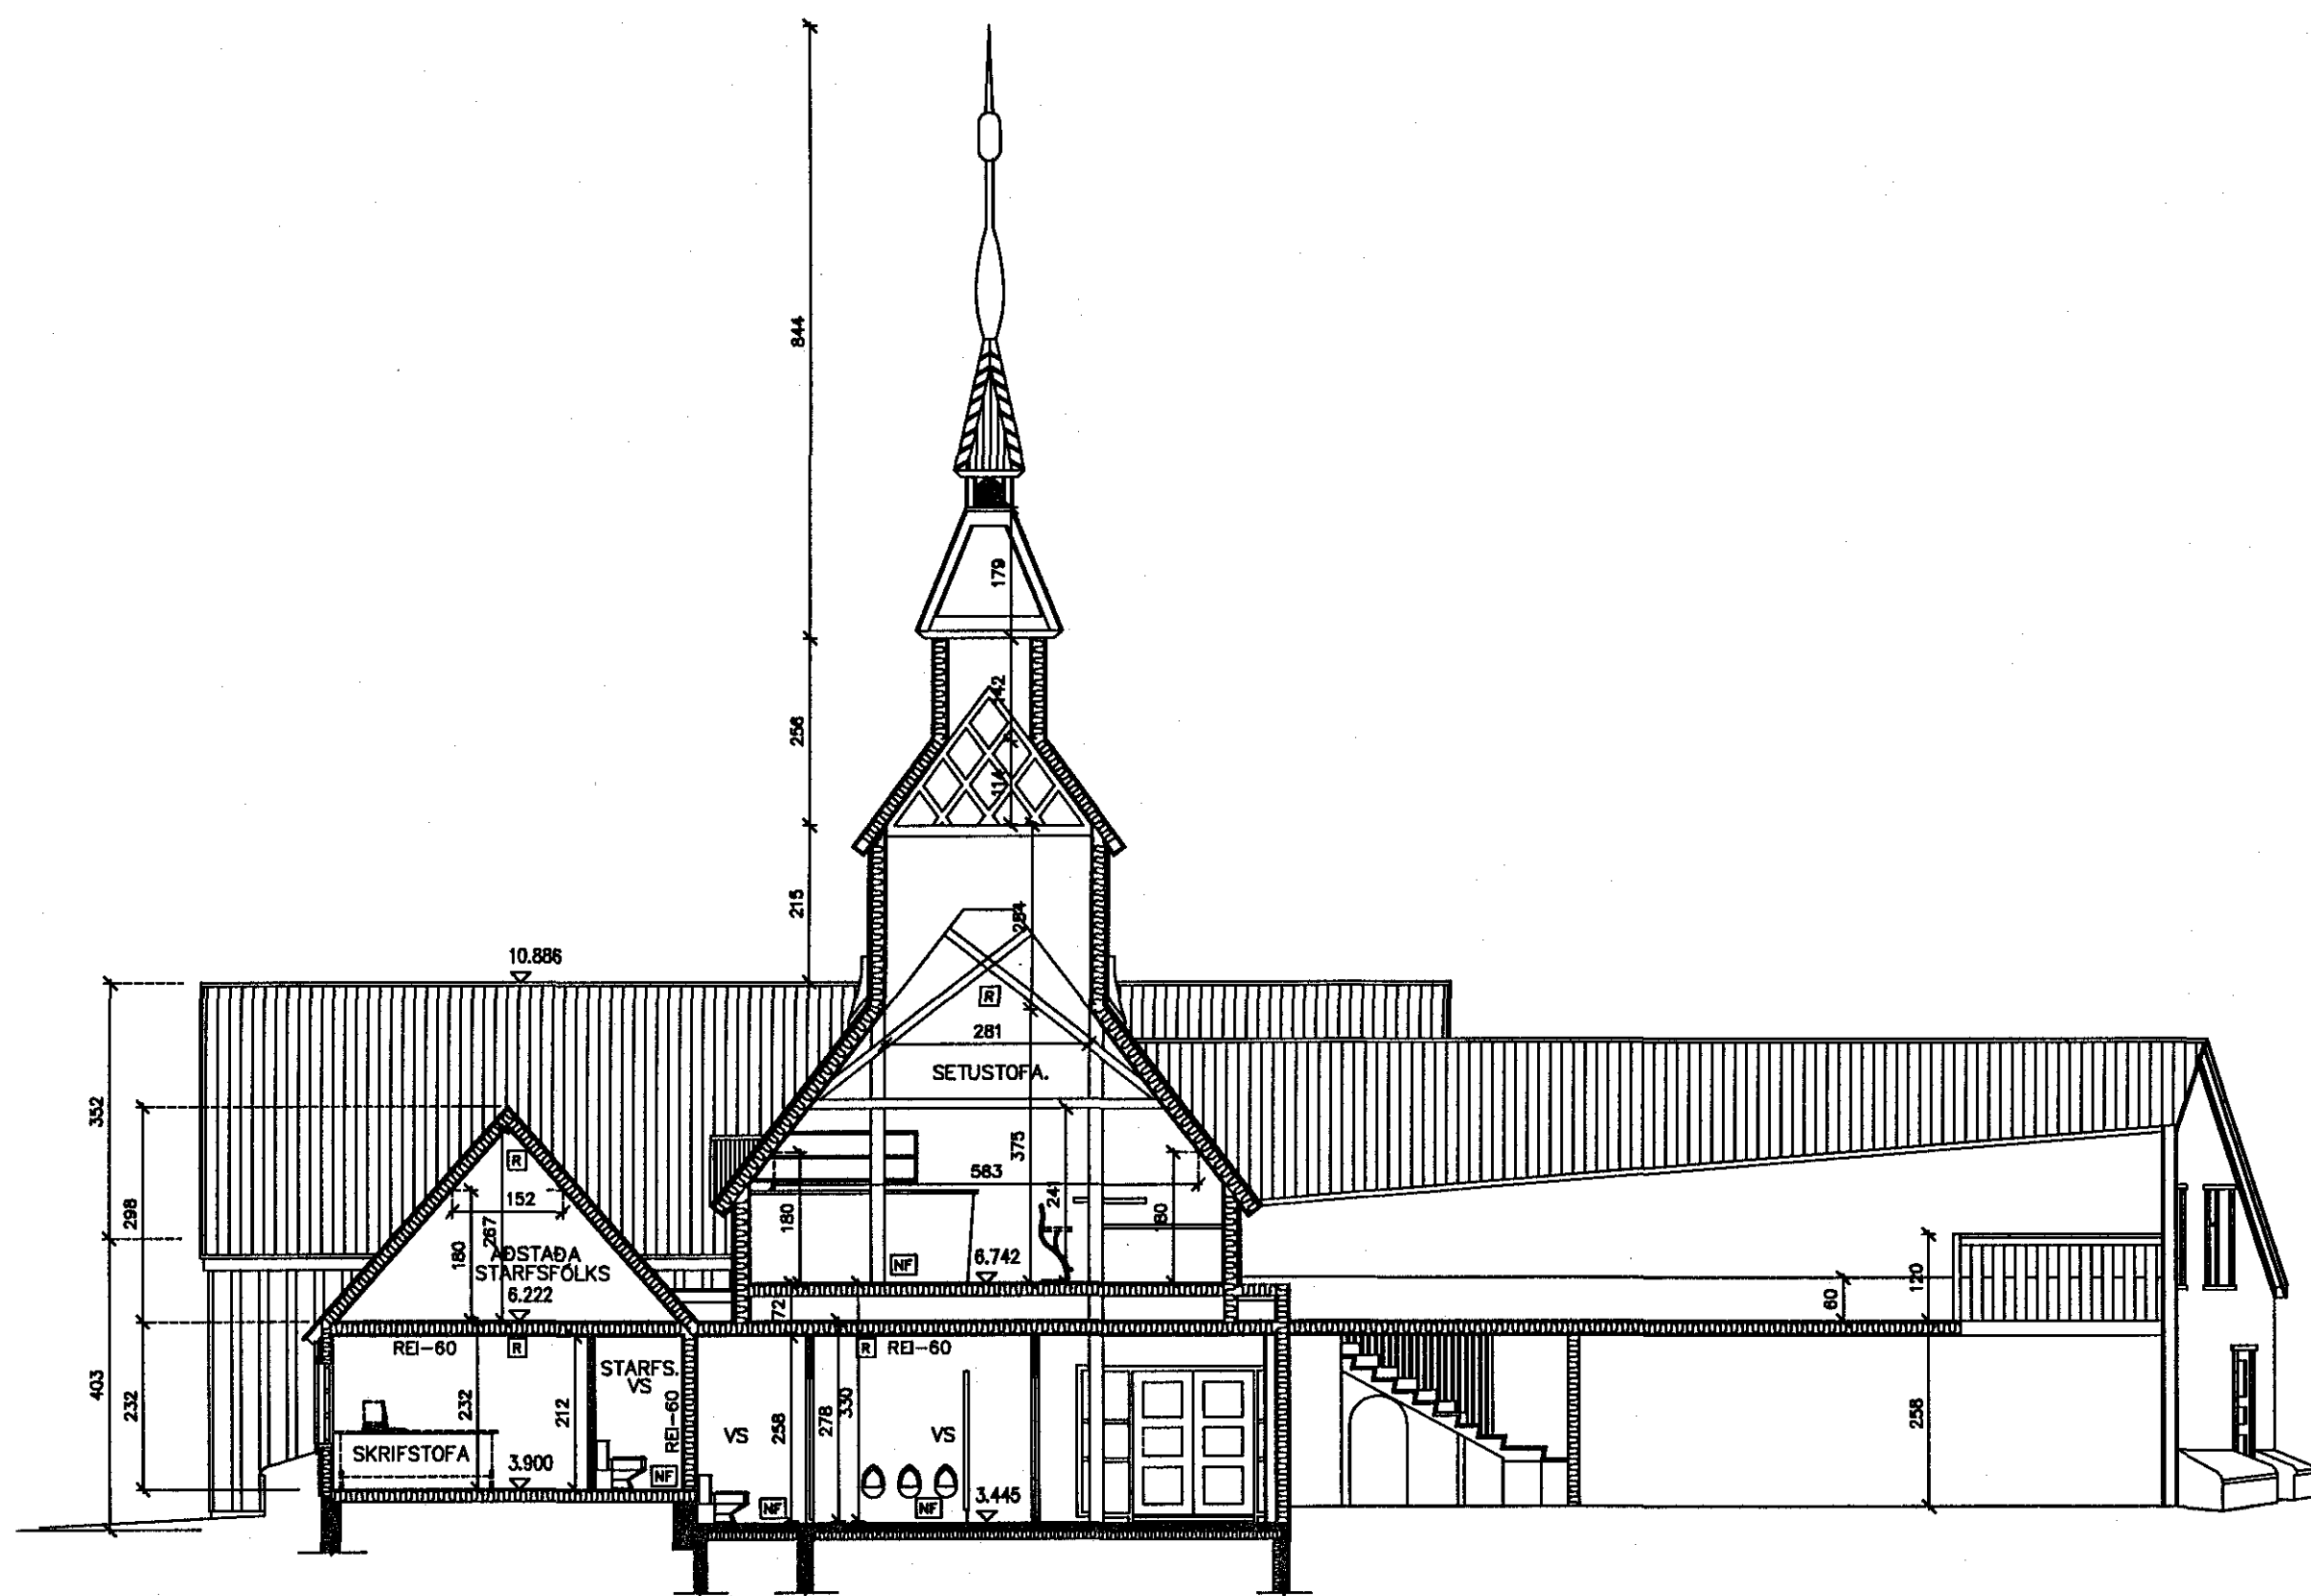


SNEIÐING B-B

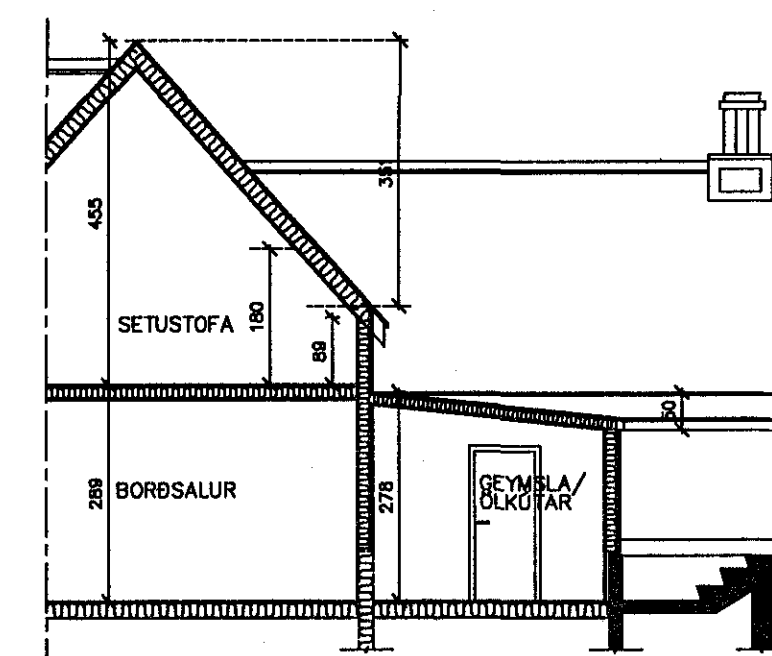

SNIÐ C-C
KÆLIR/ GEIMSLU

C:
B:
A:
BREYTINGAR: DAGS:

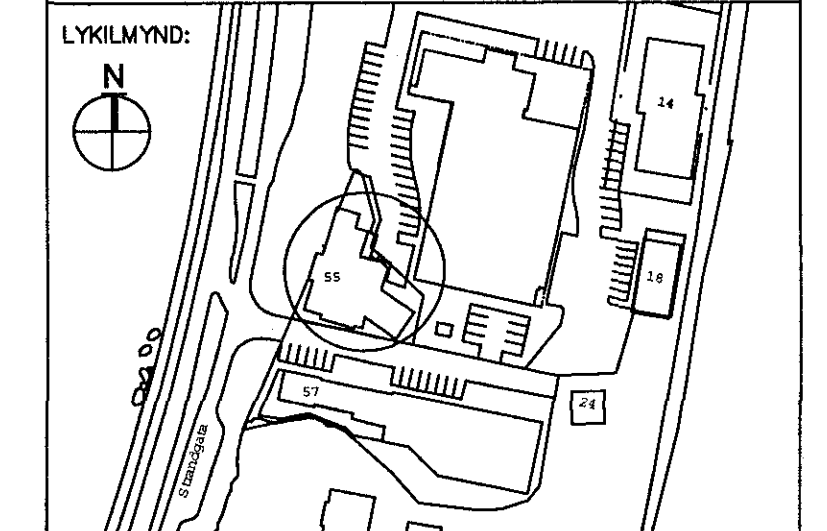

LYKILMYND:

VERKKAUPI:
FJÖRUKRÁIN ehf.
Strandgötu 55.
220 Hafnarfirði.



ADALUPPDRAÐTUR / REYNDARTEIKNING.
SNEIÐINGAR

VERK: FJÖR-0408 TEIKNINGANR: A-0103
KVARÐI: 1:100 TEIKNAD: PMM
DAGS: 10.10.2005. SKRÁ: .DWG

ÚTI INNI

ARKITEKTAR

ÞINGHOLTSSTRÆTI 27 101 REYKJAVÍK
SÍMAR 5527660 & 5627660 FAX 5527661
NETFANG u@ul.is
VEFFANG http://www.ul.is

BALDUR Ó. SVAVARSSON ARKITEKTAR FAI
120357-5149
JÓN ÞÓR ÞORVALDSSON ARKITEKTAR FAI
021258-7579

A-0103