




NORÐ- AUSTUR

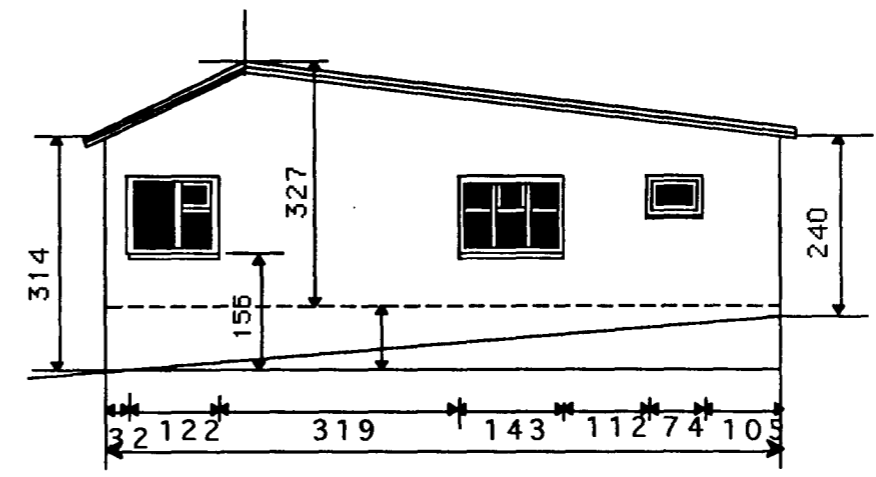

SUÐ-AUSTUR

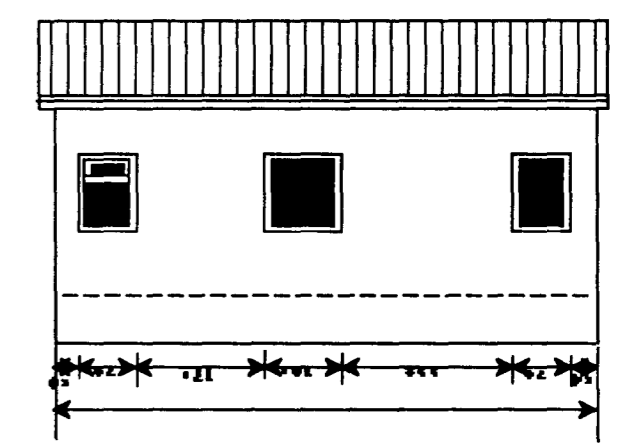


SUÐ- VESTUR

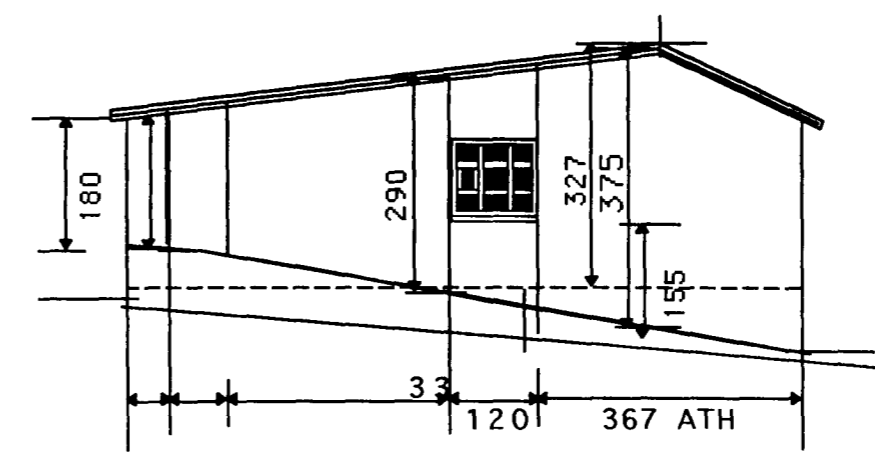

NORÐ-- VESTUR

GRUNNMYND 1:100

HÚS MÆLT UPP OG TEIKNAD ÞAR SEM EKKI ERU TIL TEIKNINGAR AF ÞVÍ.

	Heiti	VITASTÍGUR 10	kvarði	1:100	verk nr.
		HAFNARFJÖRÐUR	dags.	MARS 97"	týpa nr.
	Verkefni	GRUNNMYND- ÚTLITSMYND	hönnun	G.G.	teikn. nr.
		UPPMÆLING	teikn	G.G.	<b>A-1</b>

Hringbraut 17 220 Hafnarfjörður, Sí. 555-2020 FAX 555-2021