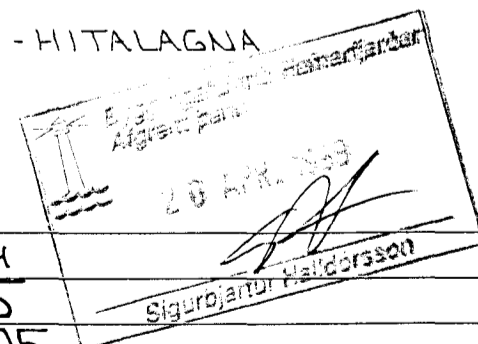



RÚMMYND - HITALAGNA * 1:50

ofn nr.	Staðsetn.	Hitapörf kcal/h	Lengd MM	m. Hæð MM	tenging.
101	ANDD	500	900	600	CD
102	VS	300	700	600	CD
103	PVOTTUR / G	300	900	600	CD
104	BORÐSTOFA	1080	1800	200	AD
105	STOFA	1680	2800	200	AD
106	BÍLG	1490	2000	600	BC
201	BAD	500	900	600	AB
202	HERB	1240	1800	600	CD
203	HERB	1050	1300	600	AB
205	FJÓLSK	1590	1800	200	AD
206	HJÓN	1020	1800	600	AD
SAMTALS		11.050			

ÁÐUR EN OFNAR ERU PANTADIR SKULU ARKITEKT OG TÆKNIFRÆÐINGUR YFIRFARA OFNATILBOÐID.
 STÆRD OFNA SKAL VERA SEM NÆST:
 HÆÐ = 20 SM LÆGRI EN HÆÐ FRÁ GÓLFI OG UPPÍ SÓLBEKK
 LENGÐ = 10 - 15 SM STYTTRI EN GLUGGABREYDD

01	APRIL 99	OFN 204 BURT	GH
BR.	DAGS.	EÐLI BR.	SIGN.
VÖRÐUBERG 10 HAFNARFIRÐI			
RÚMMYND - HITALAGNA			
			
MKV. * 1:50	DAGS. JÚNÍ '94	VERK NR. 9425	TEIKN NR. 2-05
HANNAD	TEIKNAD GH	YFIRFARID	
			
STRANDGÖTU 11 - 220 HAFNARFJÖRÐUR - SÍMI 54255 - FAX 652875			