


ALMENNAR SKÝRINGAR SJÁ BL.NR. 2-01
AFSTÖÐUMYND SJÁ BL.NR. 2-02.

01	7.11.94	PN. FERT	GH
BR.	DAGS.	EDLI BR.	SIGN.

VÖRÐUBERG 14
HAFNARFIRÐI

GRUNNMUND - GRUNNLAGNA

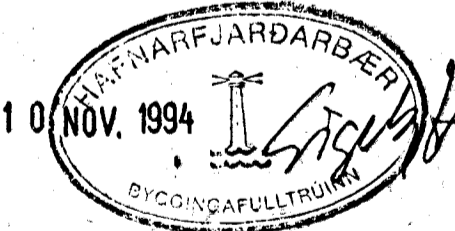

*Logi
Stian*

*Afrennsli hitaveitan.
Fer í let.
Skolplögn.*

MKV	1.50
DAGS.	
VERK NR.	9427
TEIKN NR.	2-03
HANNAÐ	
TEIKNAD	GH
YFIRFARID	

TSP TÆKNIJÓNUSTA
SIGURDAR ÞORLEIFSSONAR HF

STRANDGÖTU 11 · 220 HAFNARFJÖRÐUR · SÍMI 54255 · FAX 652875