


GRUNNMÝND 1 HÆÐAR 1:50



GRUNNMÝND 2 HÆÐAR 1:50

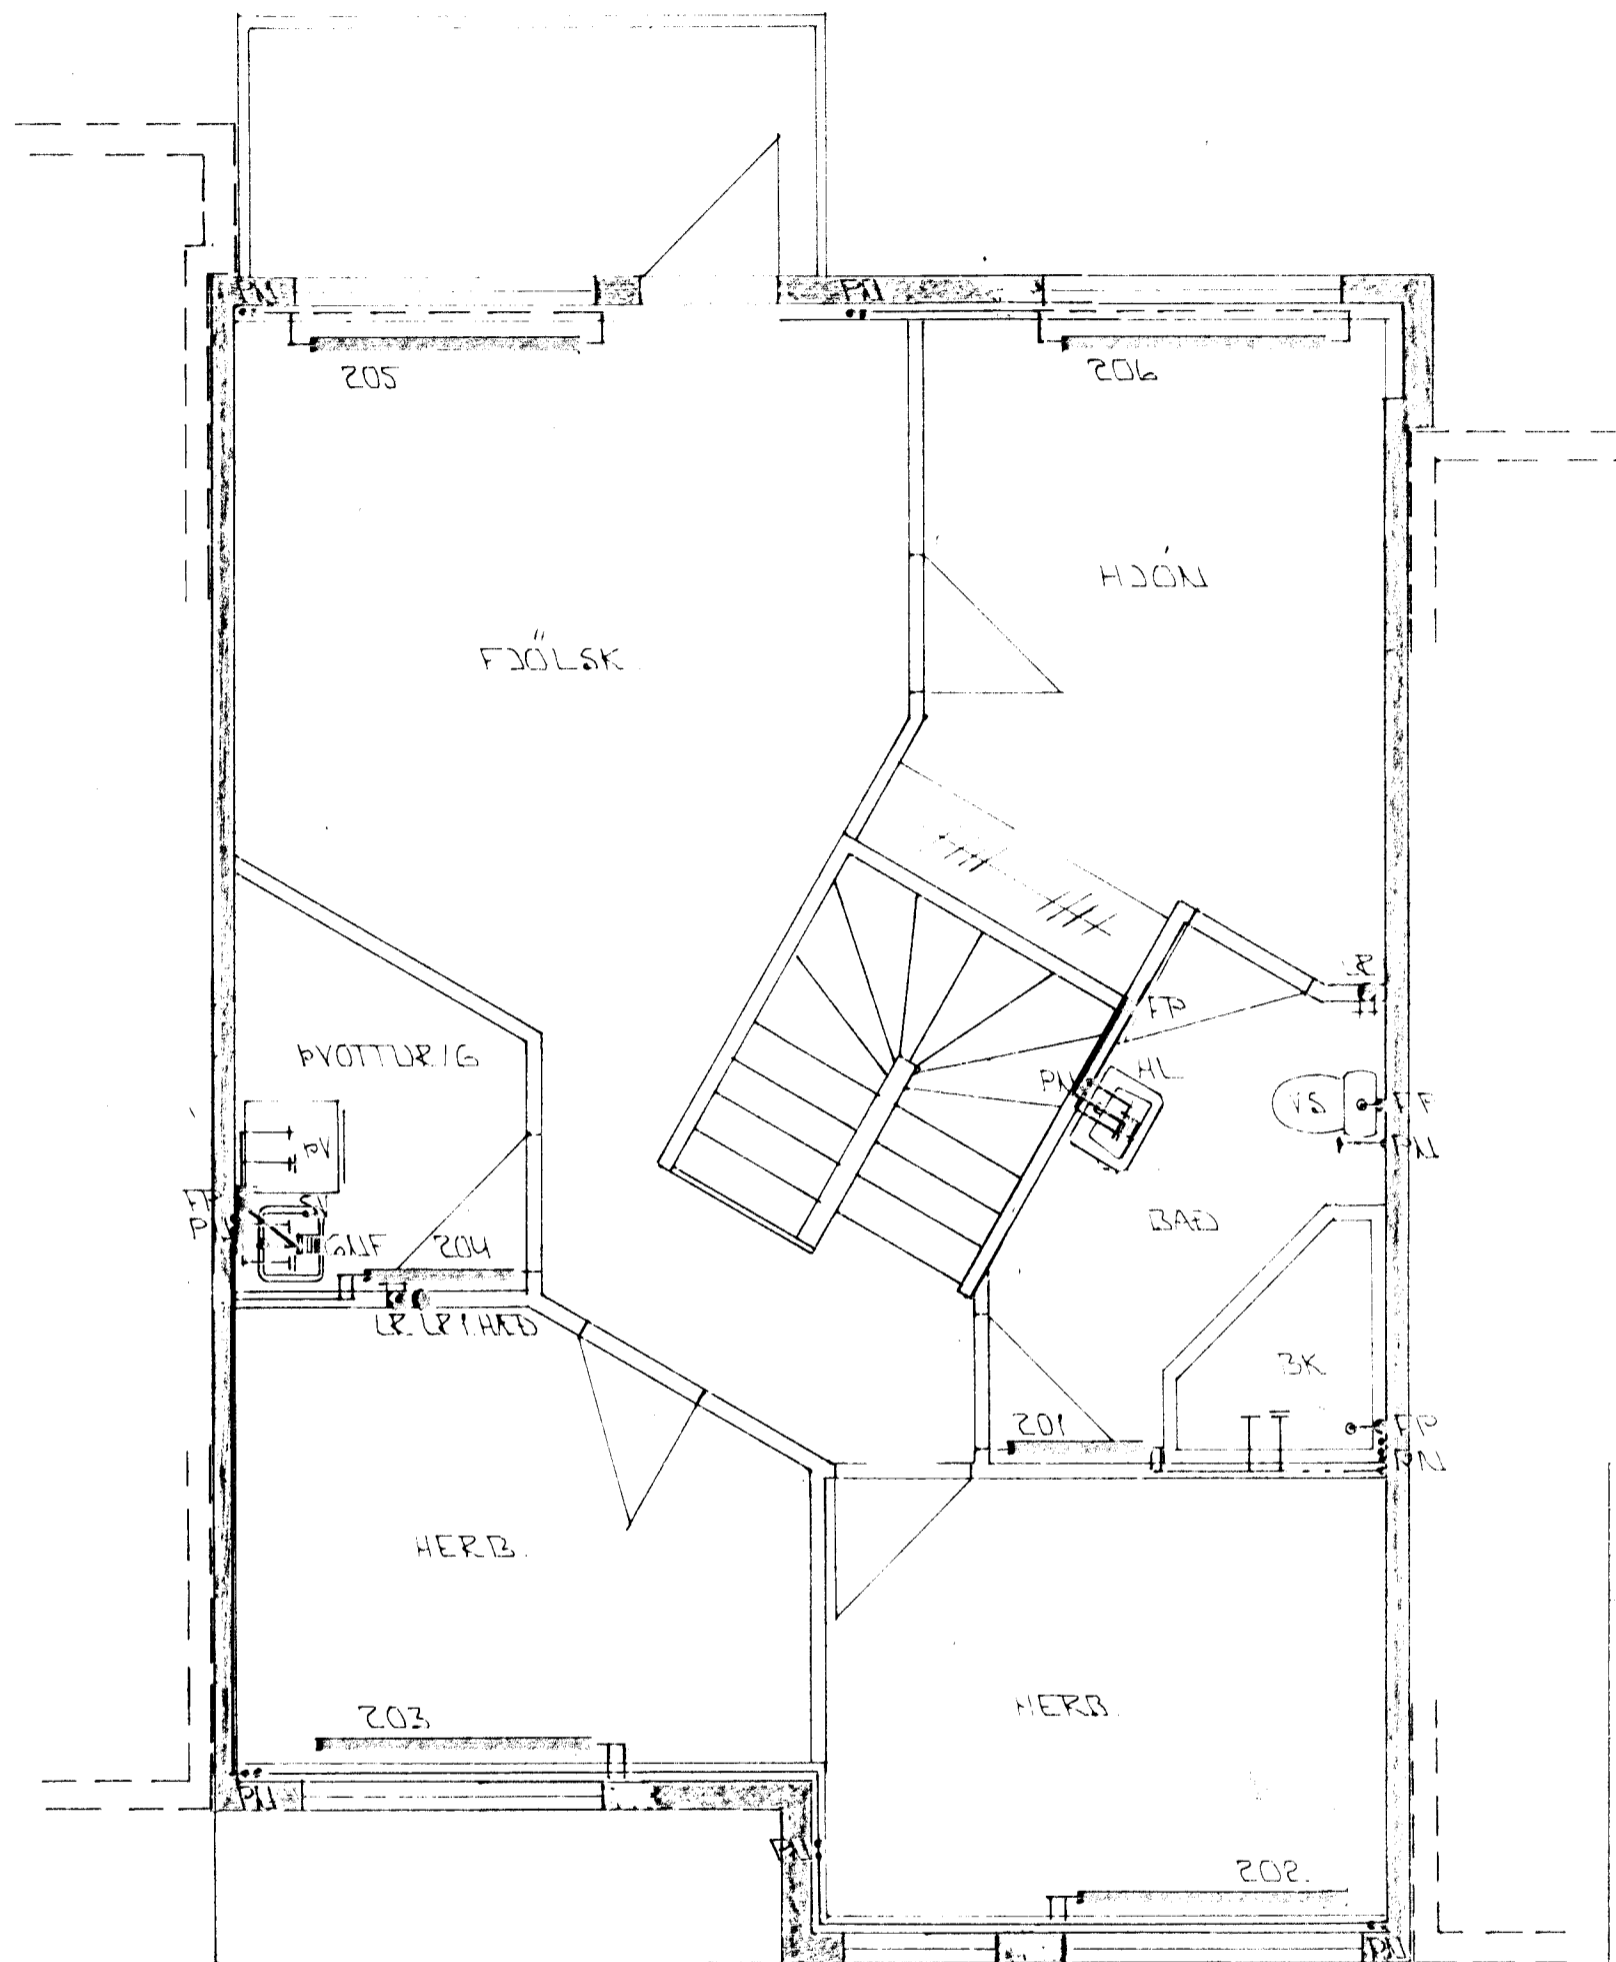

01	JÚN '97	PVOTTURIG BURT I HÖD SVÍBUL.	GR
BR.	DAGS	EDL BR	SIGN

VÖRÐUBERG 16
HAFNARFREDI

HITA - VATNS OG FRÆNNISLIS -
LAGNIR 1 OG 2. HÆÐAR

MKV. 1: 1:50
DAGS JÚNÍ '94
VERK NR. 9428
TEIKN NR. 2-04
HANNAD *[Signature]*
TEIKNAD *[Signature]*
YFIRFARIÐ *[Signature]*

TAKNI-JÓNUSTA
SIÐURAR ÞORÞORSSONAR III

STRANDGÖTU 11 - 220 HAFNARFJÖRÐUR - SÍM 43255 - FAX 63225