
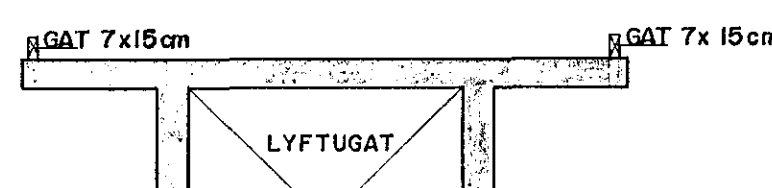
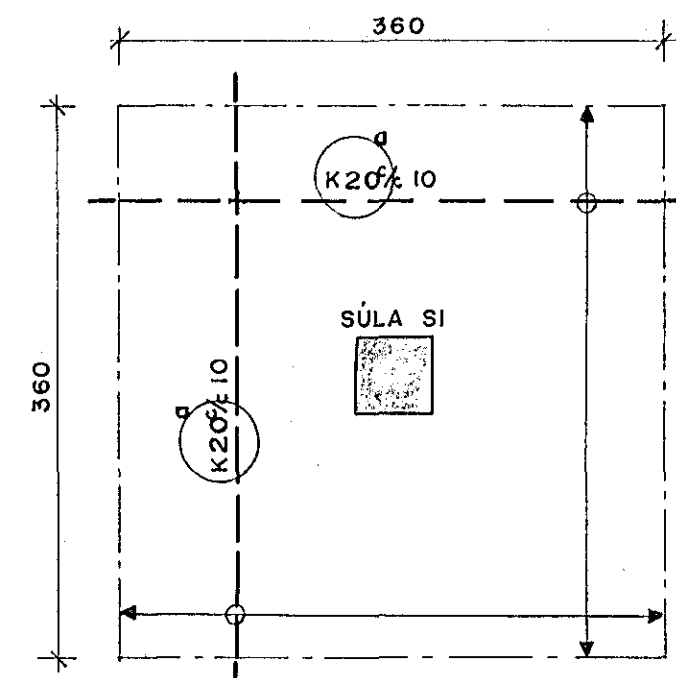
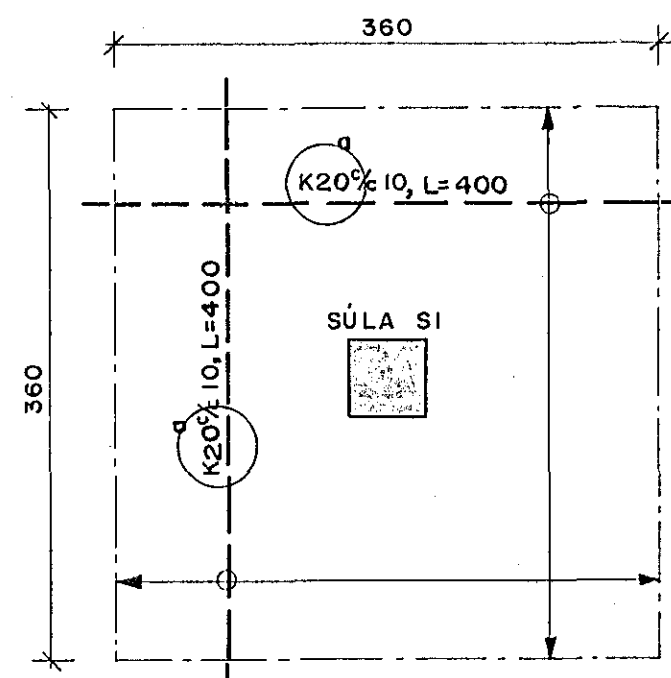


GRUNNMYND 1:50

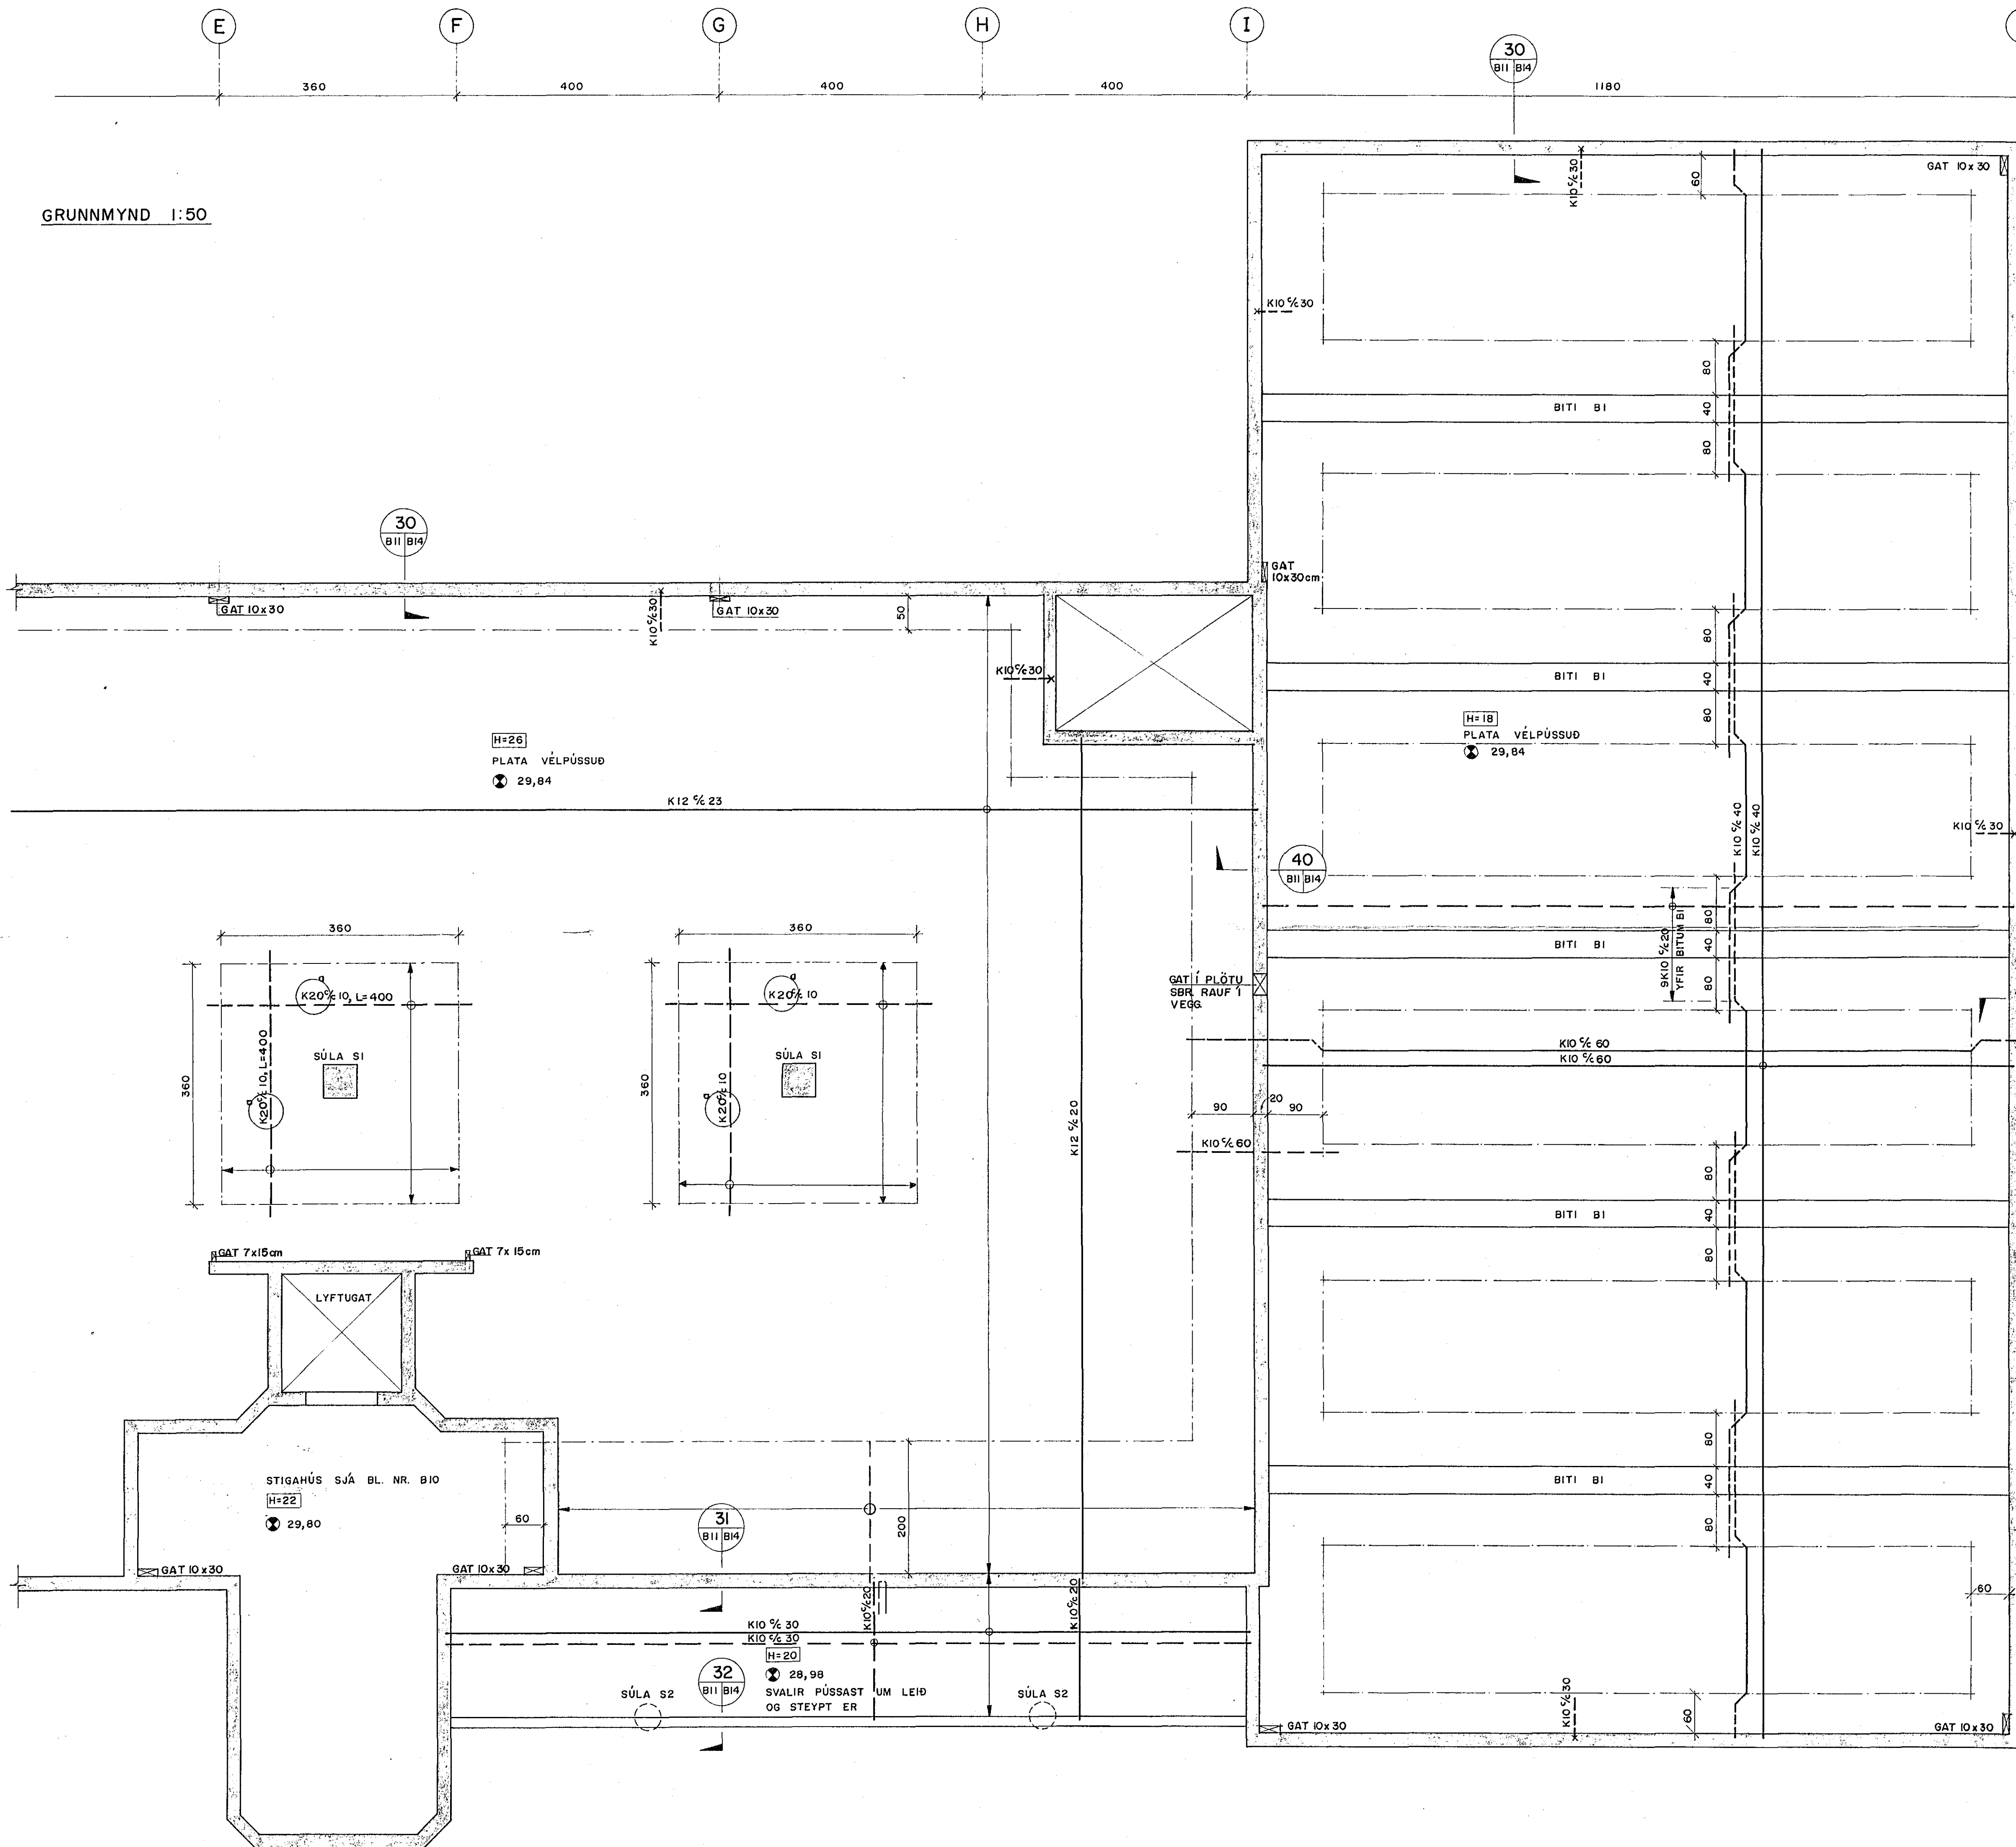

STIGAHÚS SJÁ BL. NR. B10
H=22
29,80

31
B11/B14

32
B11/B14

KIO % 30
KIO % 30
H=20
29,98
SVALIR PÚSSAST
OG STEYPT ER UM LEIÐ

1
2
3
4
5
6
7



STEYPA S-250
NOTÁLAG 2KN/m² (200 kg/m²)
BREYTT 3.08.88 járn í svölum.
BREYTT 10.05.88

BÆJARHRAUN 2, HAFNARFIRÐI	
PLÖTUR;	KVARÐI 1:50
PLATA YFIR JARÐHÆÐ	VERK NR. 8703
GRUNNMYND F-J	BL. NR. B11
Verkfæðistofa Stefáns Veturildasonar CONSULTING ENGINEERS	ADALSTRÆTI 15 BOLUNGARVÍK - Sími 84-7578 REYKJAVÍKURVEIÐ 68 HAFNARFIRÐI - Sími 81-53768
DAGS. APRÍL 1988	TEIKN. e.n. REIKN. S.V.
SAMP	