
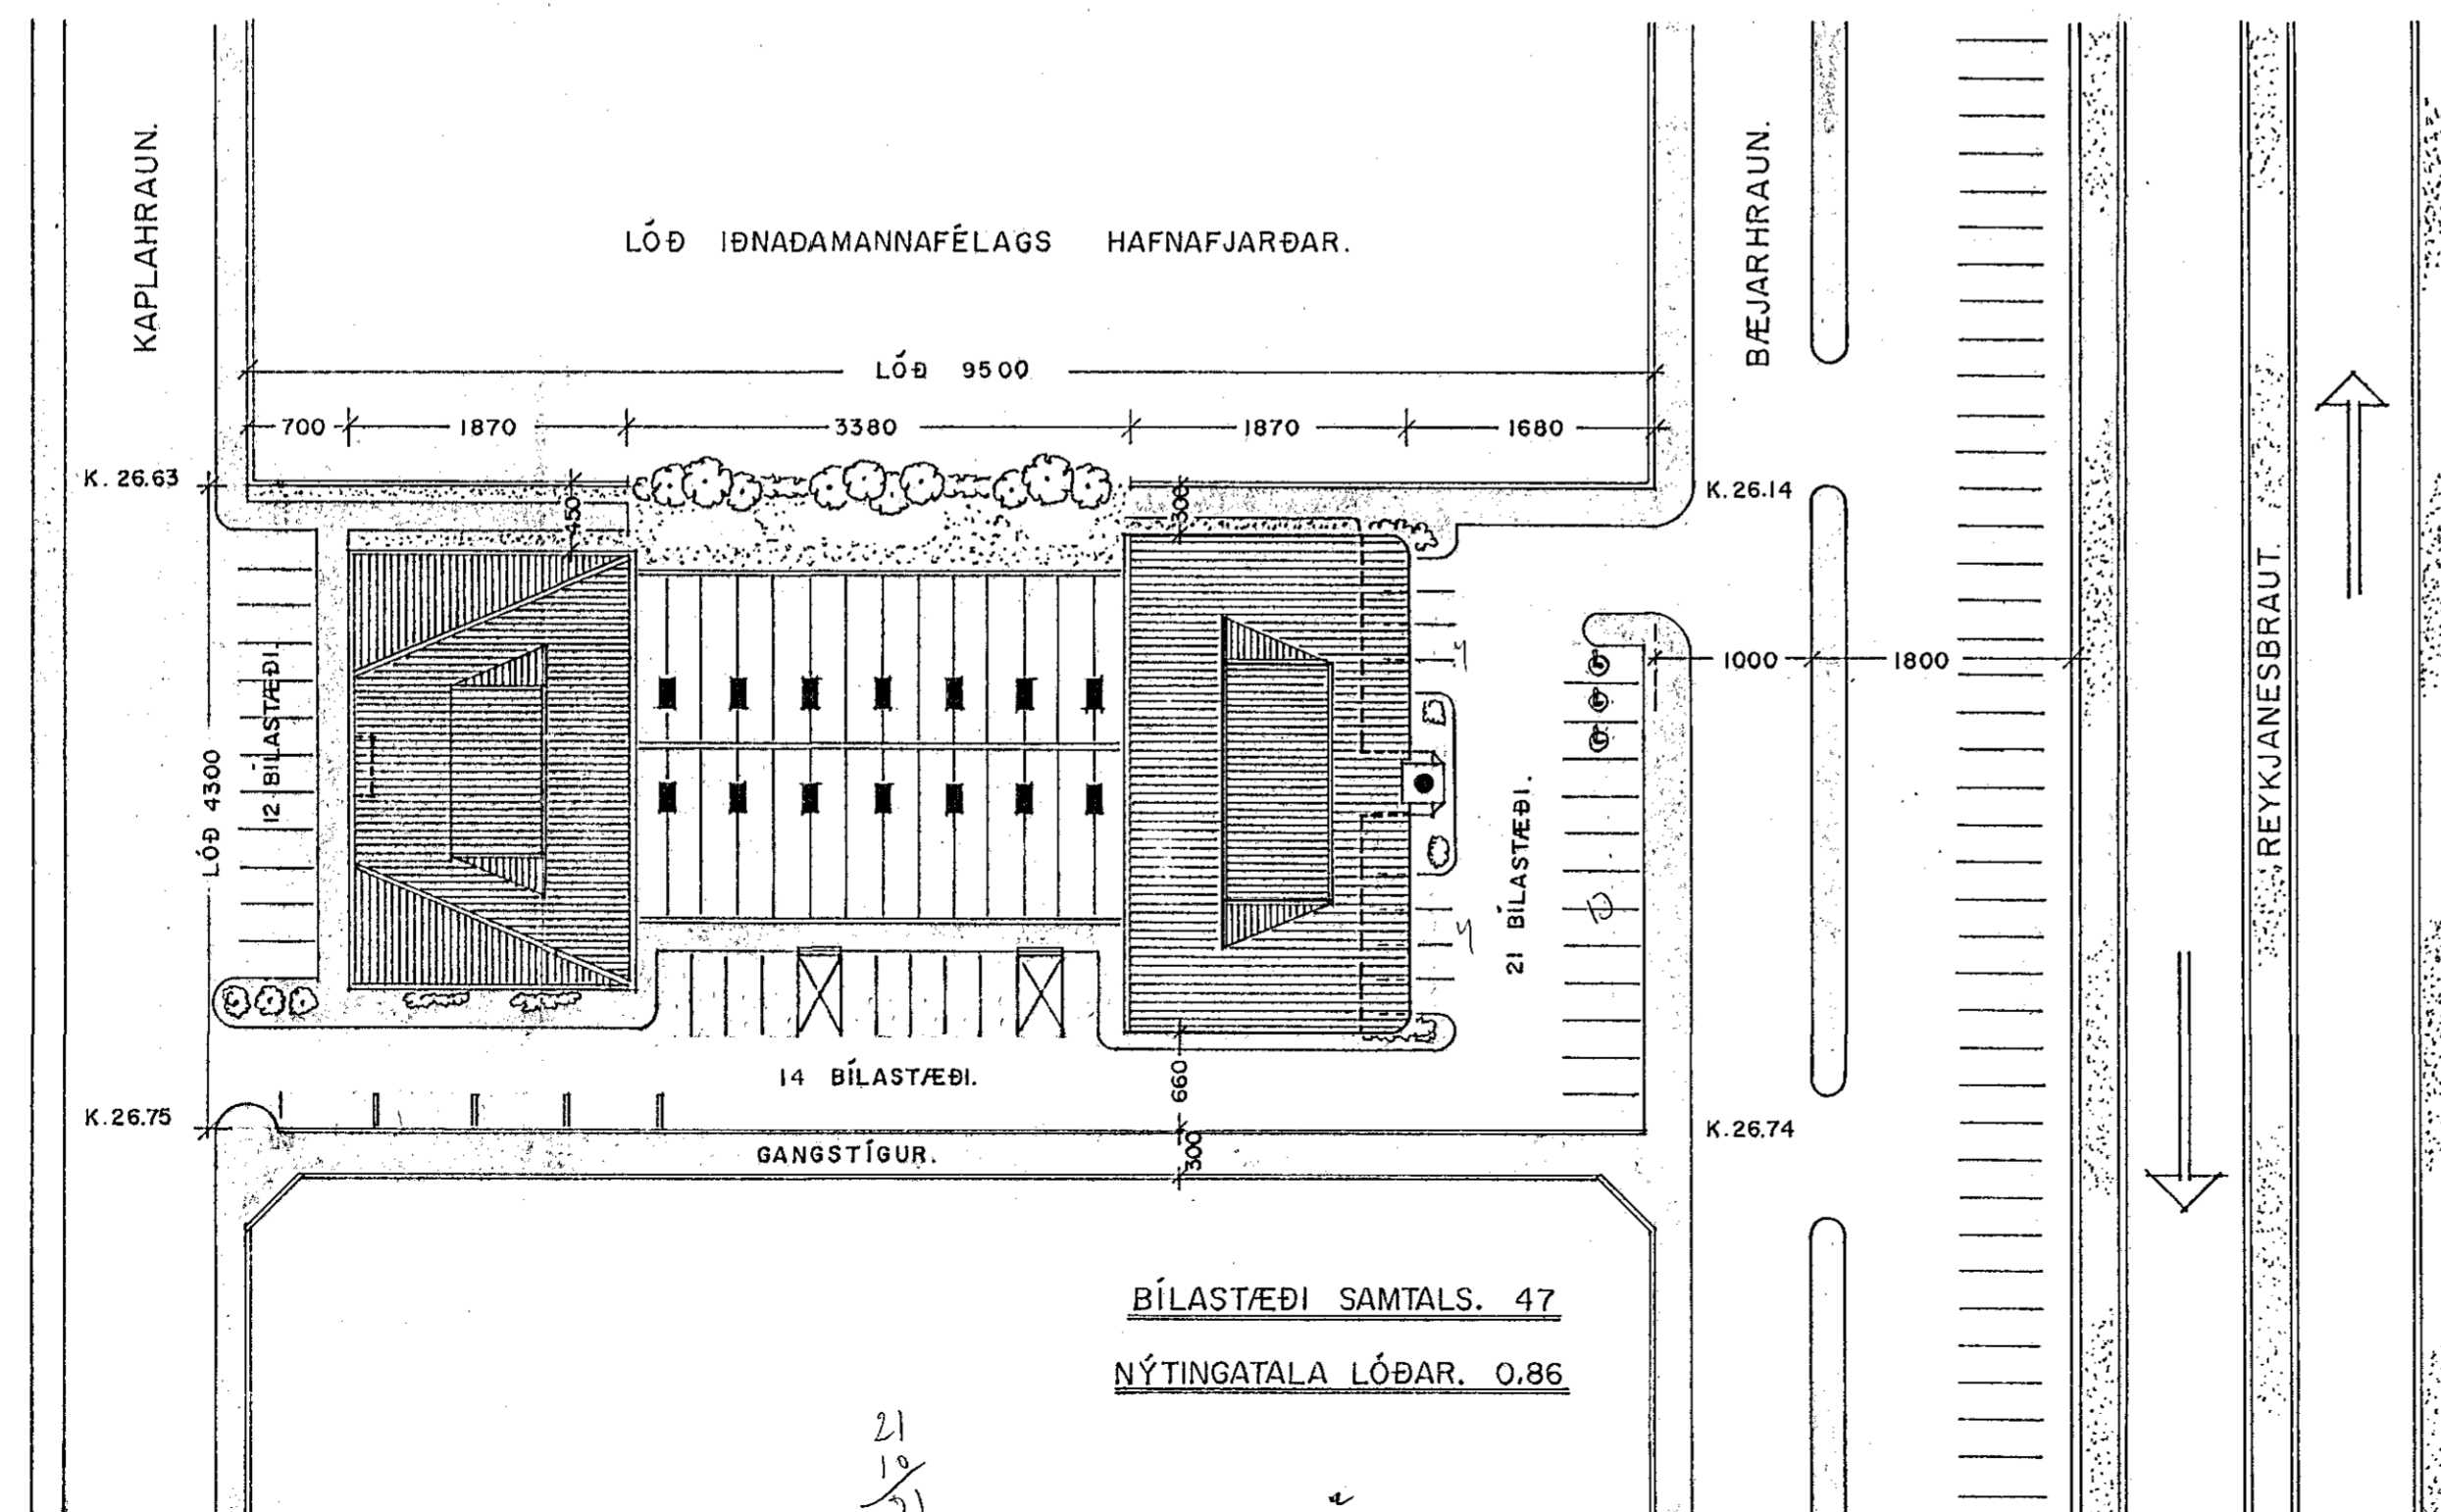


PERSPEKTIV FRÁ REYKJANESBRAUT.

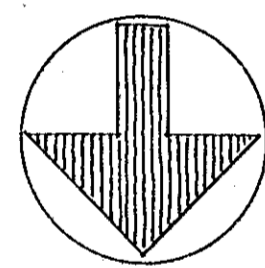

BÍLASTÆÐI SAMTALS. 47  
NÝTINGATALA LÓÐAR. 0.86

*Handwritten notes:*  
21  
19  
1/4  
25  
4  
39 bilstæði x 60 = 2340m²

FLATARMÁL:	
1. ÁFANGI	791 m <sup>2</sup>
2. ÁFANGI	1554 m <sup>2</sup>
<b>SAMTALS</b>	<b>2345 m<sup>2</sup></b>

AFSTÖÐUMYND 1:500

SAMPYKKT 0504 1983  
SBR. BRÉF DAGSD. 041983  
*Handwritten signature: Jón Guðmundsson*

BÆJARHRAUN 4 - KAPLAHRAUN 3 - HAFN  
 ARKITEKT. JÓN GUÐMUNDSSON - FAI  
 MIKLUBRAUT 58 - RVÍK - SÍMI 3834  
 MÁL. DAGS. 9-3-83  
 SÁMUR Jón Guðmundsson