

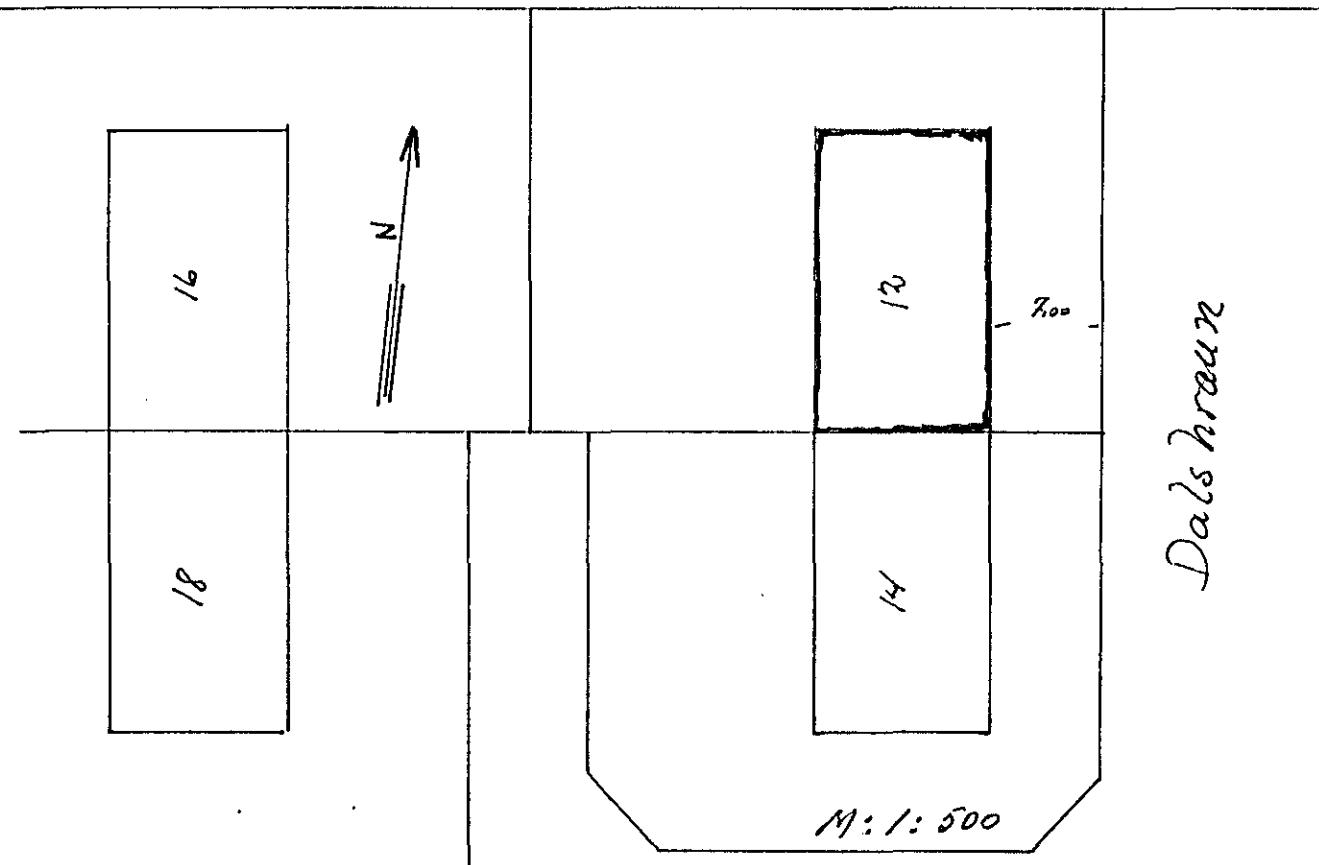


Húsveita nr. 2229 Teikning nr. 1409
 Samþykkt b. 31. 7 1973
 f.h. RAFVEITU HAENAR JARDAR
 Bjarni Þórhallsdóttir
 Ettrilitsmaður fyrirlagna

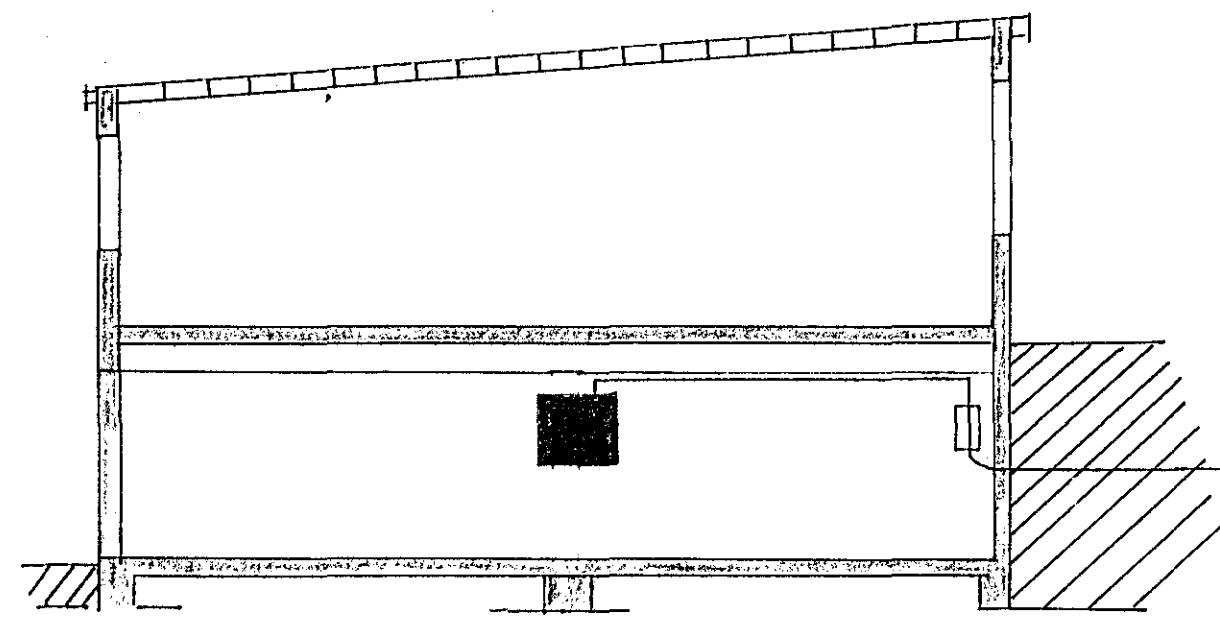

Inntök samþykkt 31. 7. 1973

f.h. RAFVEITU HAENAR JARDAR
 Bjarni Þórhallsdóttir

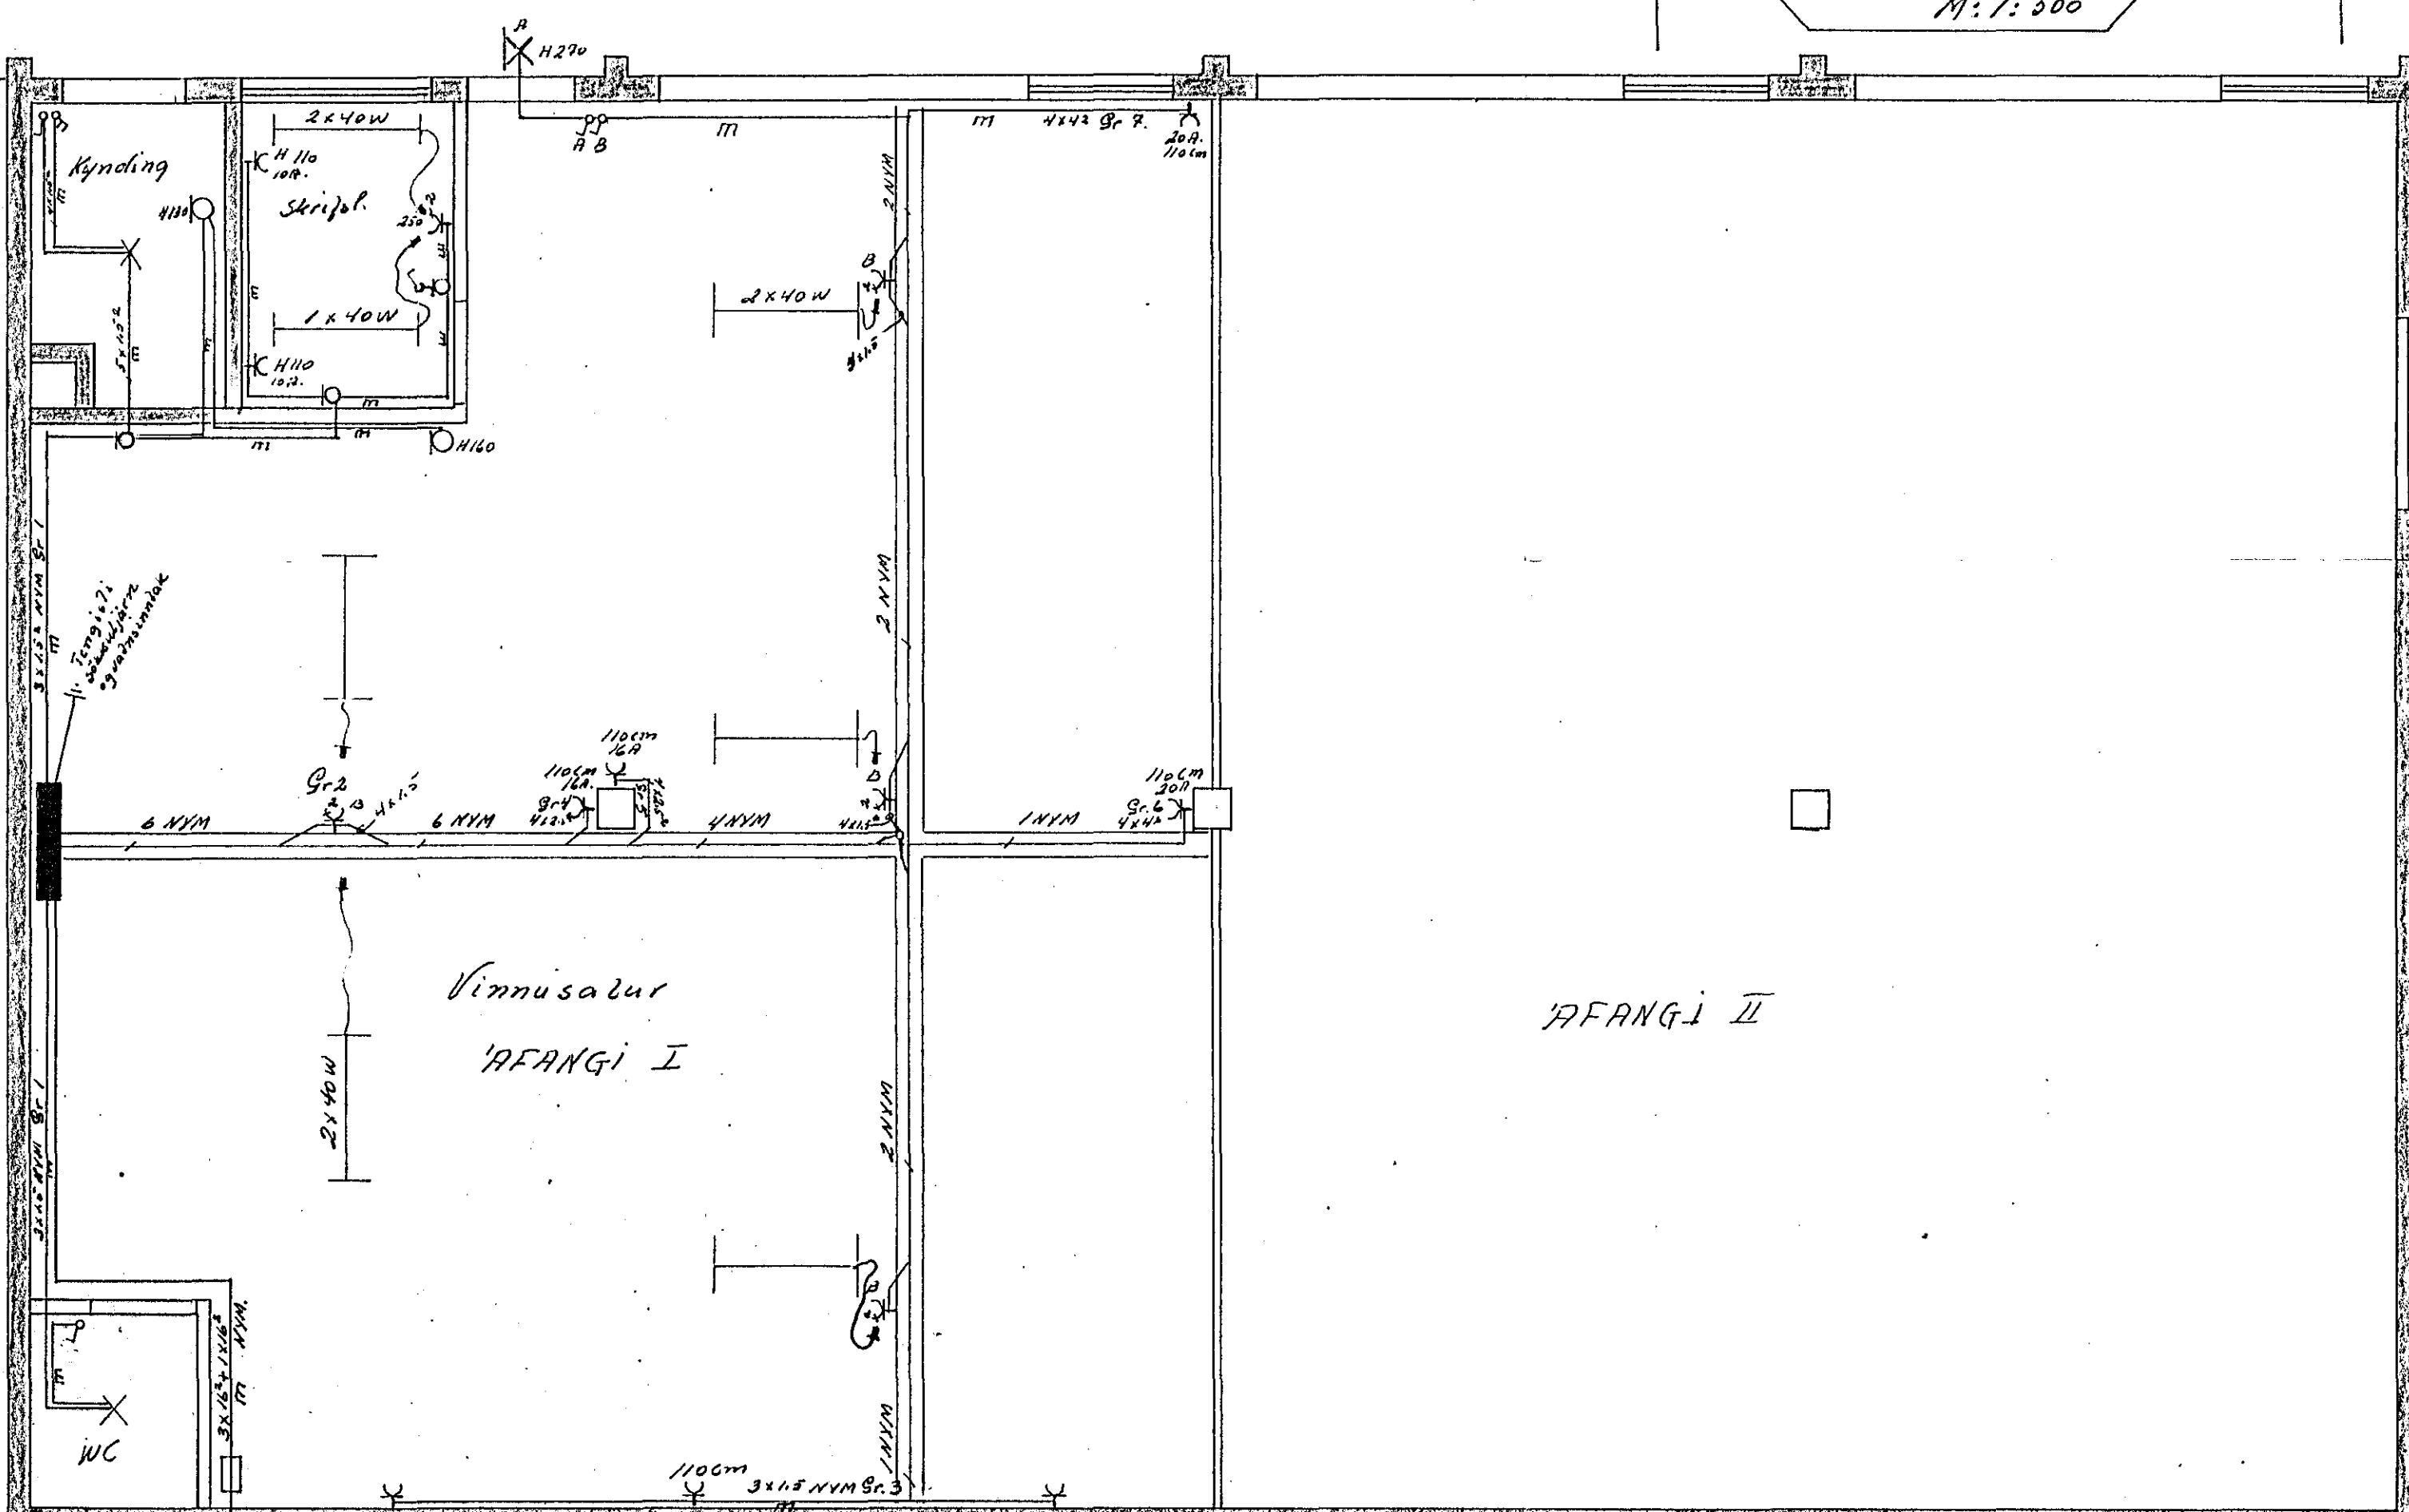

Breytingar	Jens Evarsson s. 52829.
NR	Dag Þr. Vika
	HIE TJE S.
	M. 1:50; 1:100
	NR
	BL. 1 of 1
	Nov 1972
	JE