


MESTA ÁLAG A GRUNNI 3000/cm<sup>2</sup>  
 UNDRISTABA ER GLÖPP.  
 STEIPA S160  
 STÁL KS40

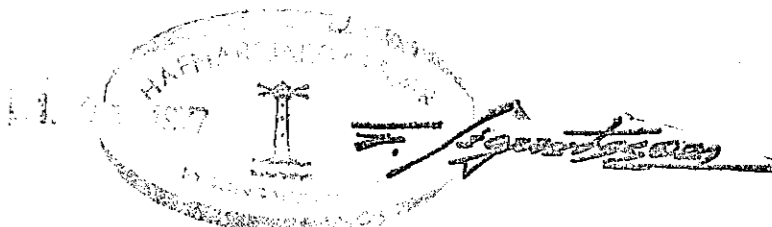

		DALSHÉAUN 13. 2AÞANGI	
20%		HAFNARFIRDI	
BR. DAGS		UNDRISTÖÐUB	
BREYTING			
TÆKNIPJÓUSTAN SF		LIANNAD 30	KVARDI 150 120
ARMÓLA 1 - REYKJAVÍK - Sími 83844		30/alt	DACS. 28-4 '77
TEIKNAD		YEIRFARID	NR.
Bláa		BL. AF. 1	