
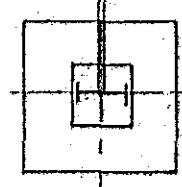
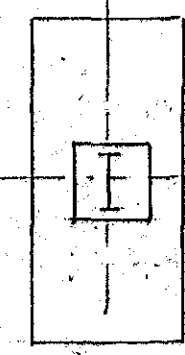
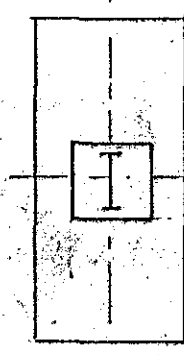
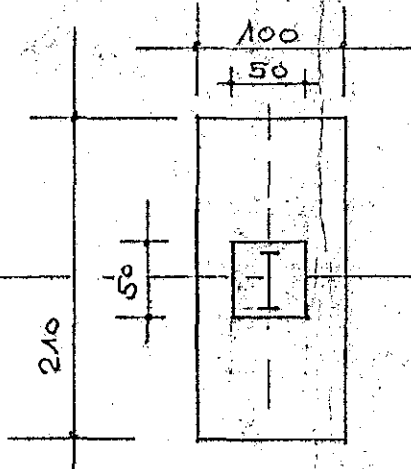
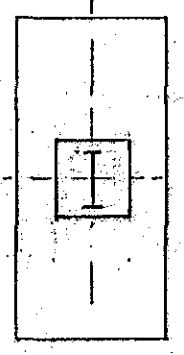
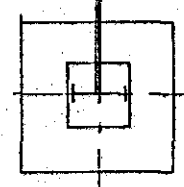
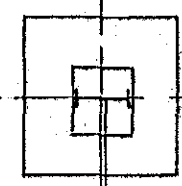
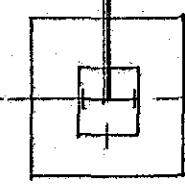
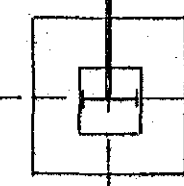
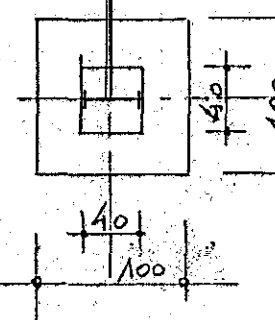
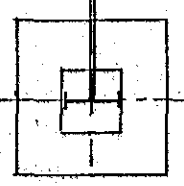


DMARK

SPORBREIDD KRANA (2800)  
MÆLT Á MIÐJU HJÓLA

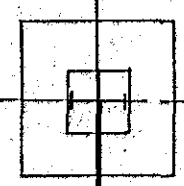

450

450

450

3 x 450

450

2

3

4

5

6  
7  
8

9



12/8	STÆKKADAR UNDIRST	JB
DAGS.	BREYTING	GJORT
HANNAÐ JB	JÓN BERGSSON DIPL. ING.	VERKFR. M.V.F.I.
TEIKNAD JB	GLERBORG	BLAD. 2
YFIRFARID JB	KRANABRAUT	
SAMÞYKKT	M=1:50	DAGS. MAI 1978