


TEKNI NR	VERK	MÆLIKVARDI	1:50	7405	1.2A
DAGS	Víðfarð:	Hannað:	Teknað:	Samb:	Júlí '78
DALSHRAUN 9 B			PLATA YFIR I. HÆÐ		
JÓHANN GUNNAR BERGÞORSSON VERKFR. MAFI			BREYTT		
STRANDGÖTU 11 - HAFNARFIRÐI - Sími 63315					

SNID A 1:20

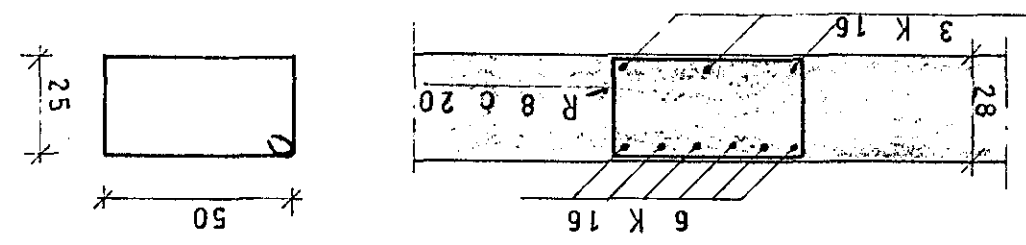

3. ág. 1978
 HAFNARFJÁRDARBERG
 3. ág. 1978
 KEMUR Í STAD TEKNI NR. 1.2A
 EB, '78

