


SNÍÐ 5-5 ~ 1:20

STEIPA:
S > 250
VS ≤ 0.5
LOFT ≥ 6 %
SEMENT ≥ 300 KG/M ³


SKÝRINGAR:

ALMENNAR SKÝRINGAR SJÁ BL. NR. 1-01.

GRUNNMÝND ~ 1:50

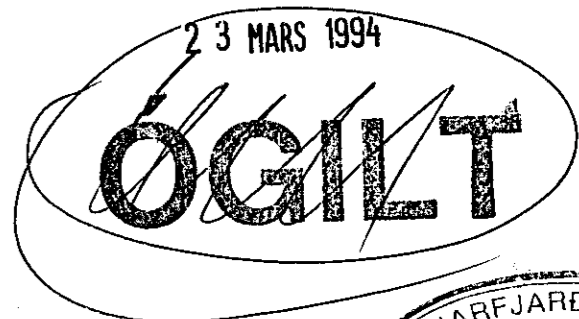

*Sjá brýtta
leikn.*

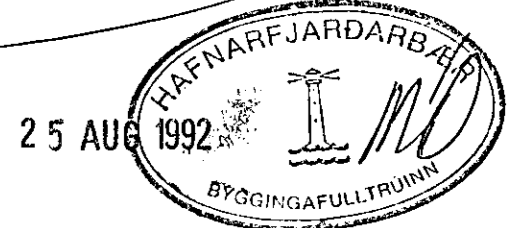

BR. NR.	DAGS	EDLI BREVINGAR	SIEN.
		EYKARHOLT 16 HAFNARFIRDI	DAGS AGÚST '92
		JÁRNDENDING PLOTTU Á SÖRKLUM.	HANNA
			TEIKNAR
			VERK NR. 0218
MELIKV. 1:50		SIGURÐUR ÞORLEIFSSON	BLAD NR.
		TEKNIFRÉDINGUR F.T.F.I.	1-03
		STRANDGÖTU 11 HAFNARFIRDI SÍMI 54751/54255	