




ÚTLOFTUN 2 STK p32 +
1 STK p40 FEM RÖR
Í HNEÐT SPERRURIL

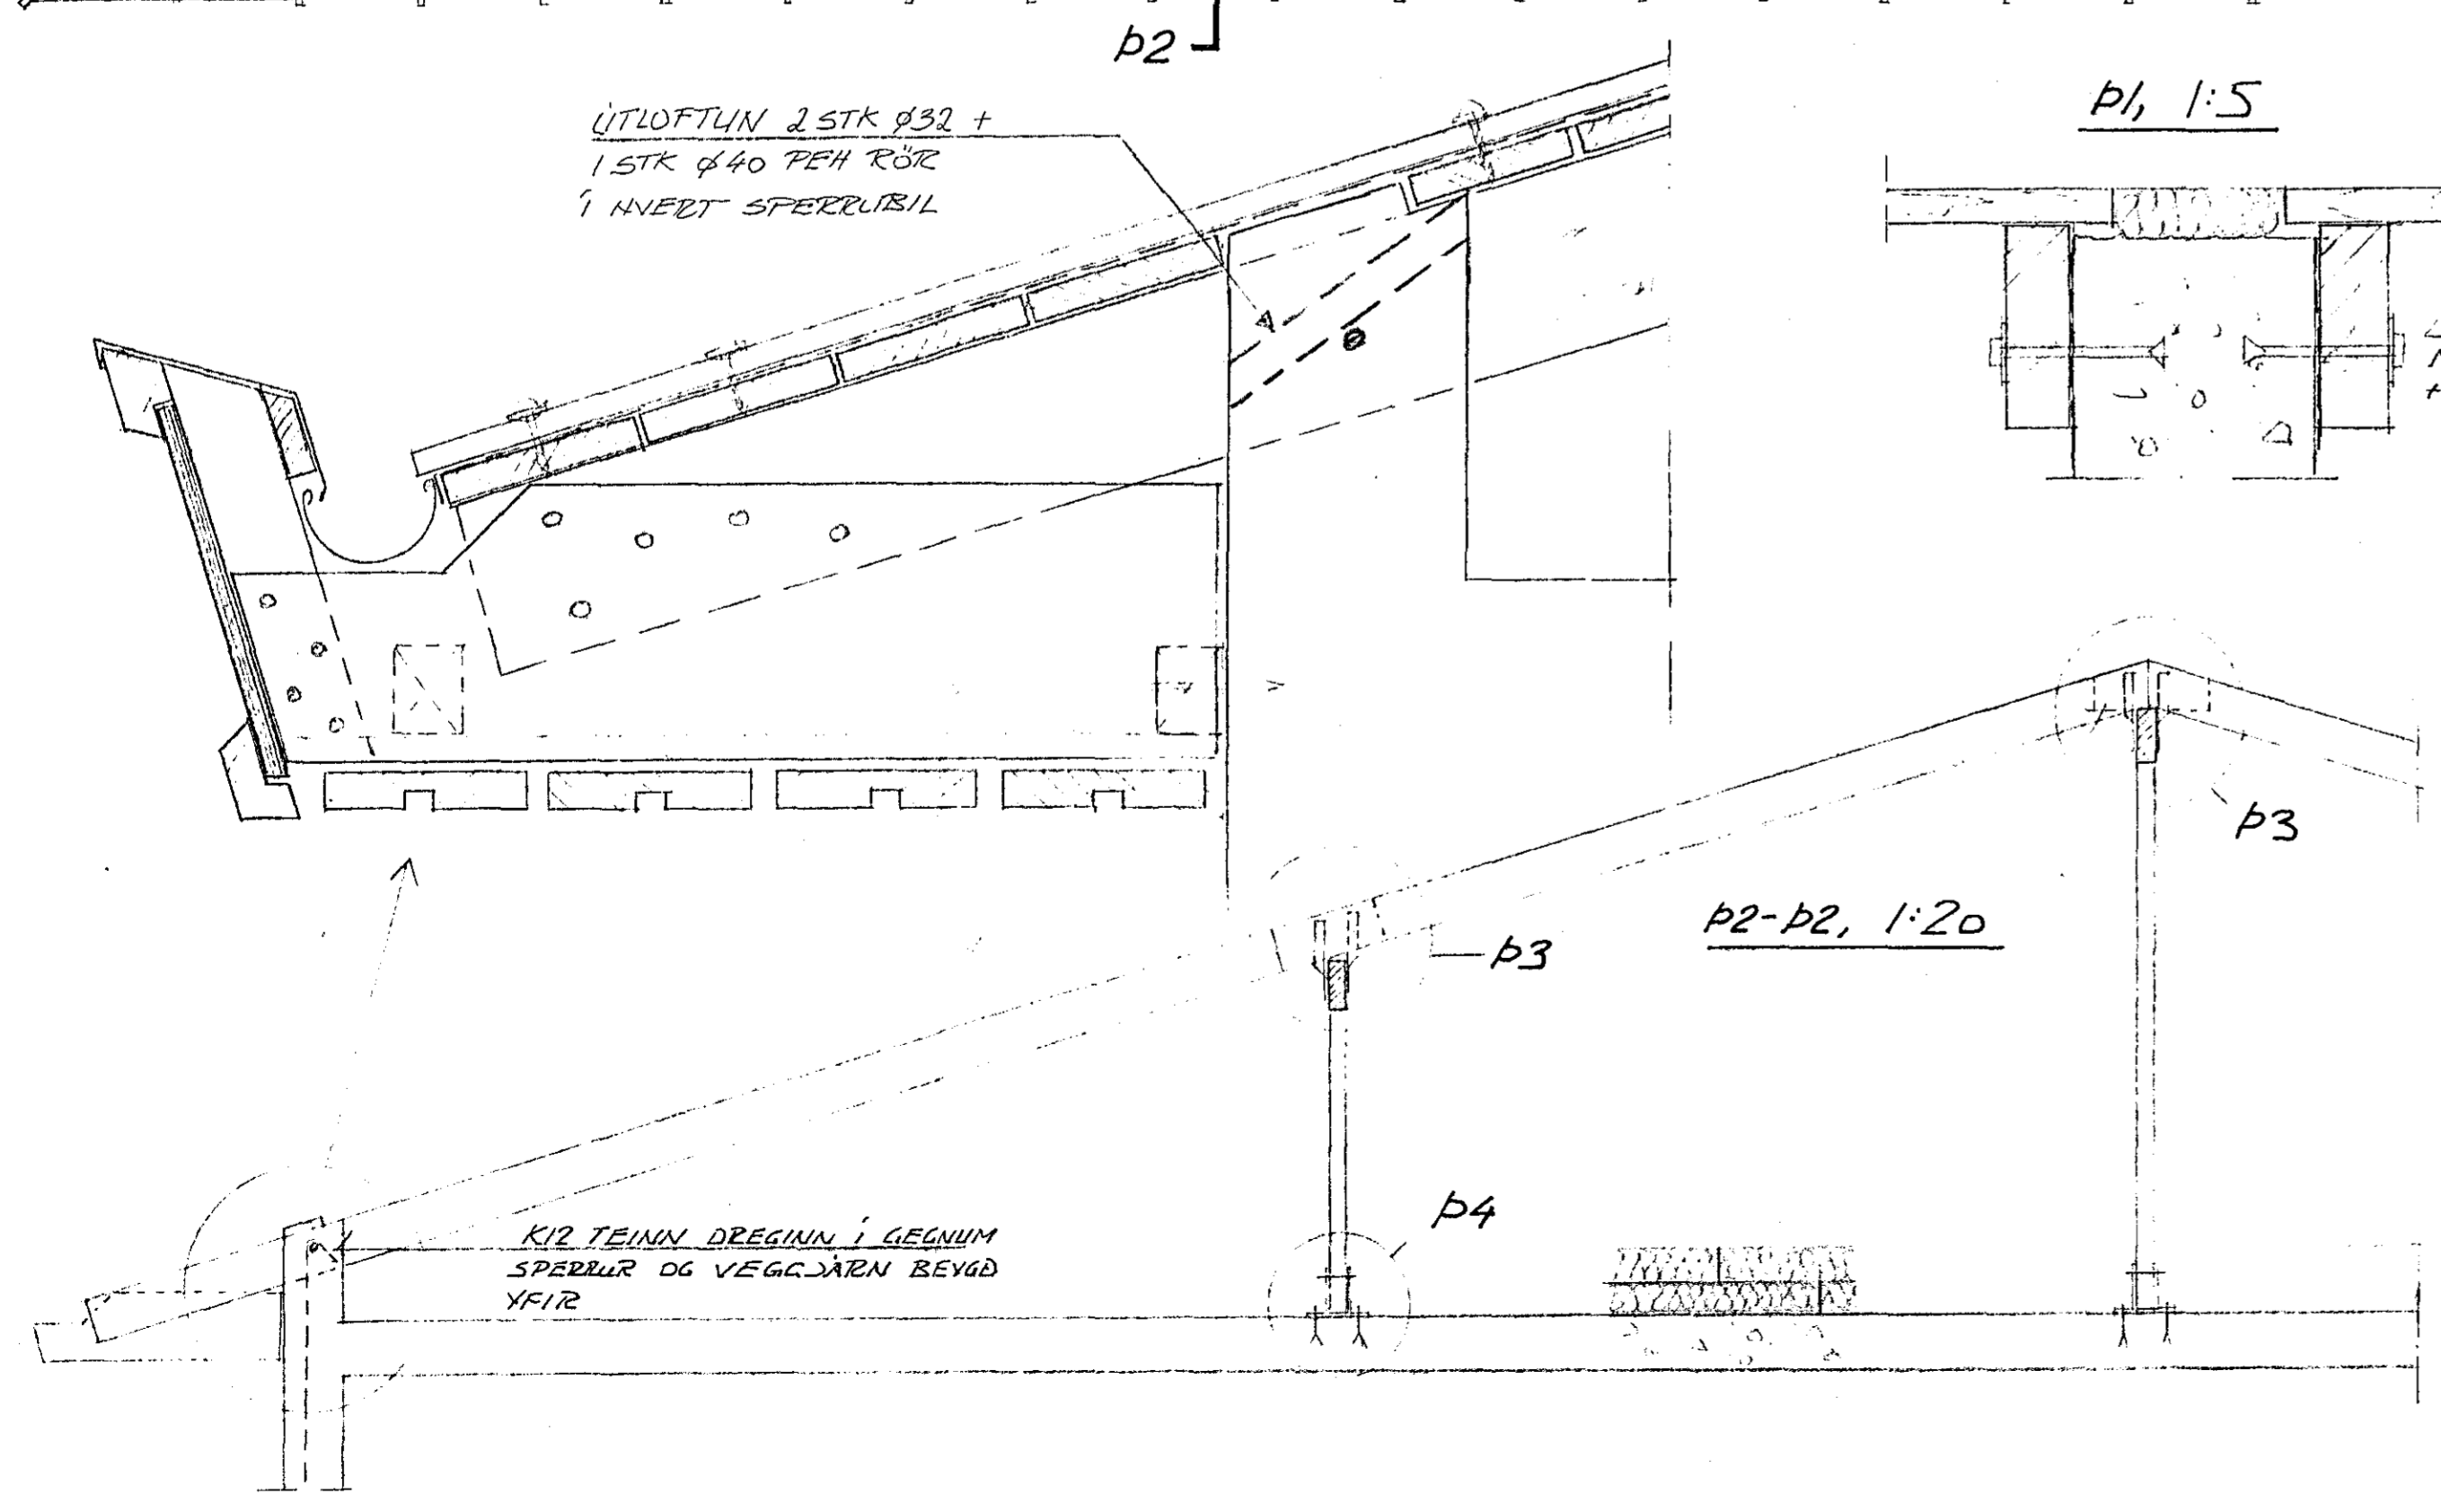


KIÐ TEIÐN DREGIÐN Í GEGNUM
SPERRUR OG VEGGJARN BEYÐ
YFIR

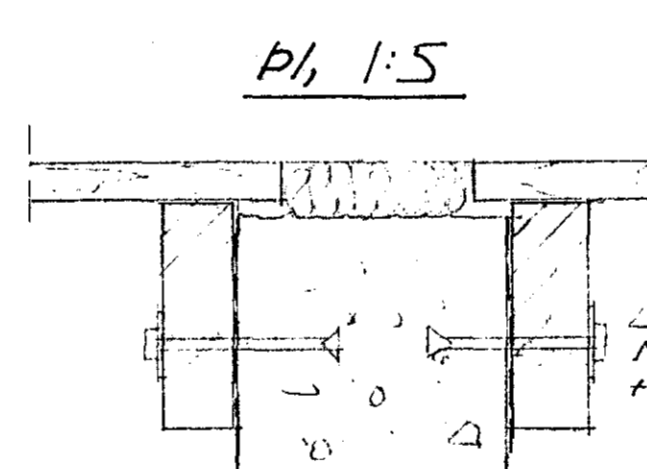

p1, 1:5

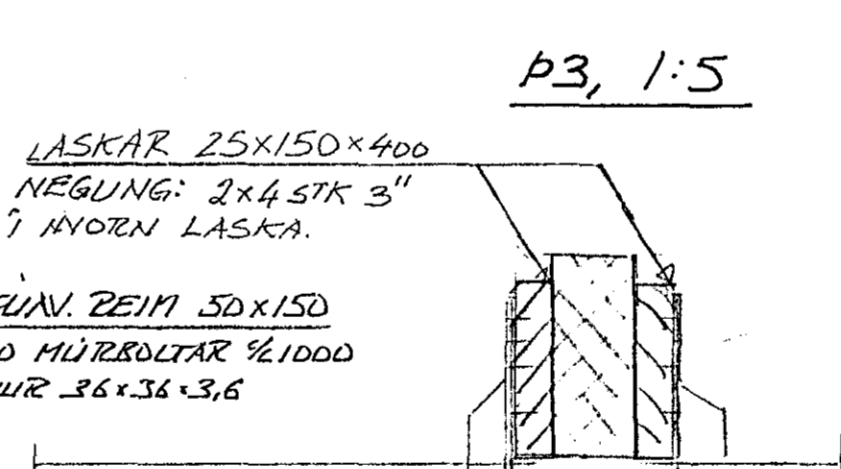

p3, 1:5

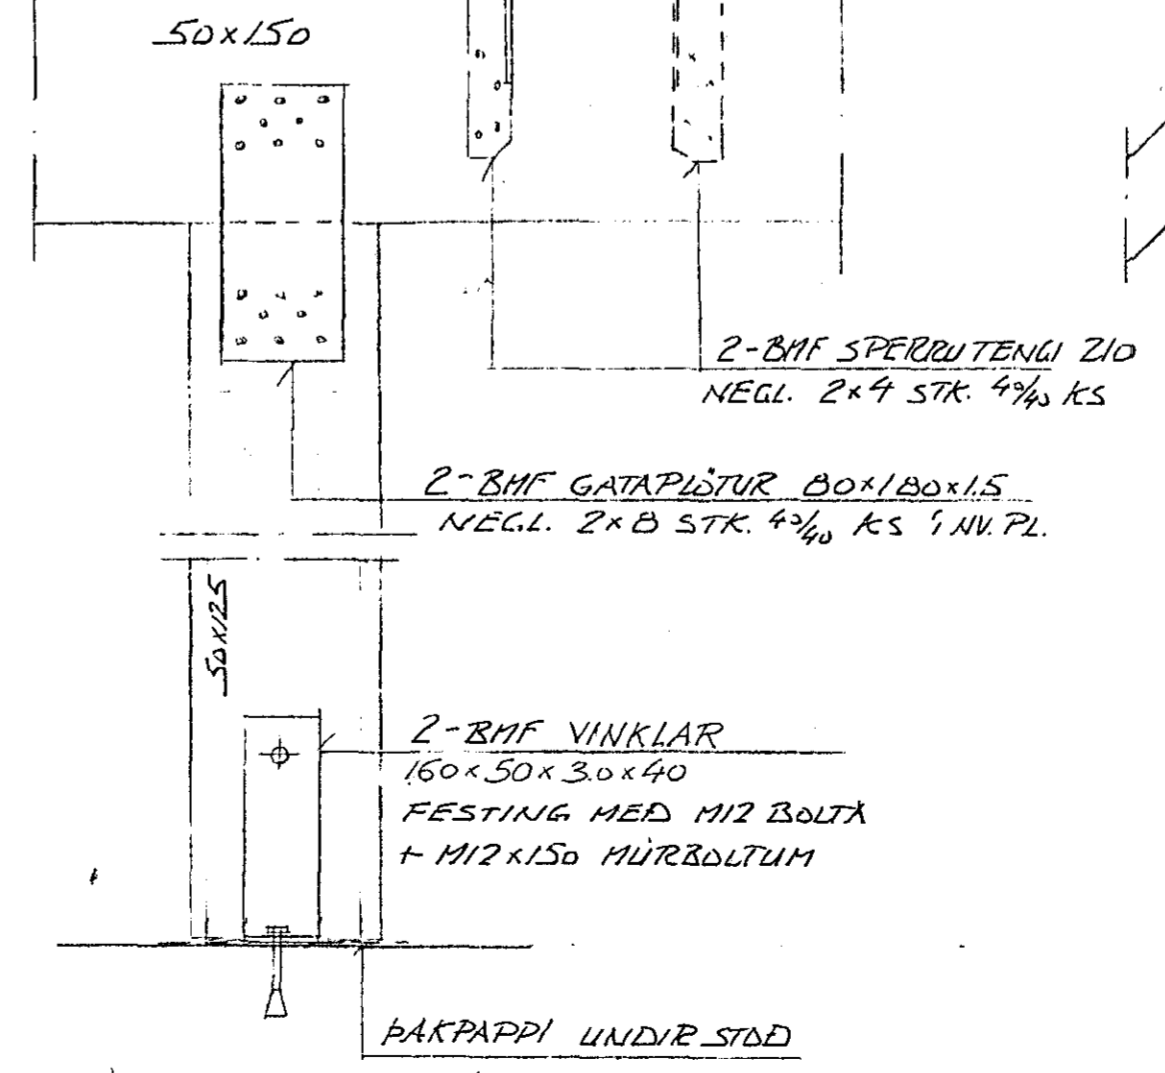


p4, 1:5



FESTING MED BMF-TUGBANDI 25x20
NEGL. 6x2+6 STK 4/16 KS, NU BAND

ASKILID, ELDRI
TEIKNING OGILD

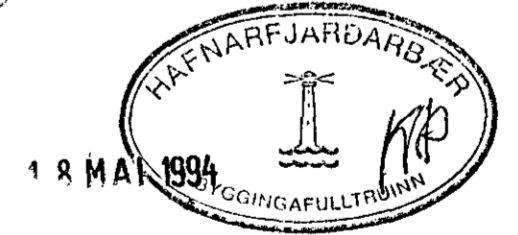

SKYRINGAR:
ALLIR PAKVIRDIR SKULU VERA UR-GALLLAUSU TIMBRI, V-FLOKK
MILLI STEINS OG TIMBURS SKAL LEGGJA ASFALTPAPPA.
ÞAKKLÆÐNING SE UR 25 MM BORDUM OG NEGLIST HVERT
BORD MED 3 STK. 3" SAUMI Í HVERJA SPERRU.
ALLUR SAUMUR Í BMF - FESTINGAR SKAL VERA GALV.
BMF - KAMBSAUMUR.
OTLOFTUN ÞAKS > 500 MM²/M², SJÁ SÉRYMND.
ÖLL MÁL ERU Í MM.

BREYTT Í MAI 1994 - JLS

FORSJÁ VERKEFNIÐSTOFA FRV <small>SKOGLAORUÐSTOÐ & REKJAVIK SMÍÐ 240001 24710 KENNIT. 080208-2489</small>	DVERGHOLT 5,7 OG 9. HF.	
	PAKVIRKI GRUNNMYND AF 5 OG 7. SÉRYMNDIR GILDA FYRIR 5,7 OG 9.	
JBS JBS DAGS OKT '91 M 1:50 1:5	SAMM. <i>Jón Þ. Stefánsson</i> TEKNA NR. 1.05	

BREYTT Í MAI 1994 - JLS