




ÞAKVIRKI NÝBYGGINGAR 1:50

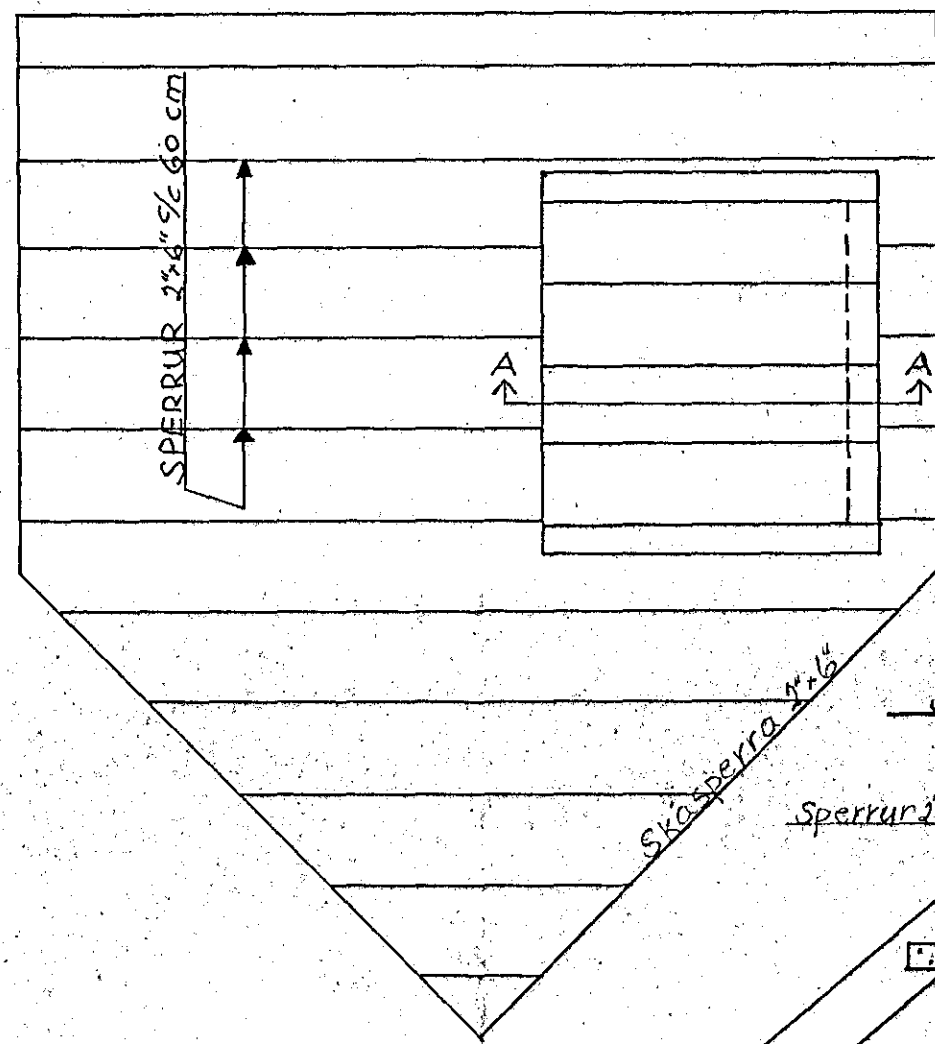


SNID B-B 1:20

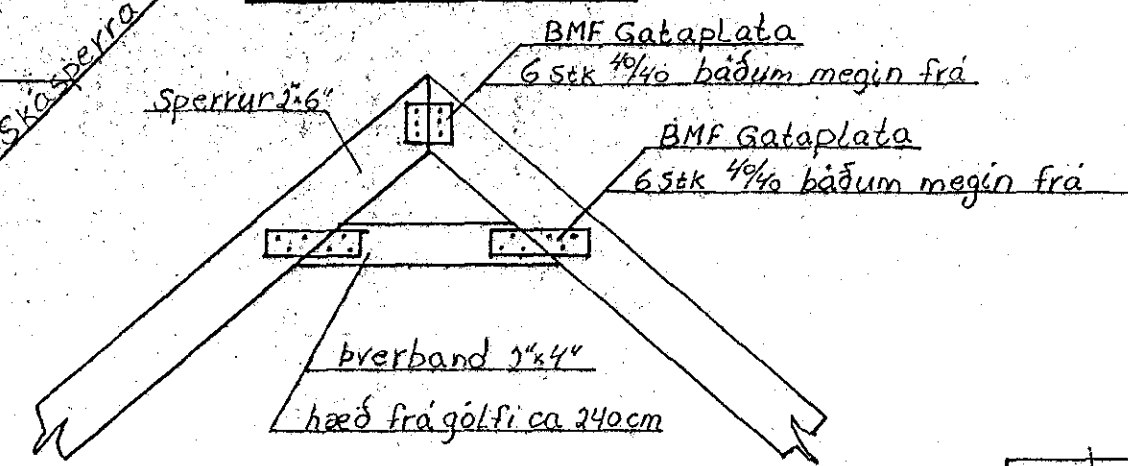


SNID A-A 1:20

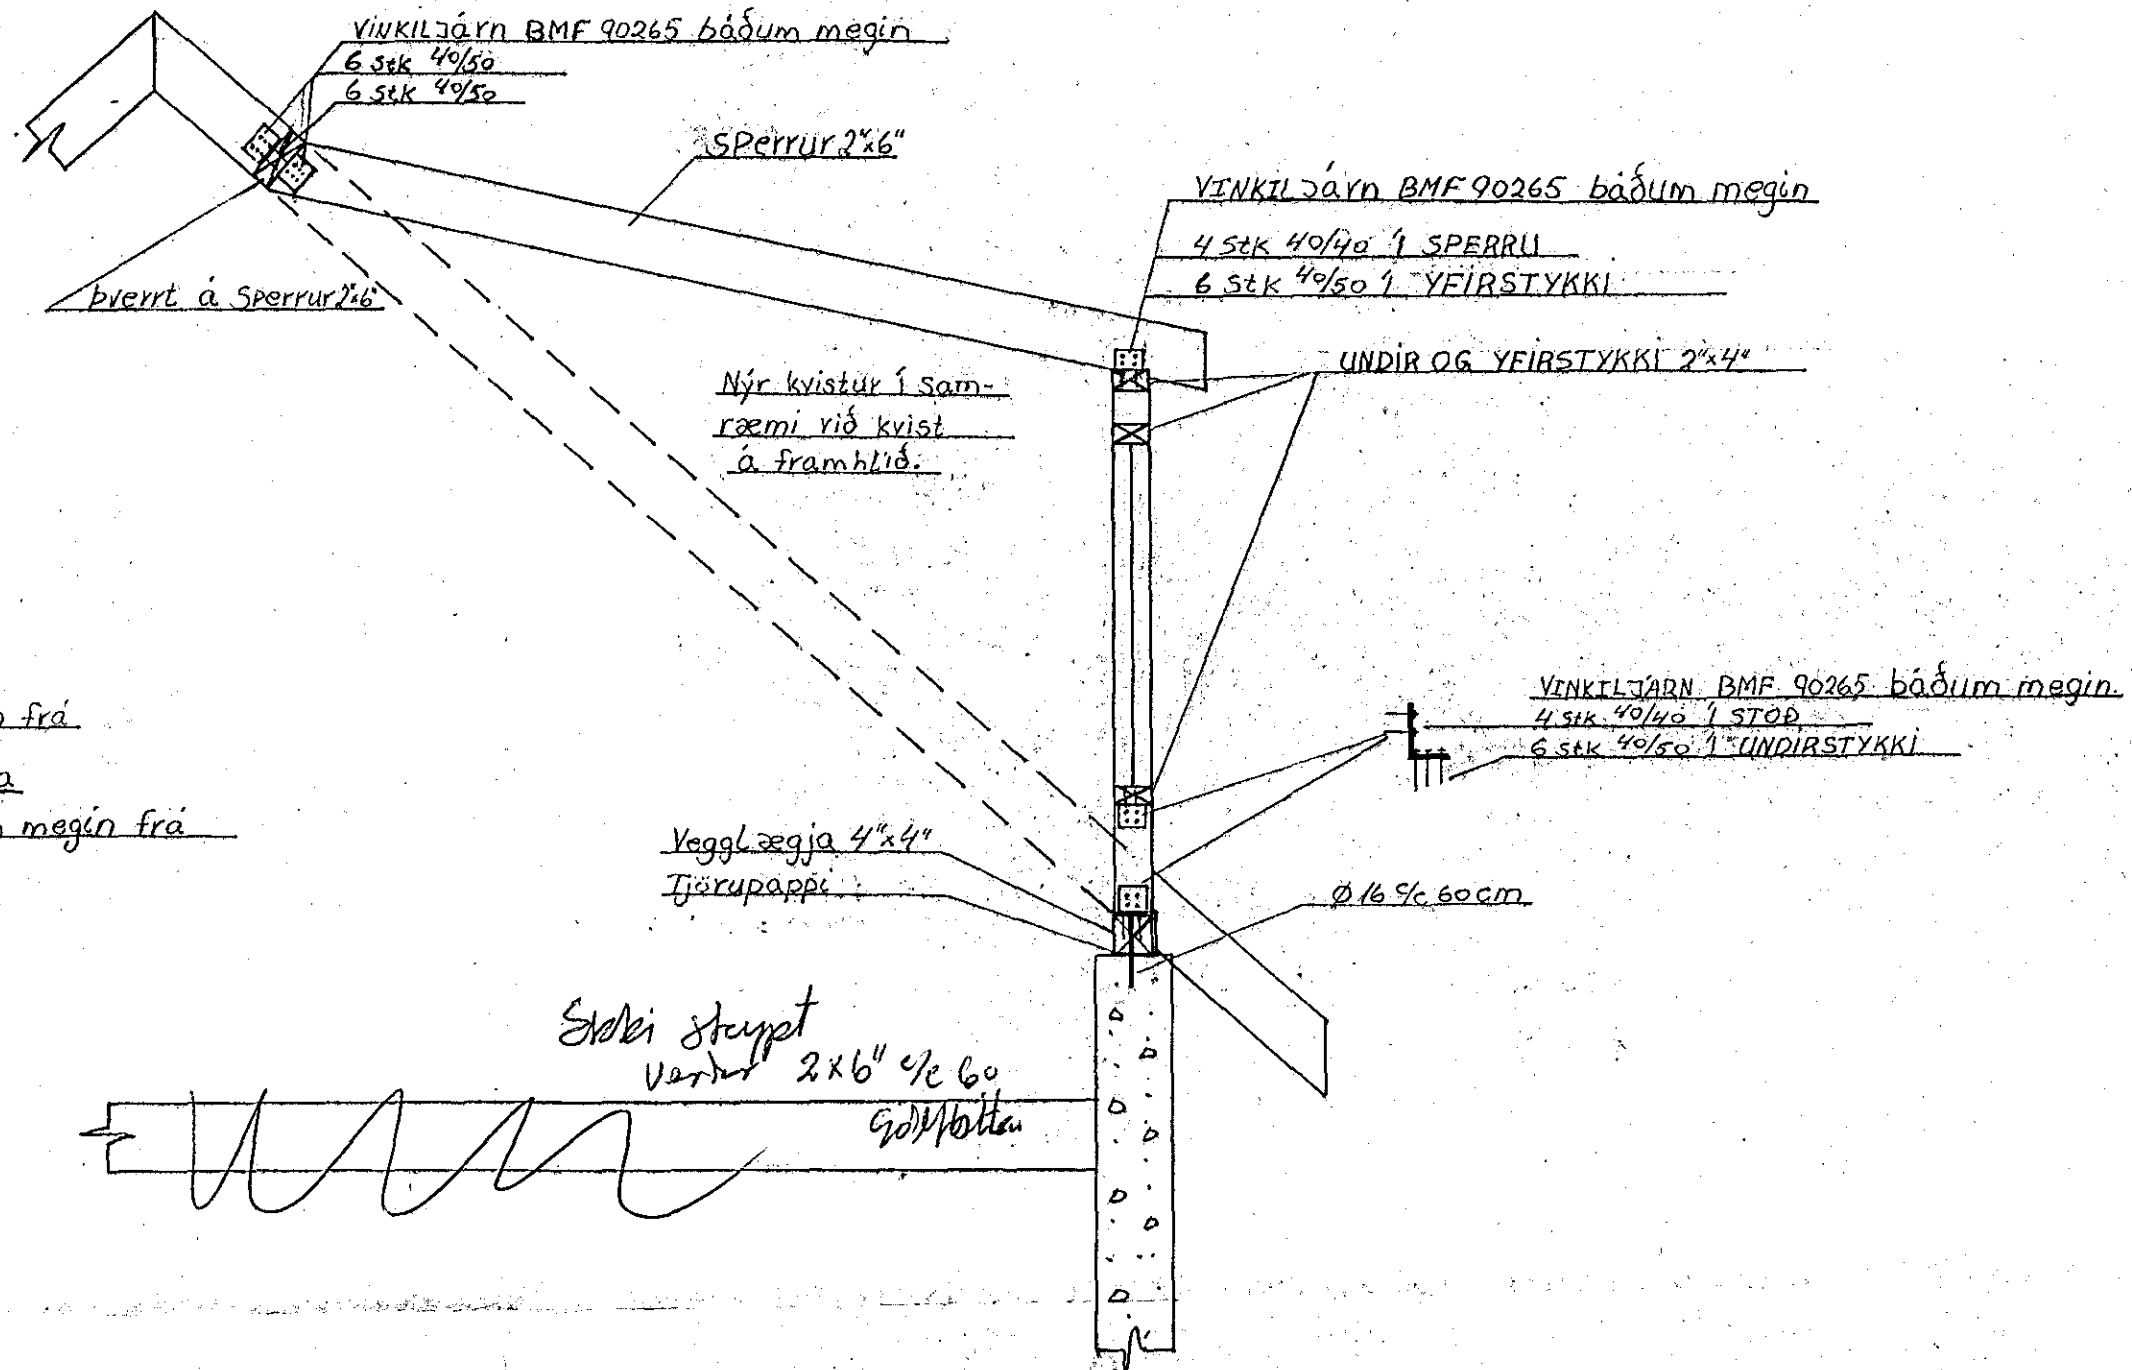

HLIDARMYND
BURÐARVIRKI 1:20

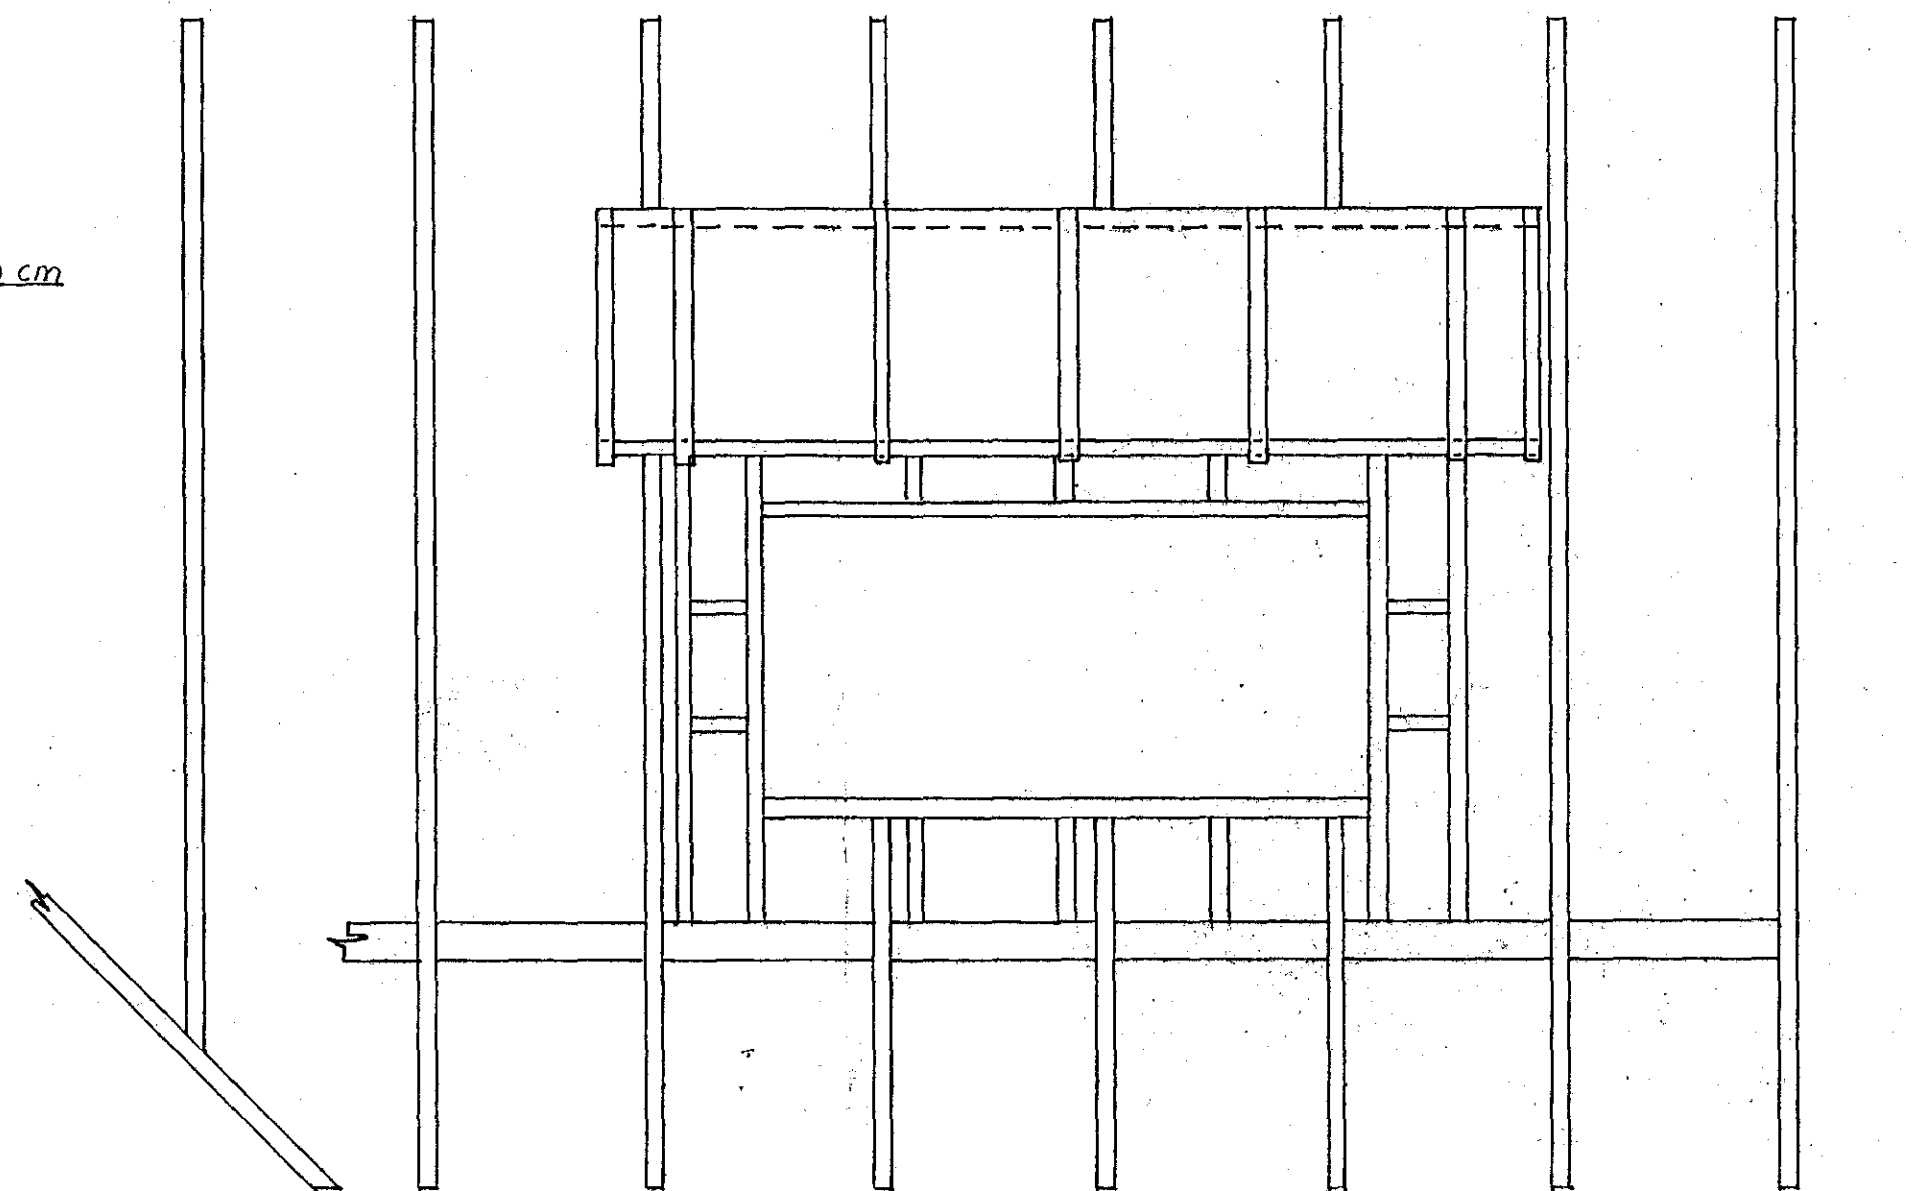

GAFLL NÝBYGGINGAR 1:50

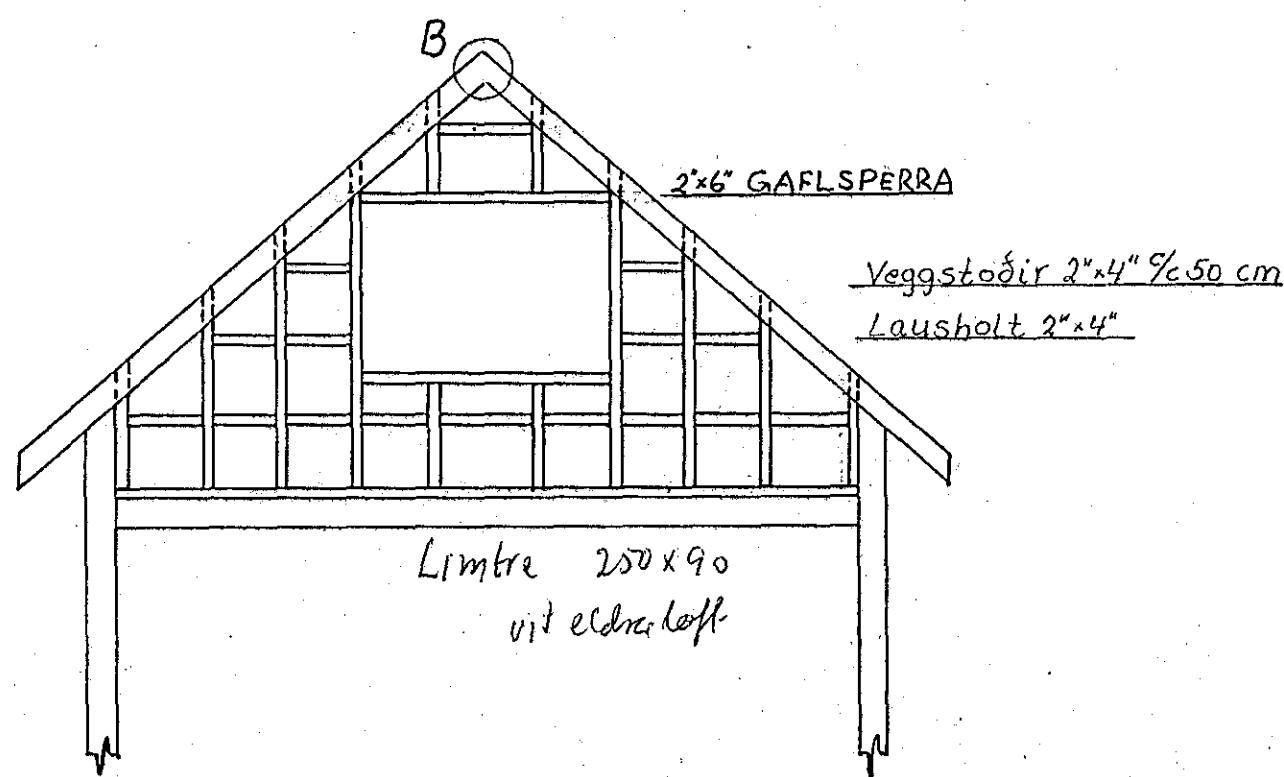

FAGRAKINN 16 HAFNARFIRÐI	VERK	BL. NR
		A.1.
VIÐBYGGING ÞAKVIRKI, GAFLL, SNID Í KVIST, BURÐARVIRKI.	HAFNARF. MAÍ '83 MKV. 1:50 1:20	REIKN S.P. TEIKN S.P.
VERKFRÆÐISTOFA HALLDORS HANNESSONAR REYKJARVÍKURVEGI 60 HAFNARFIRÐI S. 54355		