




A SÉRMYND
276/276 M. 1:20

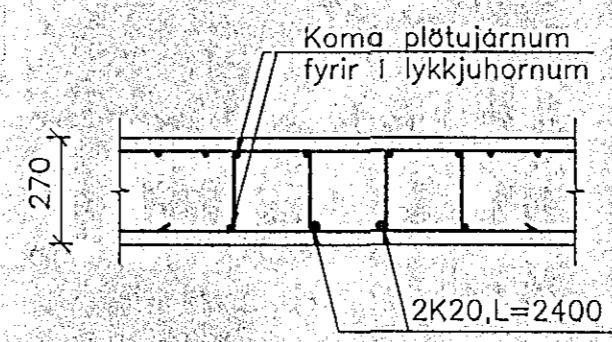


1 SNID
276/276 M. 1:20

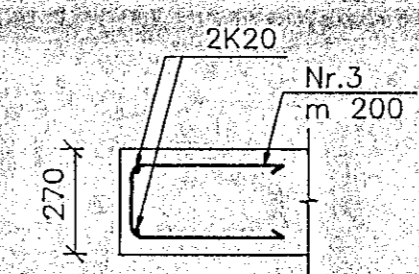


2 SNID
276/276 M. 1:20

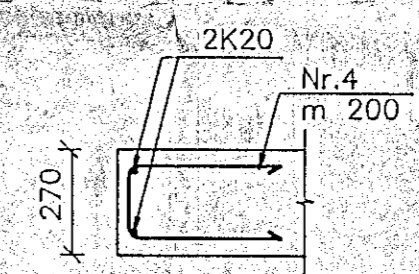

3 SNID
276/276 M. 1:20

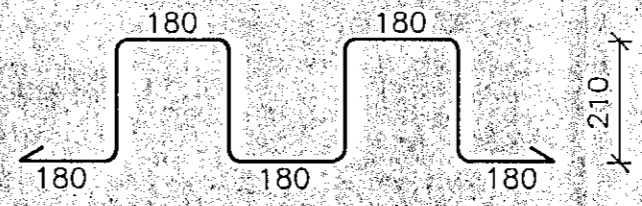


Nr.1
K10 L=1600

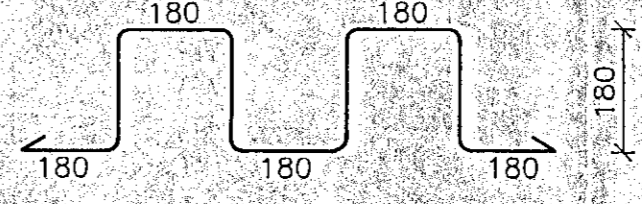

Nr.2
K10 L=1460




Nr.3
K10 L=980

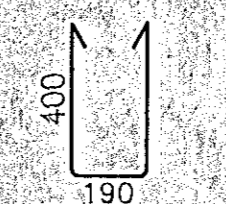



Nr.4
K10 L=960

ÁSKILID, ELDRI
TEIKNING ÓGILD

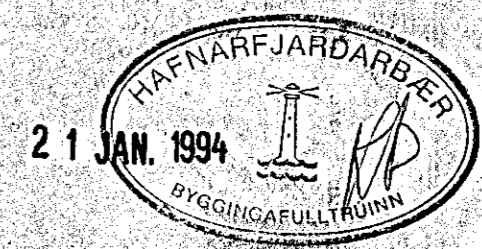

21 JAN. 1994

A Öllum br. og sv. Jarna skilyg betur 12.01.93 L.J.H.
NR FJÖLDI BREYTINGAR DAGS SAMP

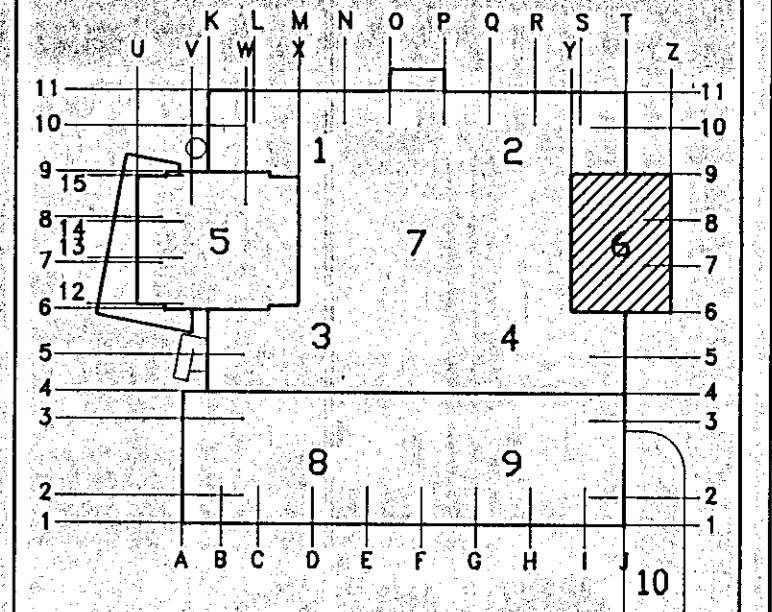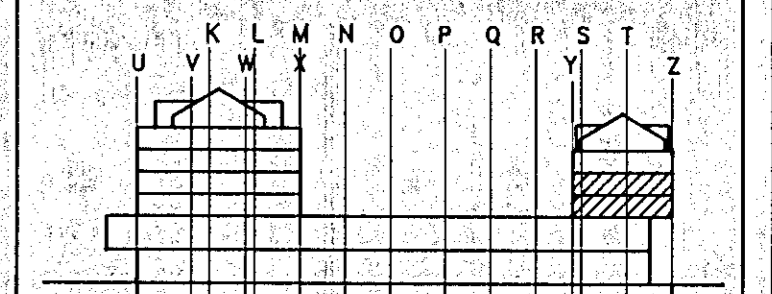

MIDBÆR
HAFNARFJARDAR
FJARDARGATA 13-15

ALMENNA
VERKFRÆDISTOFAN HF
FELLSMÖLA 26 - 108 REYKJAVÍK
SÍMI (91) 678100 FAX (91) 680284

HEITI
BURDARVIRKI
4. HÆD. HLUTI 6. GÓLFPLATA
GRUNNMYND, SNID

MÁL
1:50 / 1:20 / / /

HANNAÐ
TEIKNAB S.J YFIRFARIB. SAMP.

DAGS
01/11/1993

TEIKNING NR.
1032-B-276

BREYTING NR.
A