


ASKILD EYMITI
TEIKNING OGILD

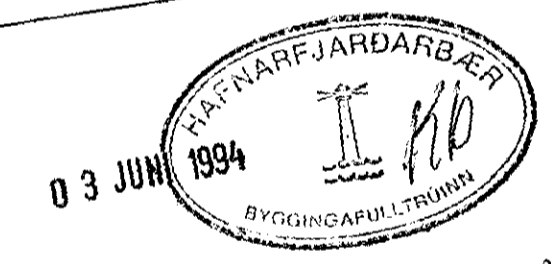

fornubudir 1 hafnarfirði
sperrur SNIDMYND I PAKBRUN
tæknipjónusta sveins karlssonar TFI
bæjarhrauni 2 220 hafnarfjörður

MÁÍ 1994
1:S 1:100 1:500
teikning
B-9.1.3