



Hús Þorsteinssonar
Gardar 7
Hafnarfyrdi

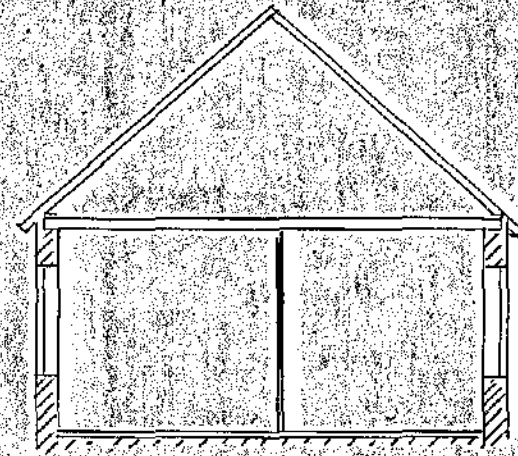


bestur gólf




presstædur

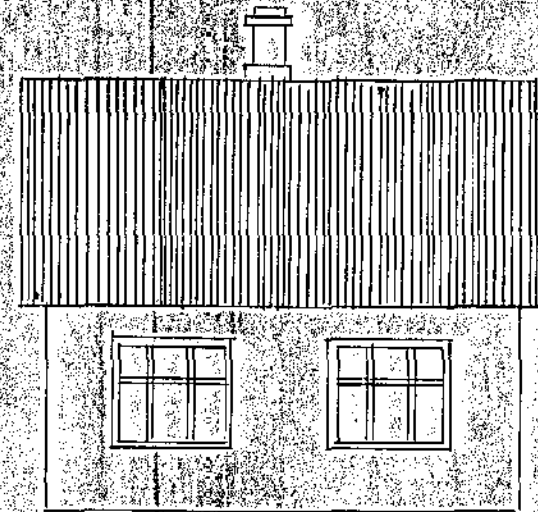

Tranklið

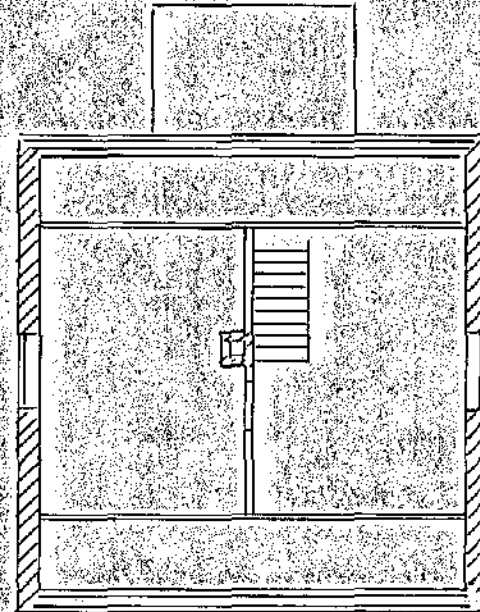

ofan gólf

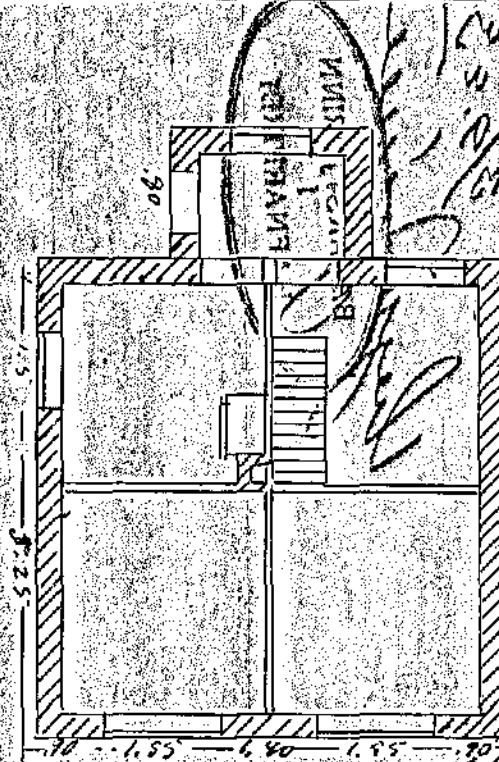

neðan gólf

fram hald fiska vejar

Handwritten notes and signatures in Icelandic, including the name 'M. Th. 110 m.' at the bottom right.