



BREYTT 1 2023.05.15 Reyndart. v. lokaútt. SJ			
HEITI VERKS: HVALEYRARBRAUT 39			
220 HAFNARFJÖRDUR			
HEITI TEYNNINGAR: ADALUPPDRÆTTIR SNEIDINGAR			
DAGS:	2019.12.04	HANNAF: JL_KÁ	YRFR: KÁ
VERKFR: 1696	KVARDI: 1:100	TEYNNAR: LMA	
ALARK		DALVEIG 18 201 KÓPÁVOG SÍM: 534 8000 FAX: 534 8018 KT: 201103-0408 arkitektar ehf.	
JAKOB EMBEL LINDAL ARKITEKT FAL KT: 555667-3228		KRISTJÁN ÁSGERÐSSON ARKITEKT FAL KT: 140956-4205	

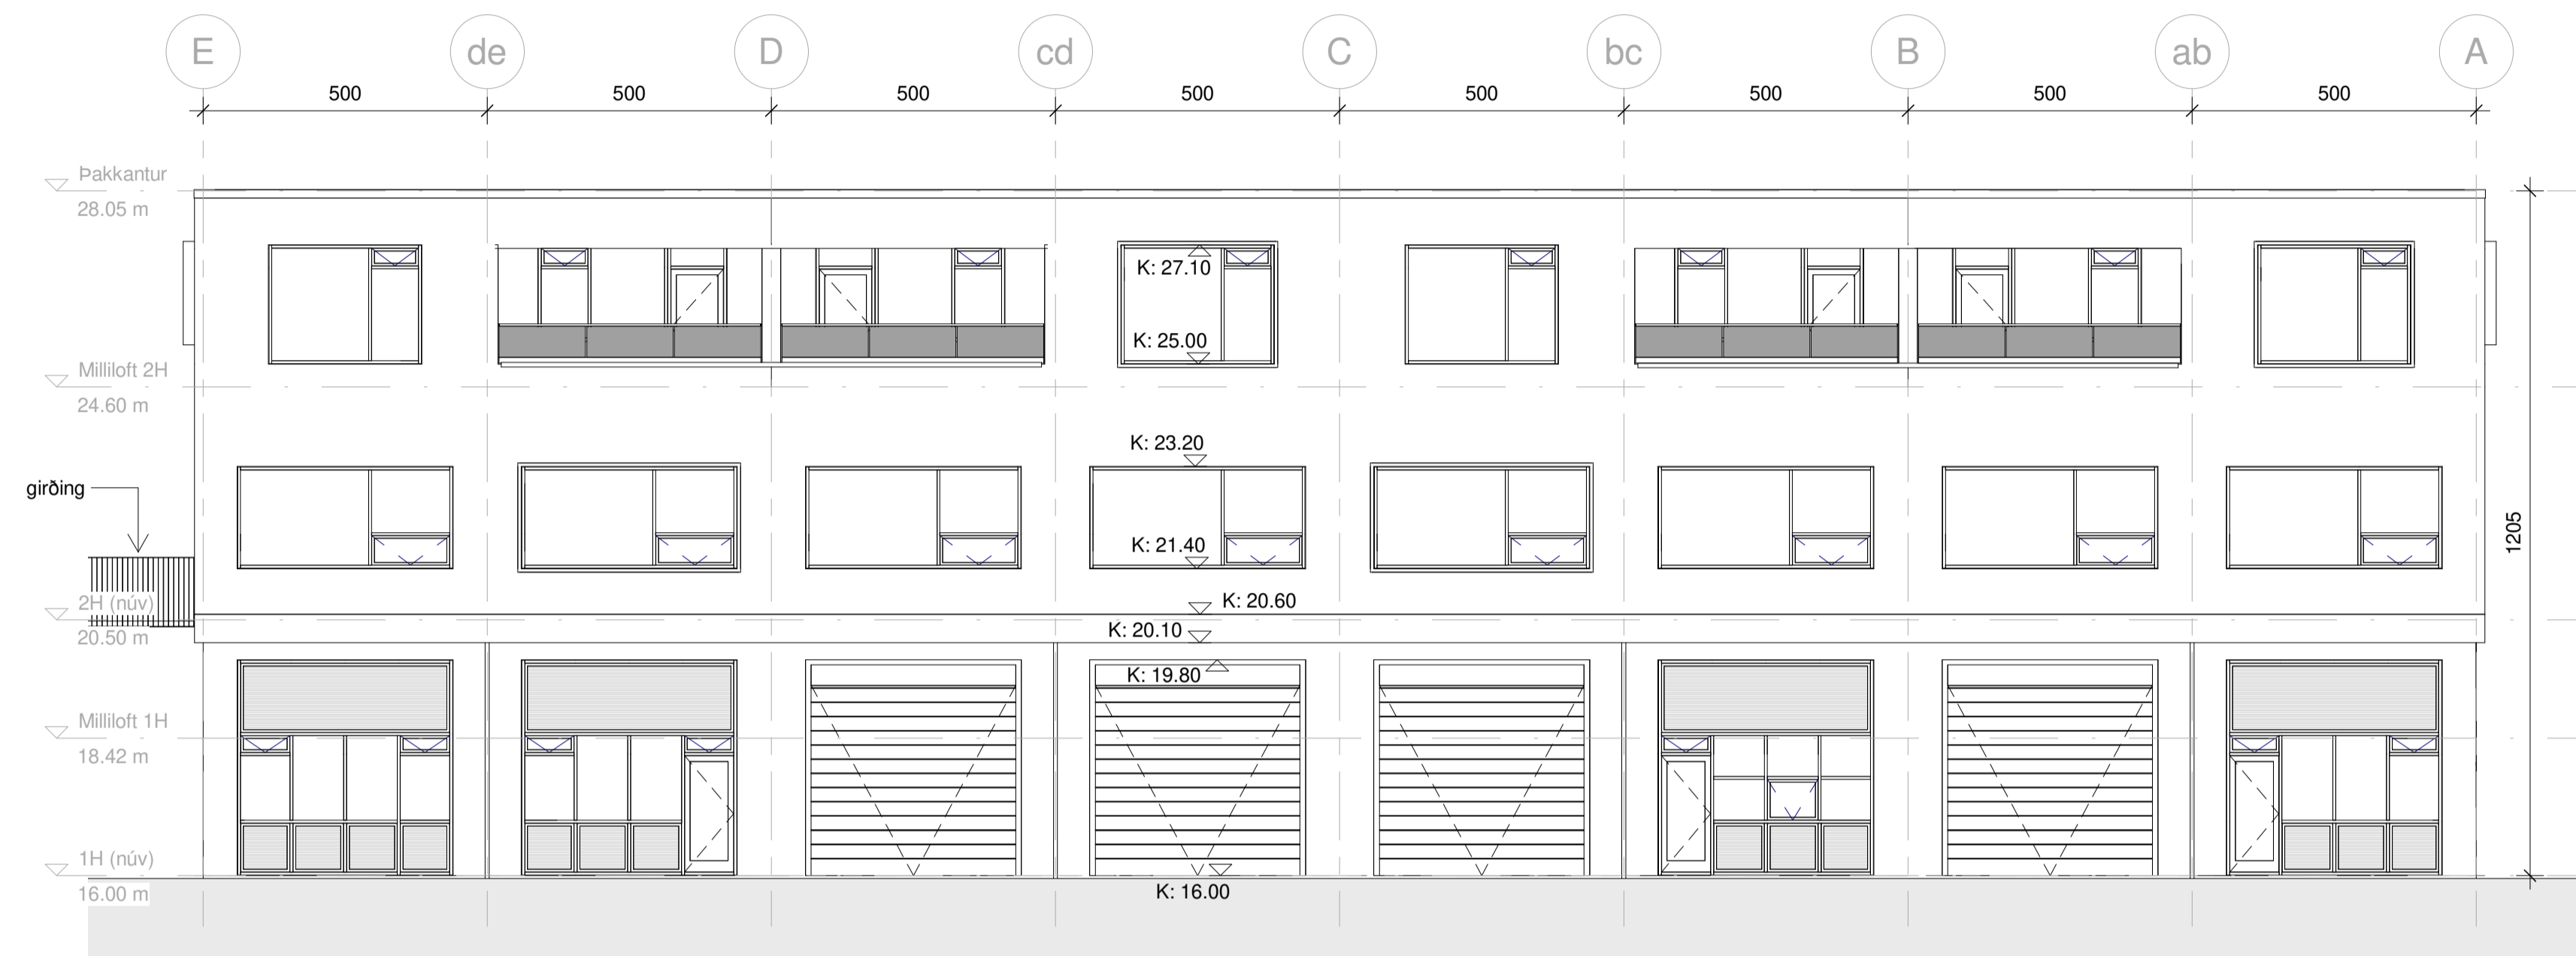


Norður
1 : 100

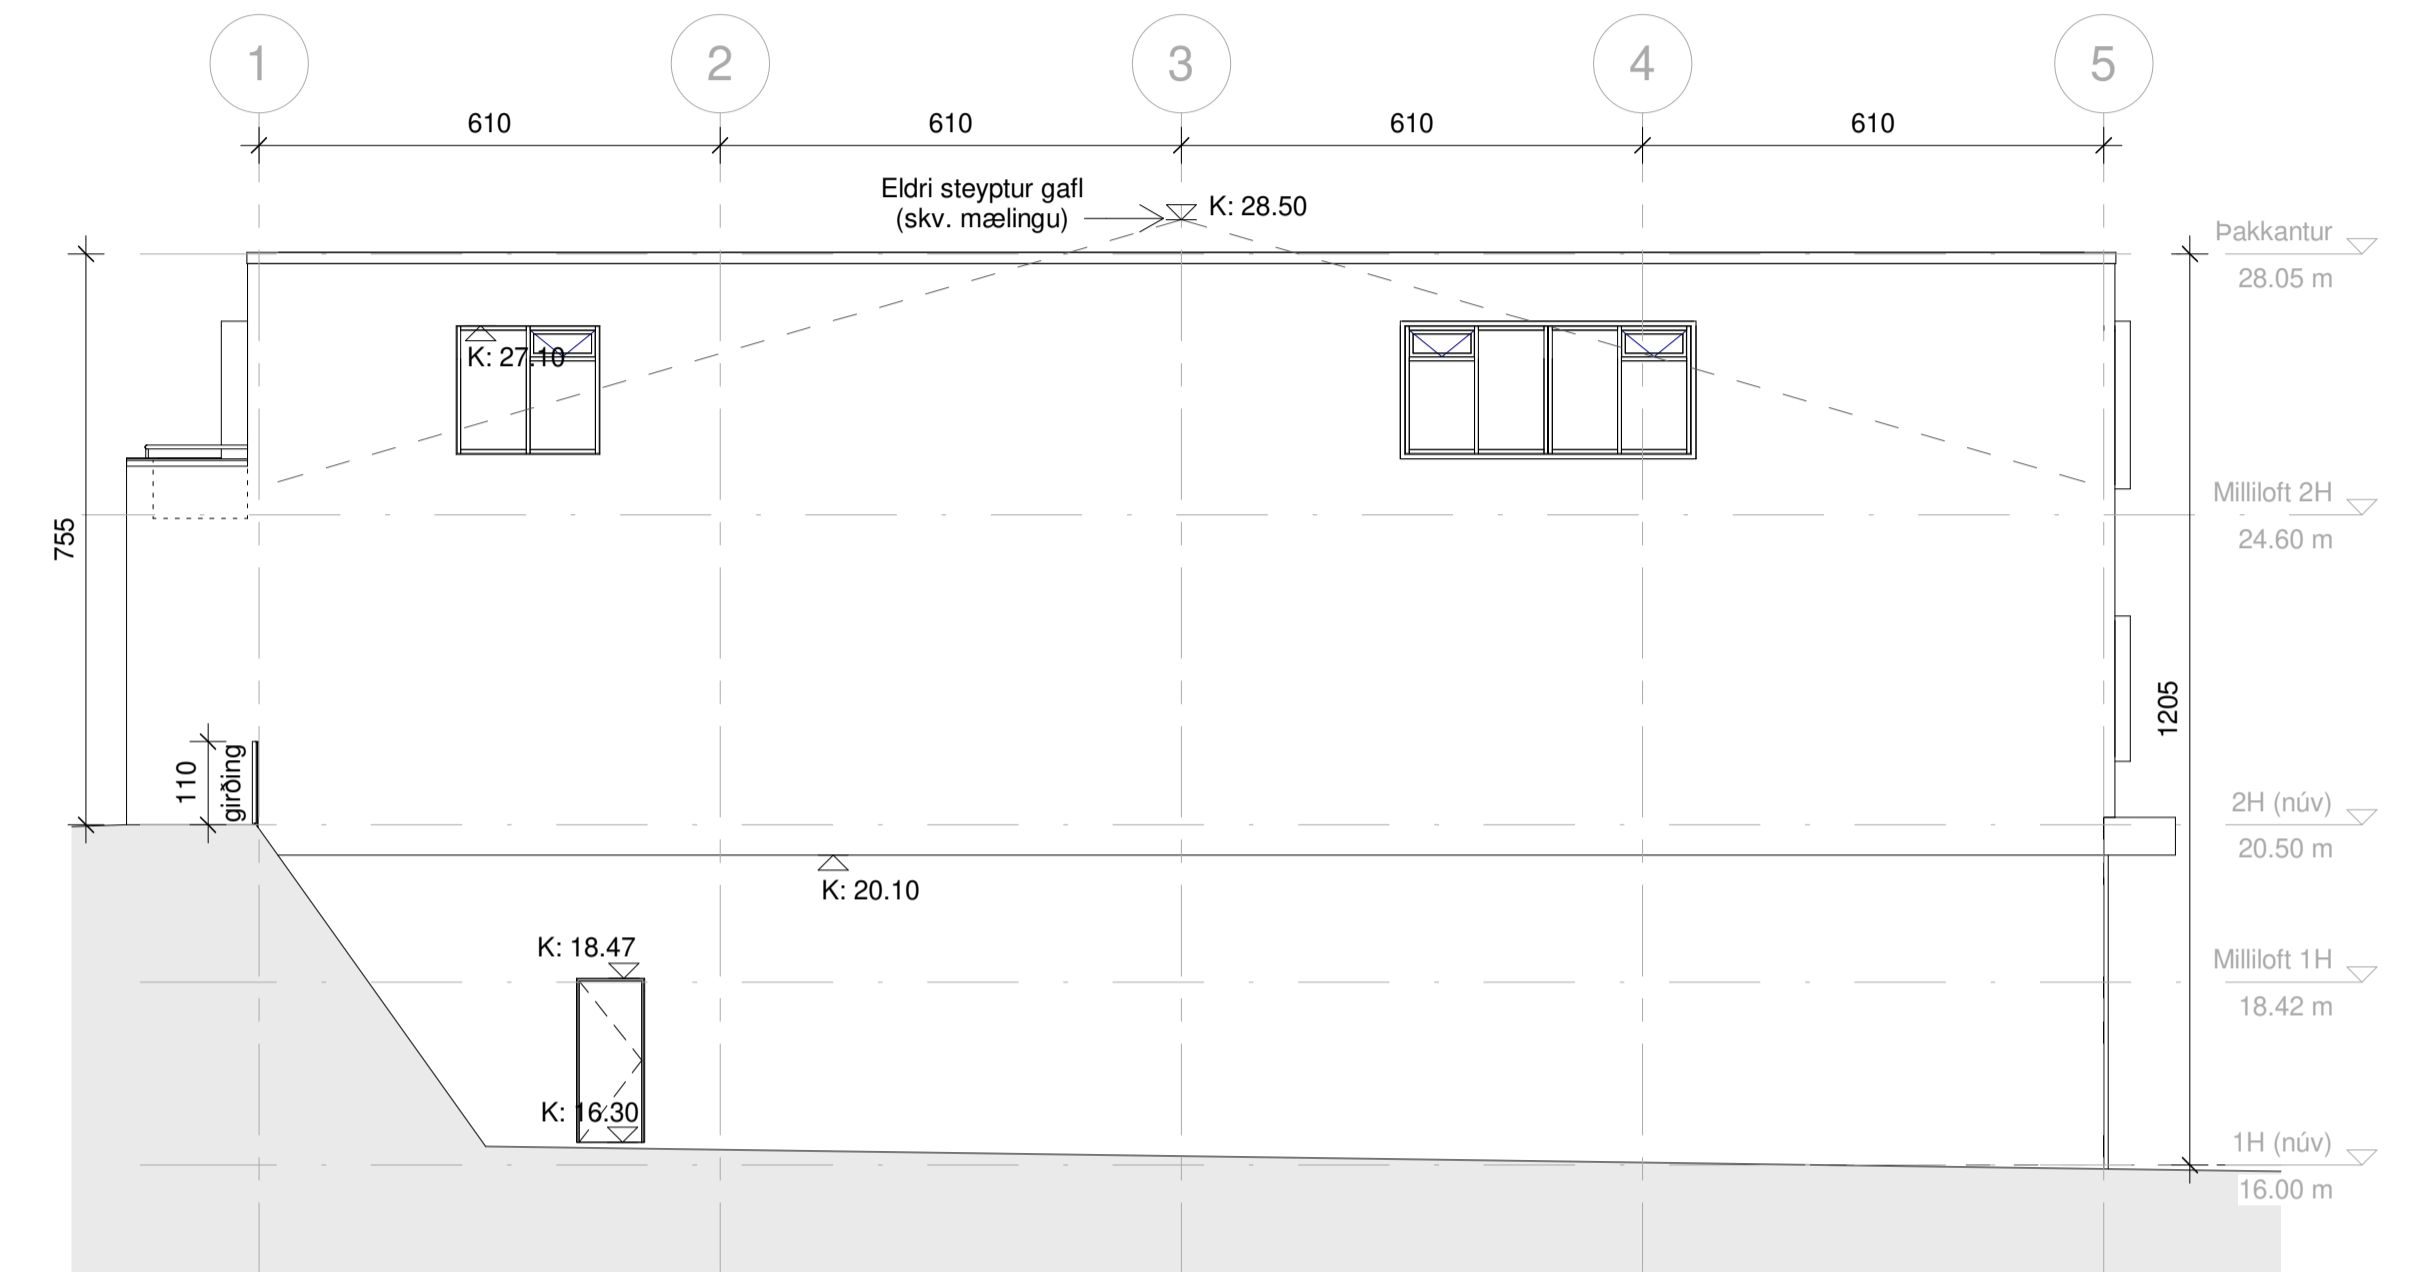


Austur
1 : 100



Suður
1 : 100

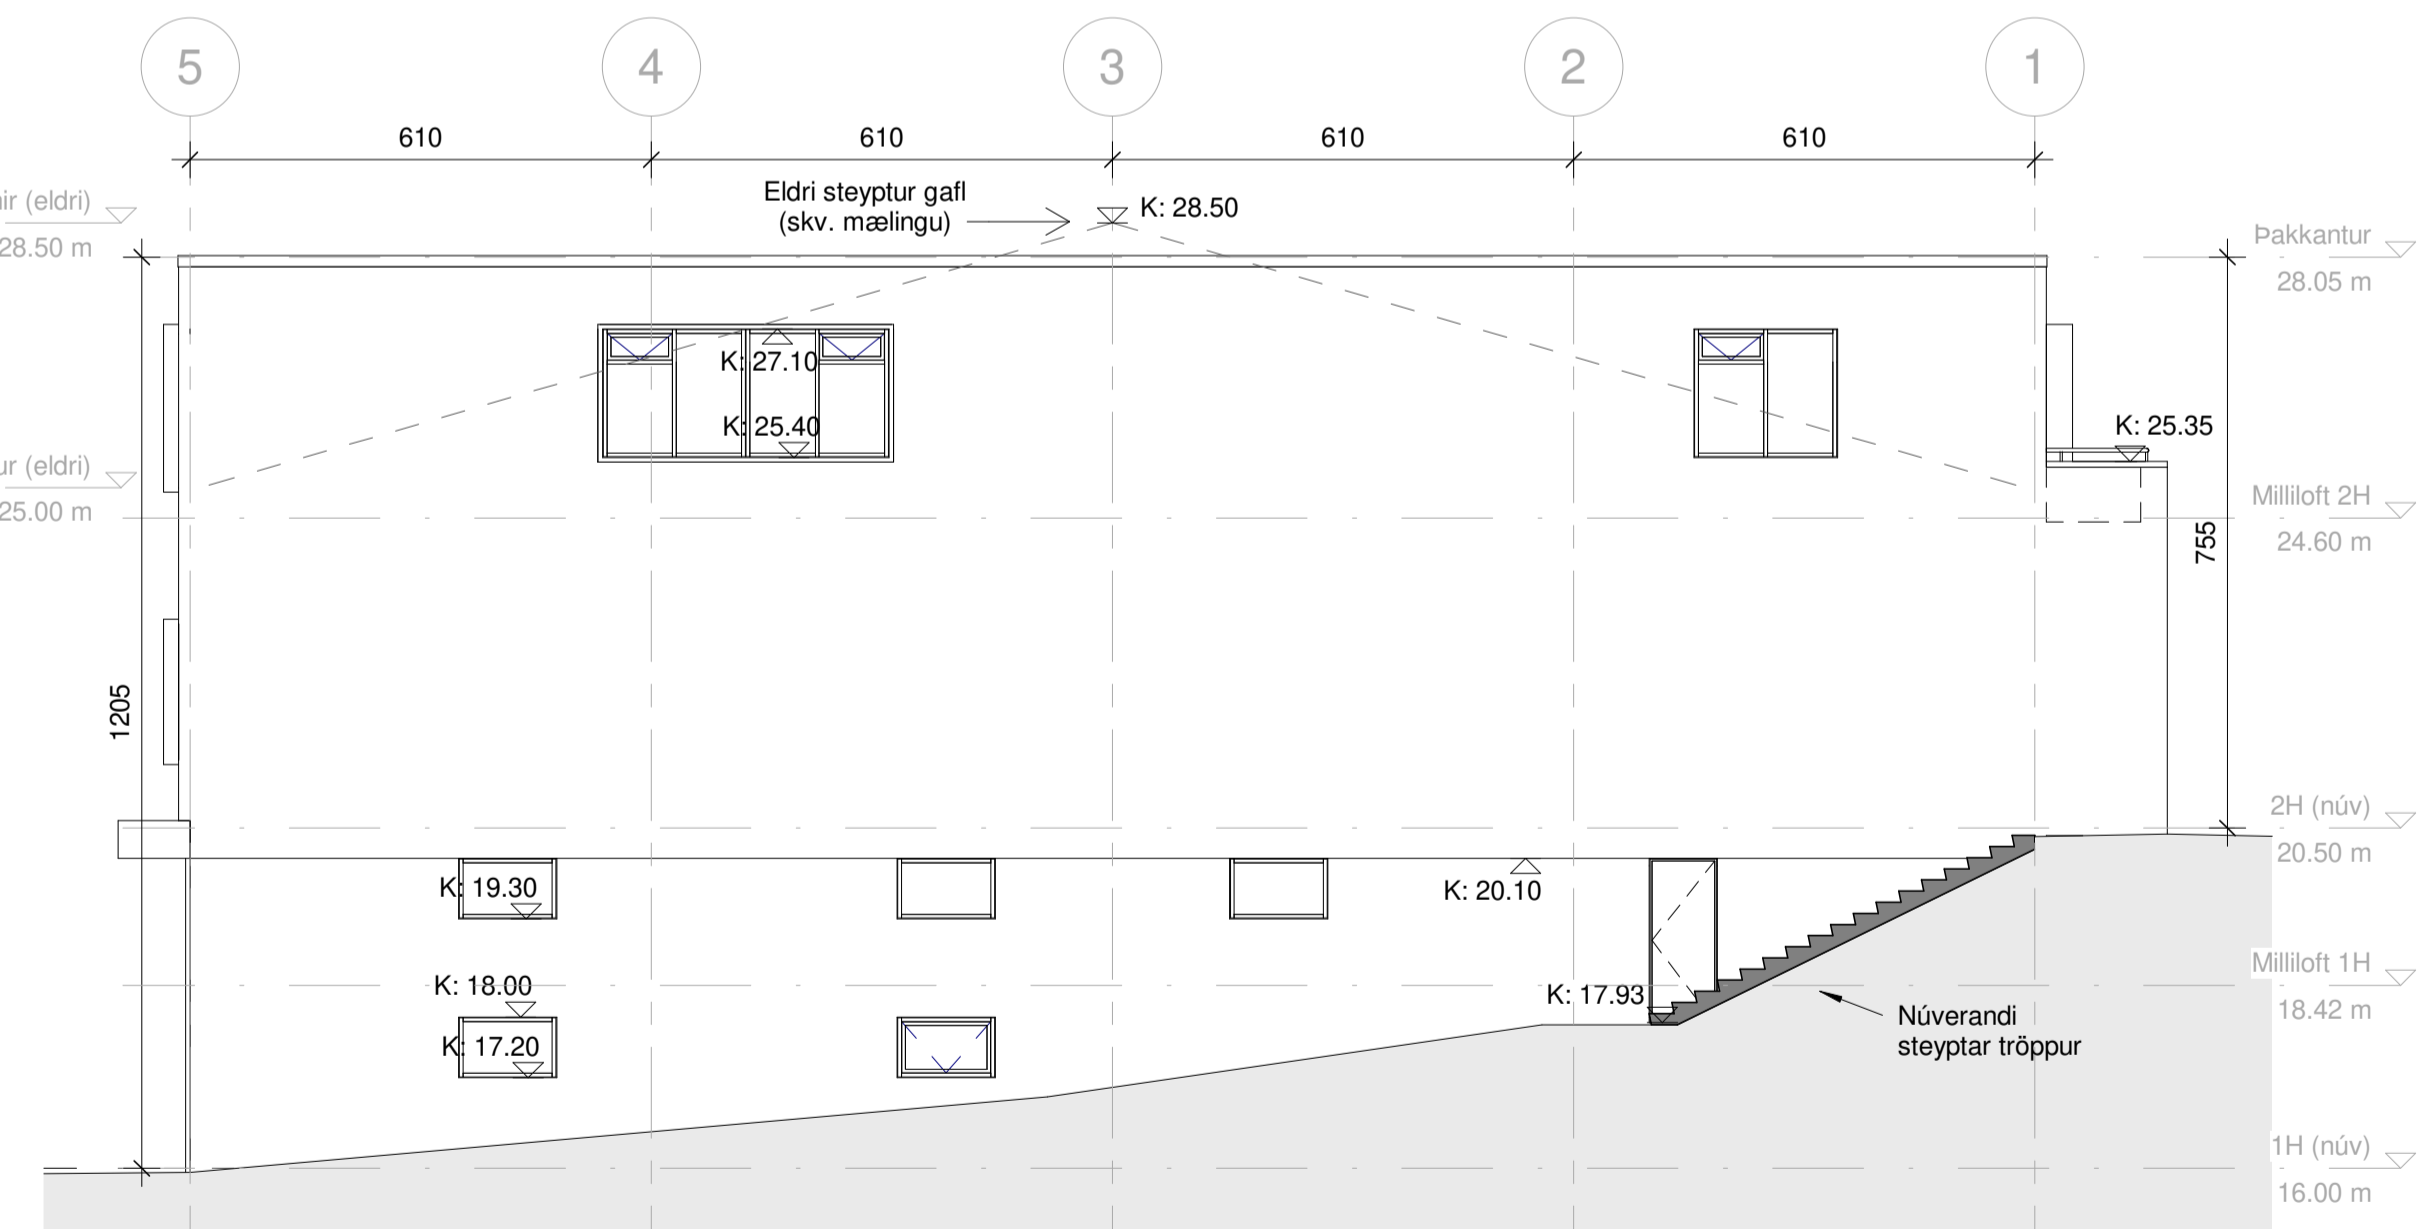

Vestur
1 : 100

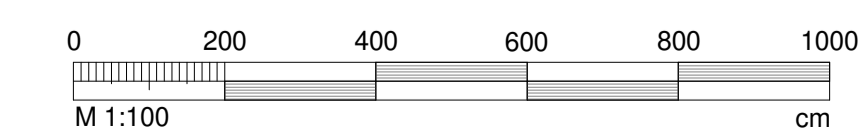

BREYTT			
1	2023.05.15	Reyndart. v. lokaútt.	SJ
METHI VERKS:			
HVALEYRARBRAUT 39			
220 HAFNARFJÖRDUR			
METHI TERNINGAR:			
ADALUPPDRETTIR			
UTLIT			
DAGS:	2019.12.04	HANNA: JL, KÁ	YPRF: KÁ
VERKNR.:	1696	KVARDI:	1:100
TEKNAÐ: LMA		DALVEG 18	
JAKOB EMBELINDAL		201 KÓPÁVOGI	
KRISTJÁN AÐGERÐSSON		SÍM: 524 8000	
ARKITEKT FAL KT: 059567-0229		FAX: 524 8018	
ARKITEKT FAL KT: 140956-0209		KT: 201103-0409	
arkitektar ehf.		arkitektar ehf.	
		www.arkia.is	