



Skýringar



Stigar / lagnaleiðir

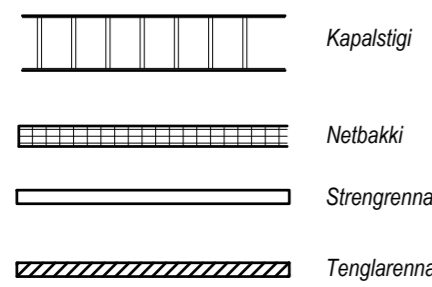

Lágspenna gólf

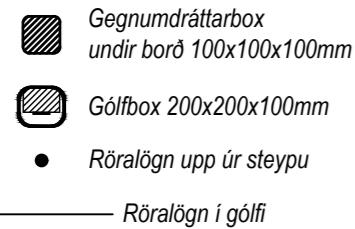


Lágspenna

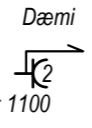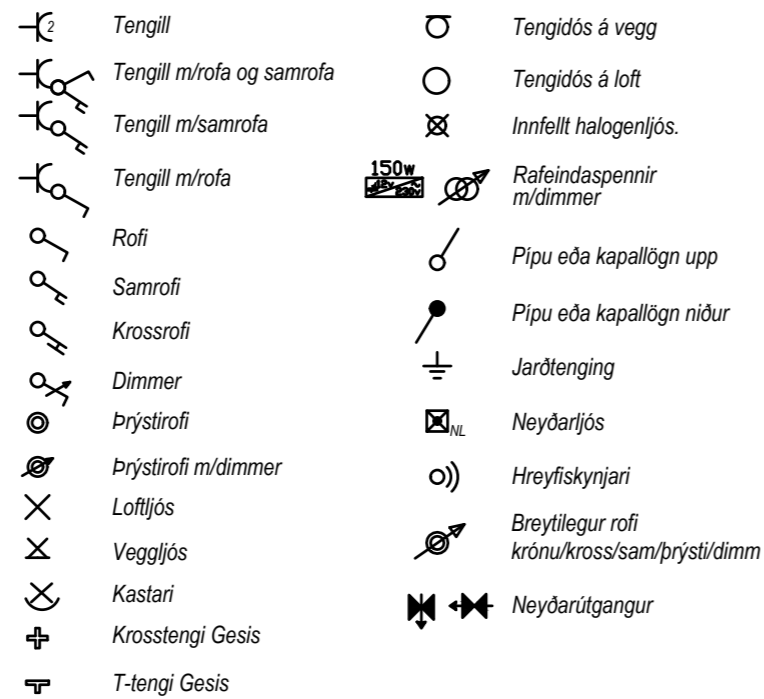

Smáspenna/TSL




Brunakerfi

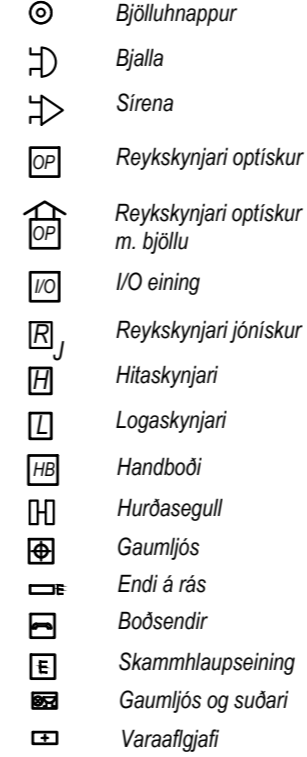


Öryggiskerfi




Lampar

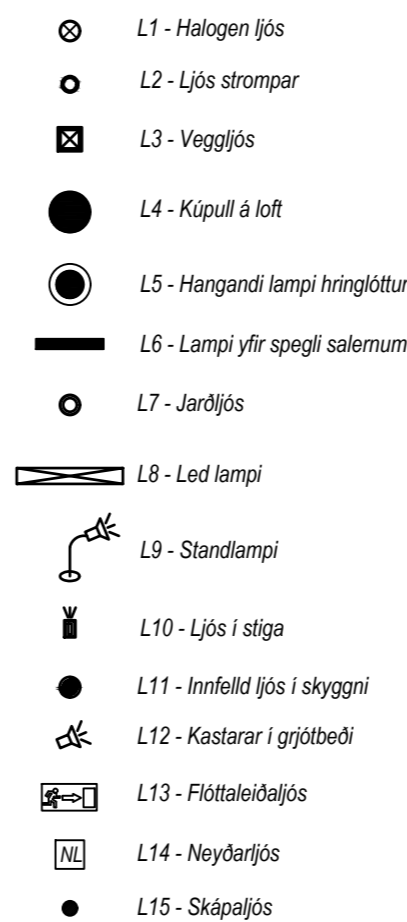

KNX kerfi







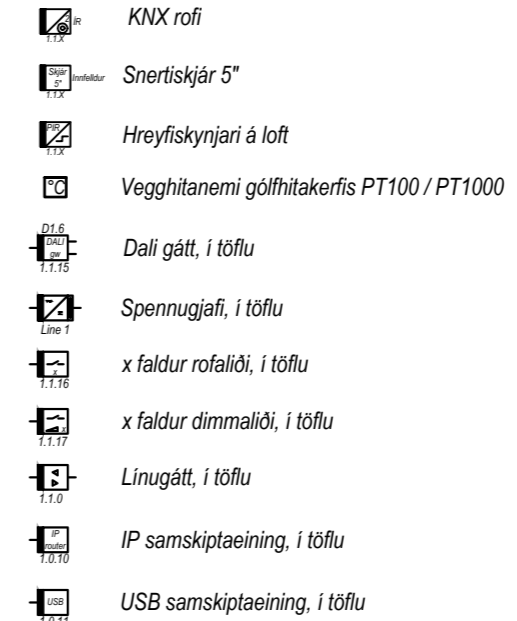


Teikningarnúmer

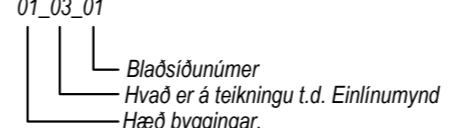

Almennar teikningar 01-07
Lágspenna 11-19
Smáspenna 31-39


Einlinumynd

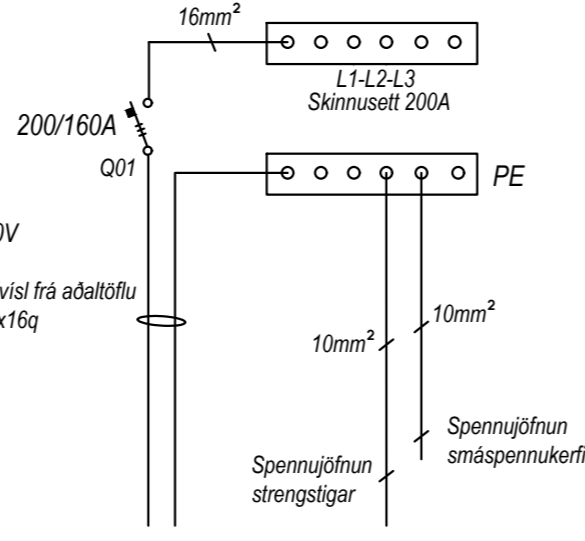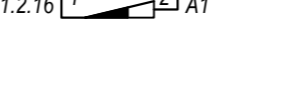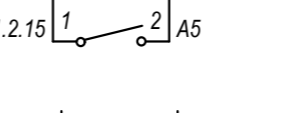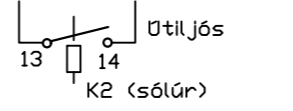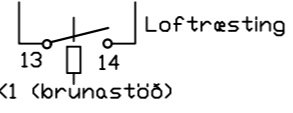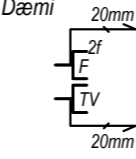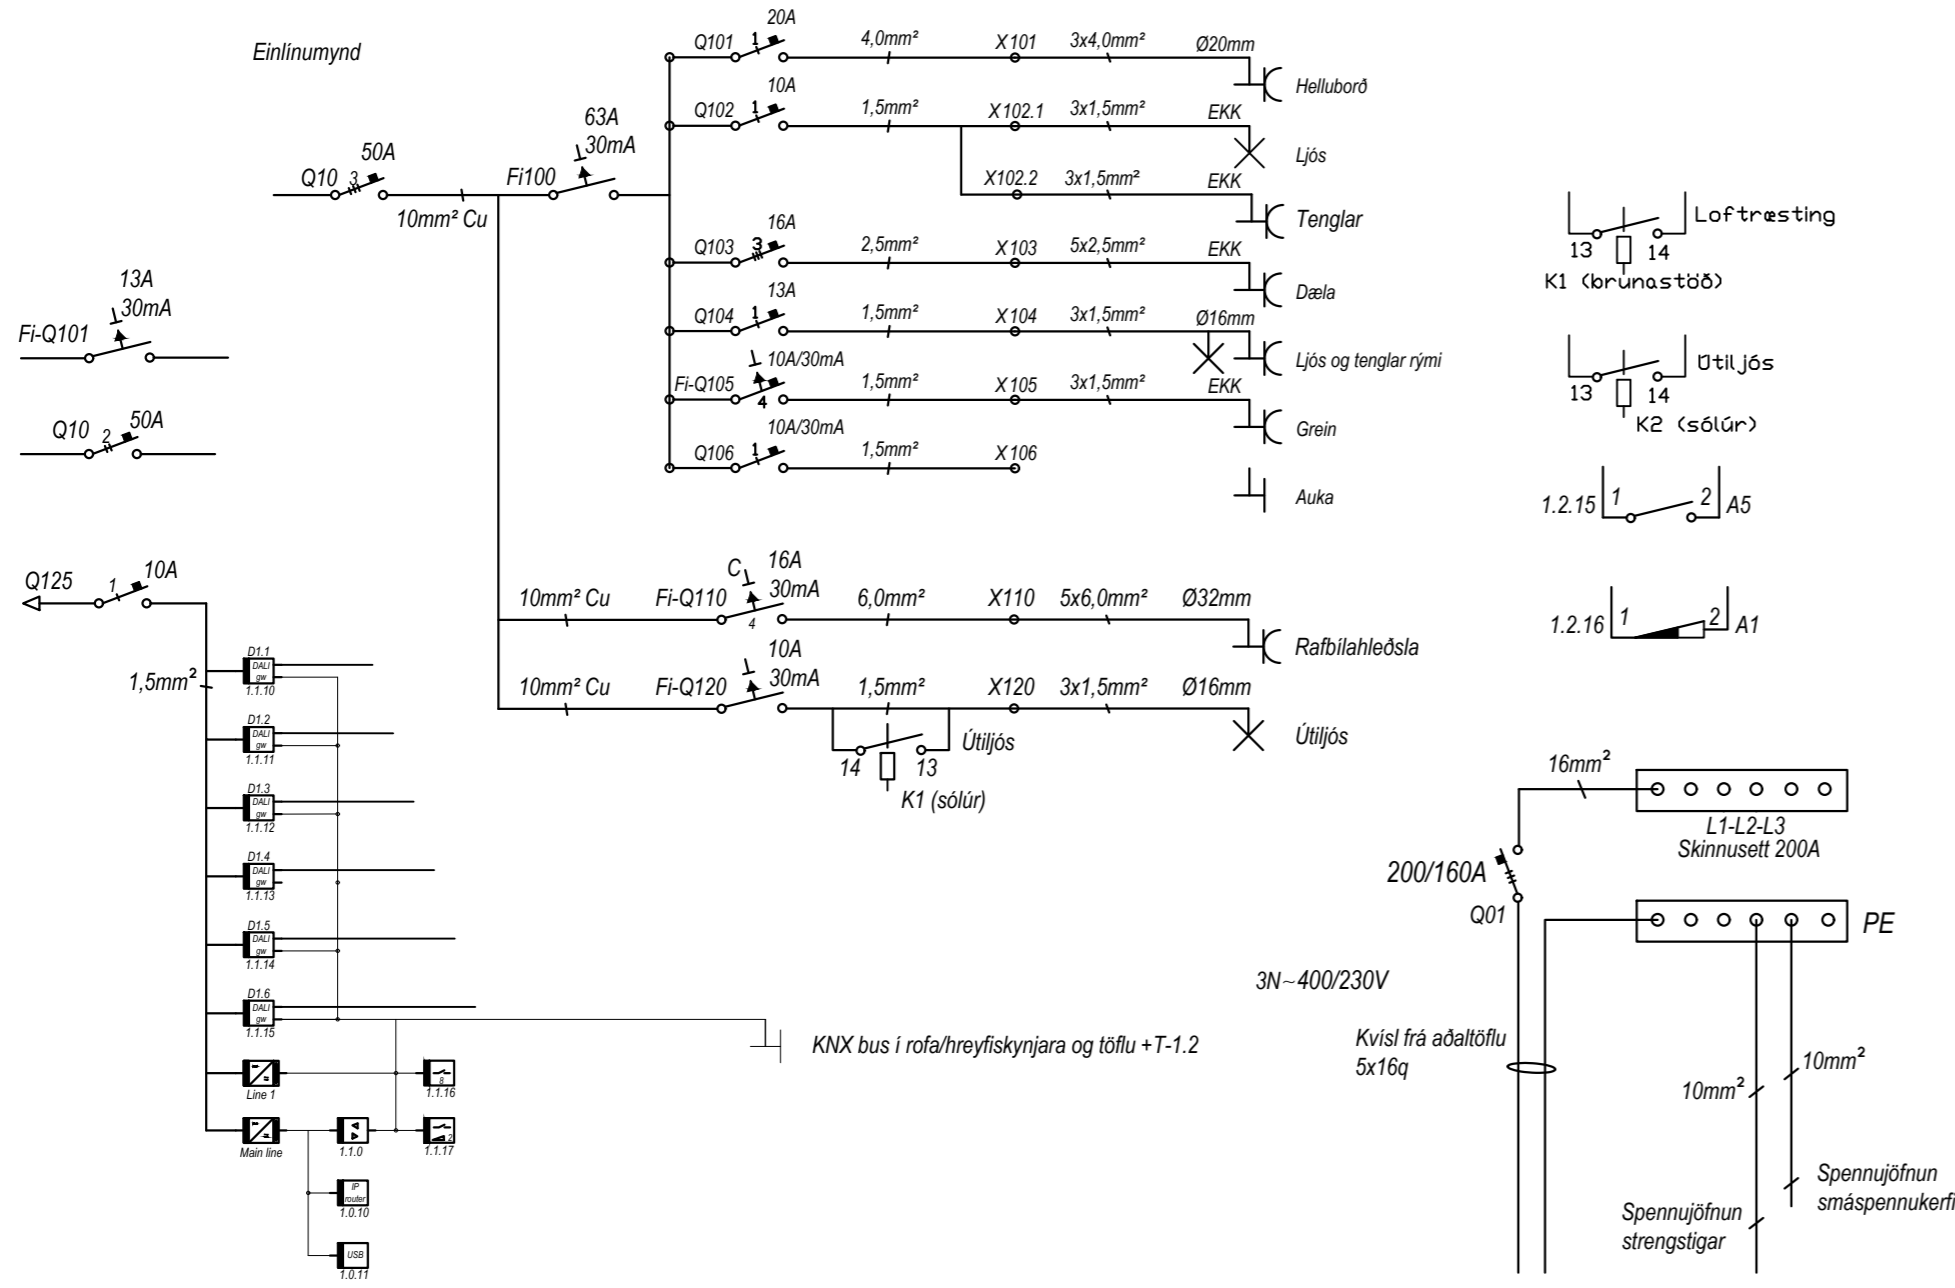

| | | | | | |
|------------------------------------|------------|-------------------|----------|--------------|--|
| Höfundun | | Nafn | | Kennitala | |
| Samb. Raftögnunustur | | Björn Þorgeirsson | | 120769-4729 | |
| www.hpraflausnir.is | | Símí | | +354 6996080 | |
| BREYTINGAR | | | | | |
| ÚTG. | DAGS | BREYTING | HA. | VF. | |
| # | 23.10.2023 | Höfundur | HP | BP | |
| # | | | # | # | |
| # | | | # | # | |
| KVARN | | | | | |
| - | | | | | |
| HAUNAD | TEKNAÐ | YFRF. | ÚTGÁFA | | |
| HP | HP | Bb | H | | |
| VERKLAUPT | | | | | |
| Simon | | | | | |
| VERKLAUPT | | | | | |
| Rafagnir | | | | | |
| Rafagnateikningar | | | | | |
| GÖTUNEFTIR | | | | | |
| Reykjavíkurvegur 4B | | | | | |
| STADUR | | | | | |
| 220. Hafnarfjörður | | | | | |
| HÖNDUÐUR | | | | | |
| Hubert Pawlik, kt. 030493-2819 | | | | | |
| Björn Þorgeirsson, kt. 120769-4729 | | | | | |
| TEKNIÐG NR. | | | | | |
| xx_06_01 | | | | | |
| DAGS | | | VERK NR. | | |
| 18.10.2023 | | | 220-004 | | |
| SAMÞ. | | KENNT. | | | |
| BP | | 120769-4729 | | | |



Afstöðumynd: 1:500

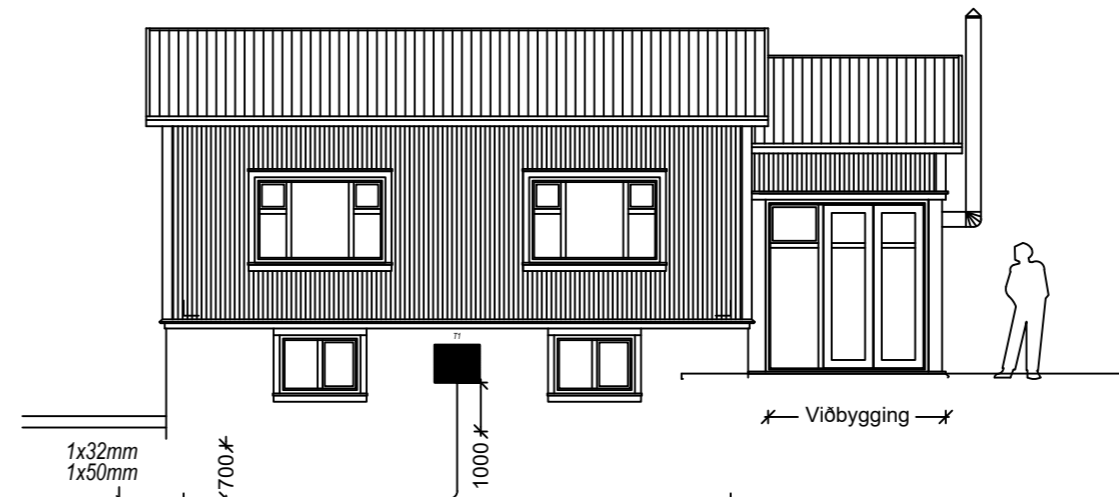


Að lóðarmörkum
Heimtaug rafveitu
Ljósleiðari

Snið: 1:100

| | | | | |
|---------------------------------------|-------------|---------------|--------|-----|
| Háttalun | | | | |
| Nafn | Kennitala | | | |
| Samt. Rafgnáttoustar | | | | |
| Björn Þorgeirsson | 120769-4729 | | | |
| Nafn | Kennitala | | | |
| www.hpraflausnir.is Sími +354 6996080 | | | | |
| BREYTINGAR | | | | |
| ÚTG. | DAGS | BREYTING | HA. | VF. |
| H | 23.10.2023 | Hönnun | HP | BP |
| # | # | # | # | # |
| # | # | # | # | # |
| KVARN | | 1:100 - 1:500 | | |
| HAUNAD | TEKNAÐ | YFRF. | UTGÁFA | |
| HP | HP | Bb | H | |
| VERKALUP | | | | |
| Simon | | | | |
| VERKHLUTI | | | | |
| Rafagnir | | | | |
| Rafagnateikningar | | | | |
| GÖTUNEITI | | | | |
| Reykjavíkurvegur 4B | | | | |
| STADUR | | | | |
| 220. Hafnarfjörður | | | | |
| HÖNNUÐIR | | | | |
| Hubert Pawlik, kt. 030493-2819 | | | | |
| Björn Þorgeirsson, kt. 120769-4729 | | | | |
| TEKING NR. | | | | |
| xx_03_02 | | | | |
| DAGS | | VERK NR. | | |
| 18.10.2023 | | 220-004 | | |
| SAMÞ. | | KENNT. | | |
| BÞ | | 120769-4729 | | |

T1
Einlínunmynd

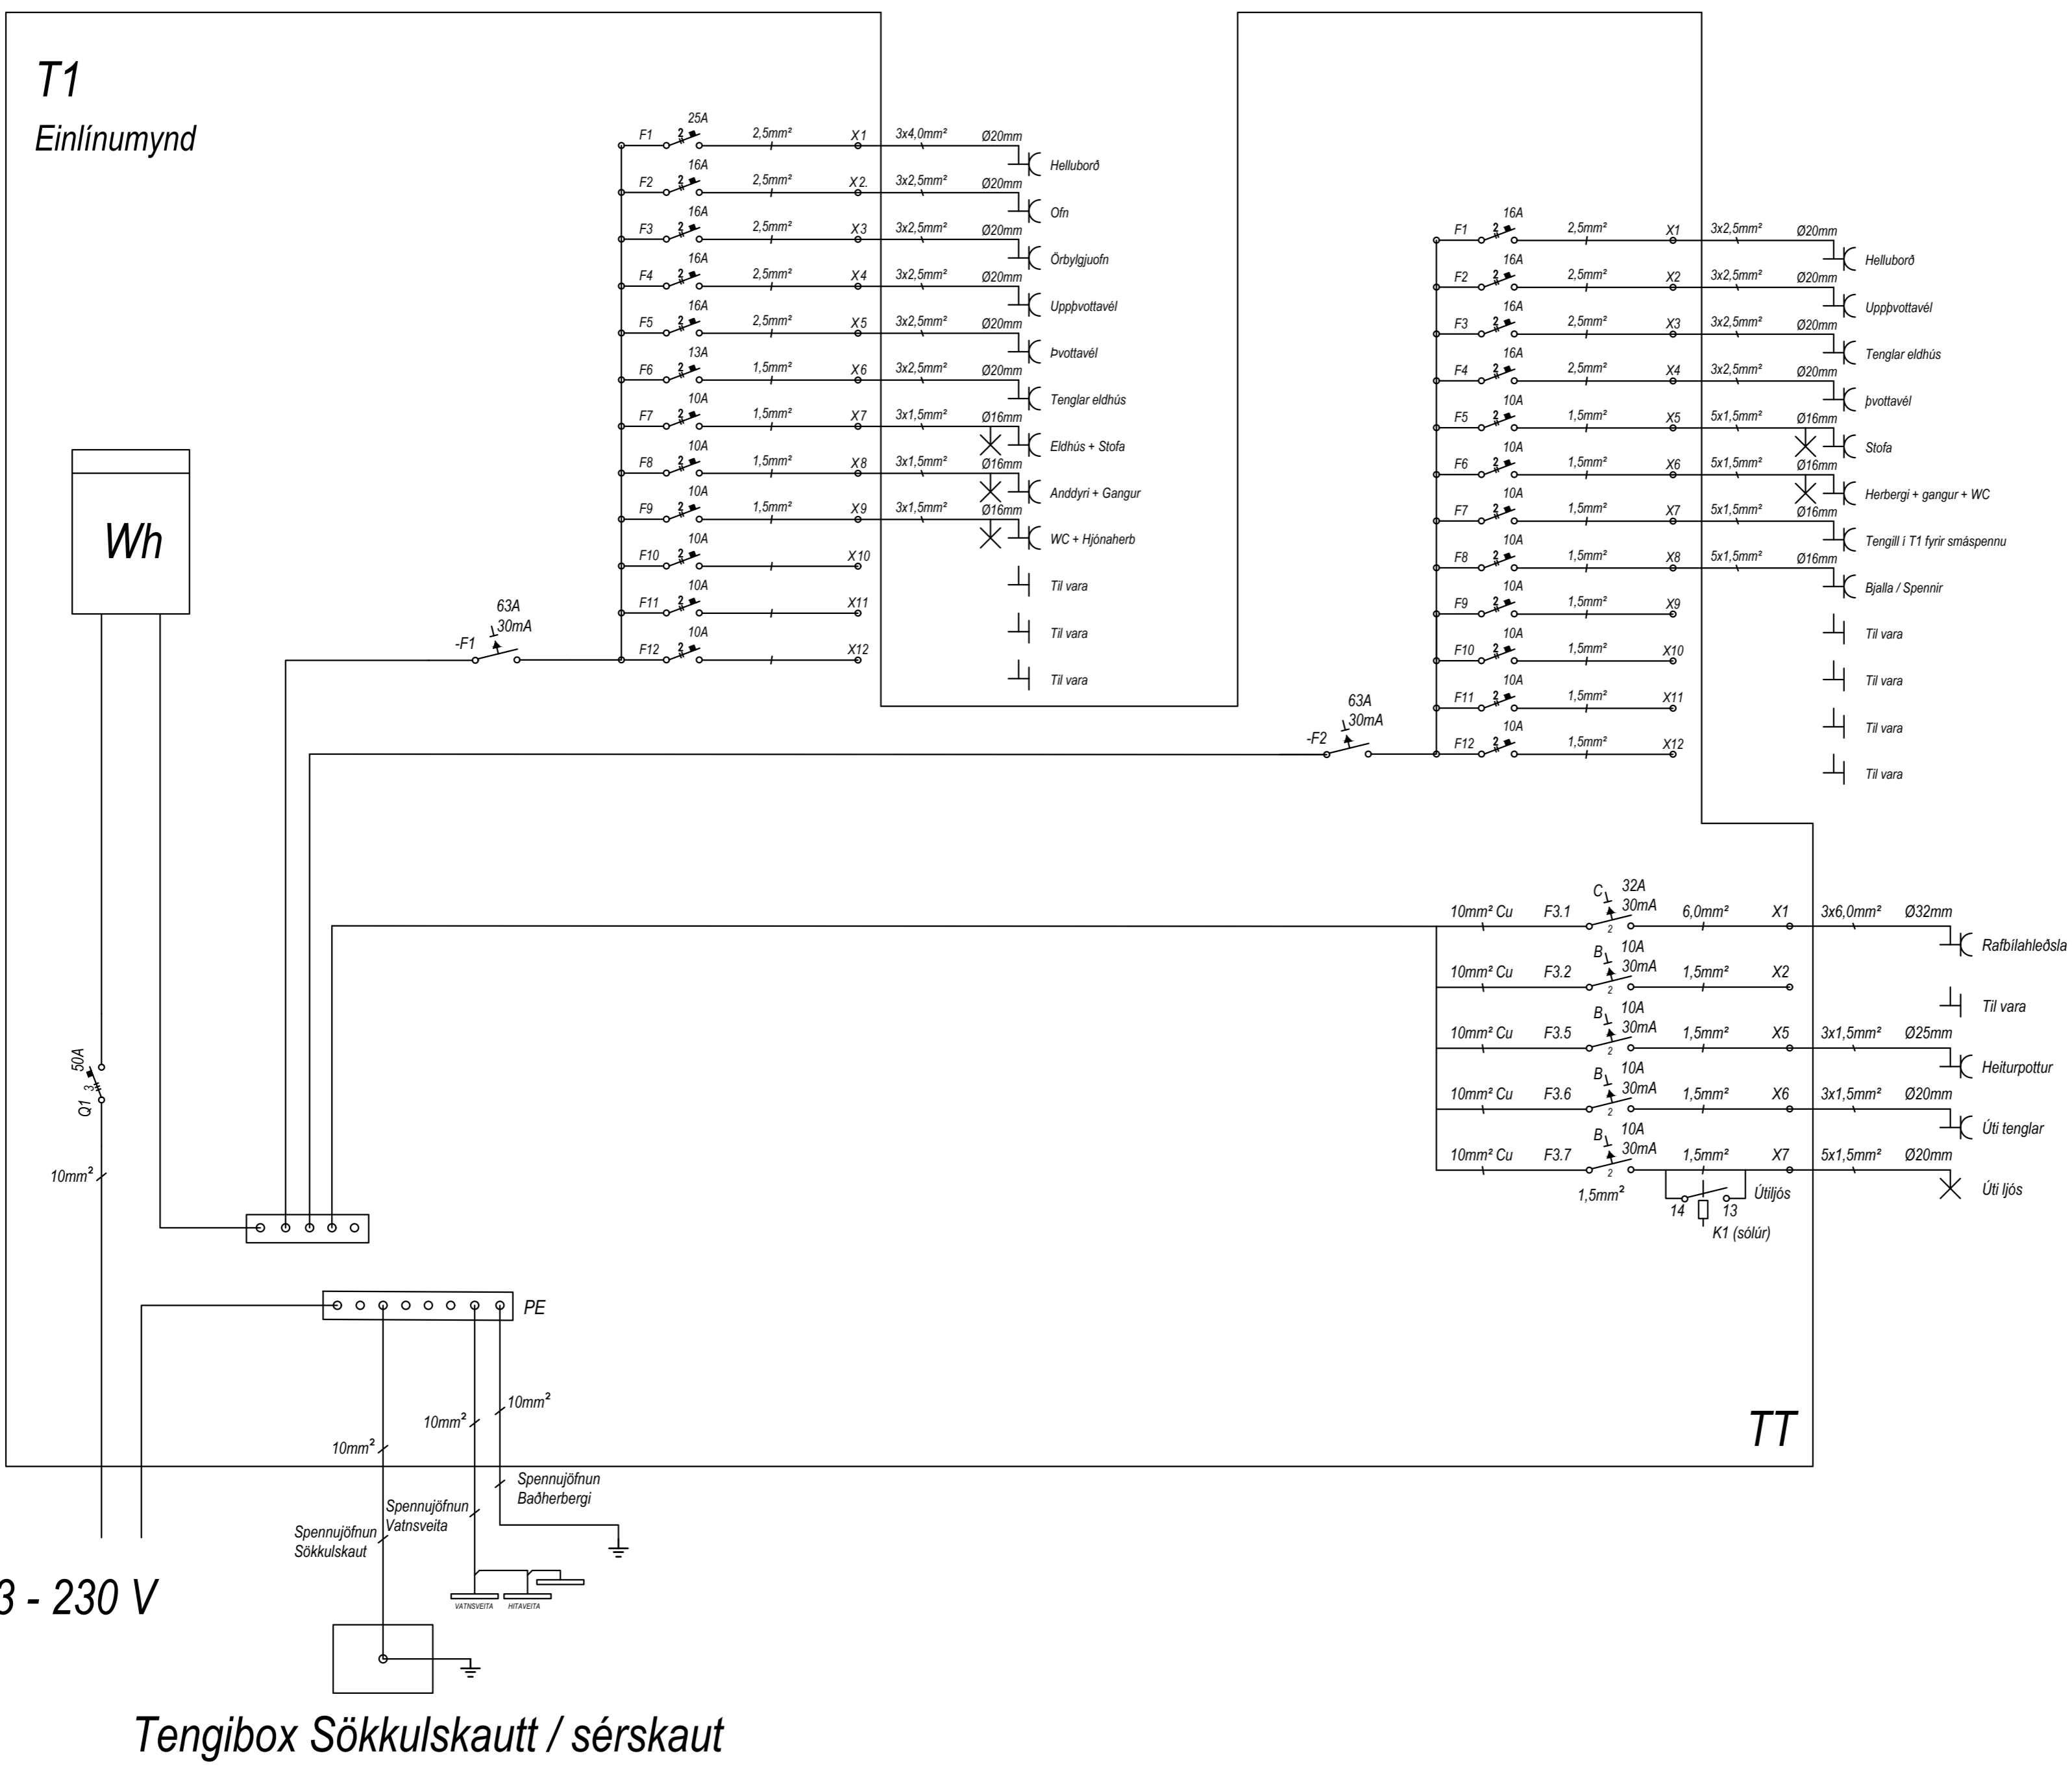


Wh

TT

Heimtaug 3 - 230 V

Tengibox Sökkulskautt / sérskaut

| Háttalun | | Nafn | | Kennitali | |
|------------------------------------|---------|-------------------|----------|--------------|---|
| Samt. Raftagnatöndur | | Björn Þorgeirsson | | 120769-4729 | |
| www.hpraflausnir.is | | Sími | | +354 6996080 | |
| BREYTINGAR | | | | | |
| ÚTG. | DAGS | BREYTING | HA. | VF. | |
| # | # | # | # | # | # |
| # | # | # | # | # | # |
| KVARÐI | | | | | |
| - | | | | | |
| MANNAÞ. | TEKNAÞ. | YFR. | UTGAFA | | |
| HP | HP | Bb | H | | |
| VERKLAUPT | | | | | |
| Simon | | | | | |
| VERKLAUPTI | | | | | |
| Rafagnir | | | | | |
| Rafagnateikningar | | | | | |
| GÖTULEIT | | | | | |
| Reykjavíkurvegur 4B | | | | | |
| STADUR | | | | | |
| 220, Hafnarfjörður | | | | | |
| HÖNNUÐIR | | | | | |
| Hubert Pawlik, kt. 030493-2819 | | | | | |
| Björn Þorgeirsson, kt. 120769-4729 | | | | | |
| TEKNIÐ NR. | | | | | |
| xx_11_03 | | | | | |
| DAGS. | | | VERK NR. | | |
| 18.10.2023 | | | 220-004 | | |
| SAMÞ. | | KENNT. | | | |
| BÞ | | 120769-4729 | | | |

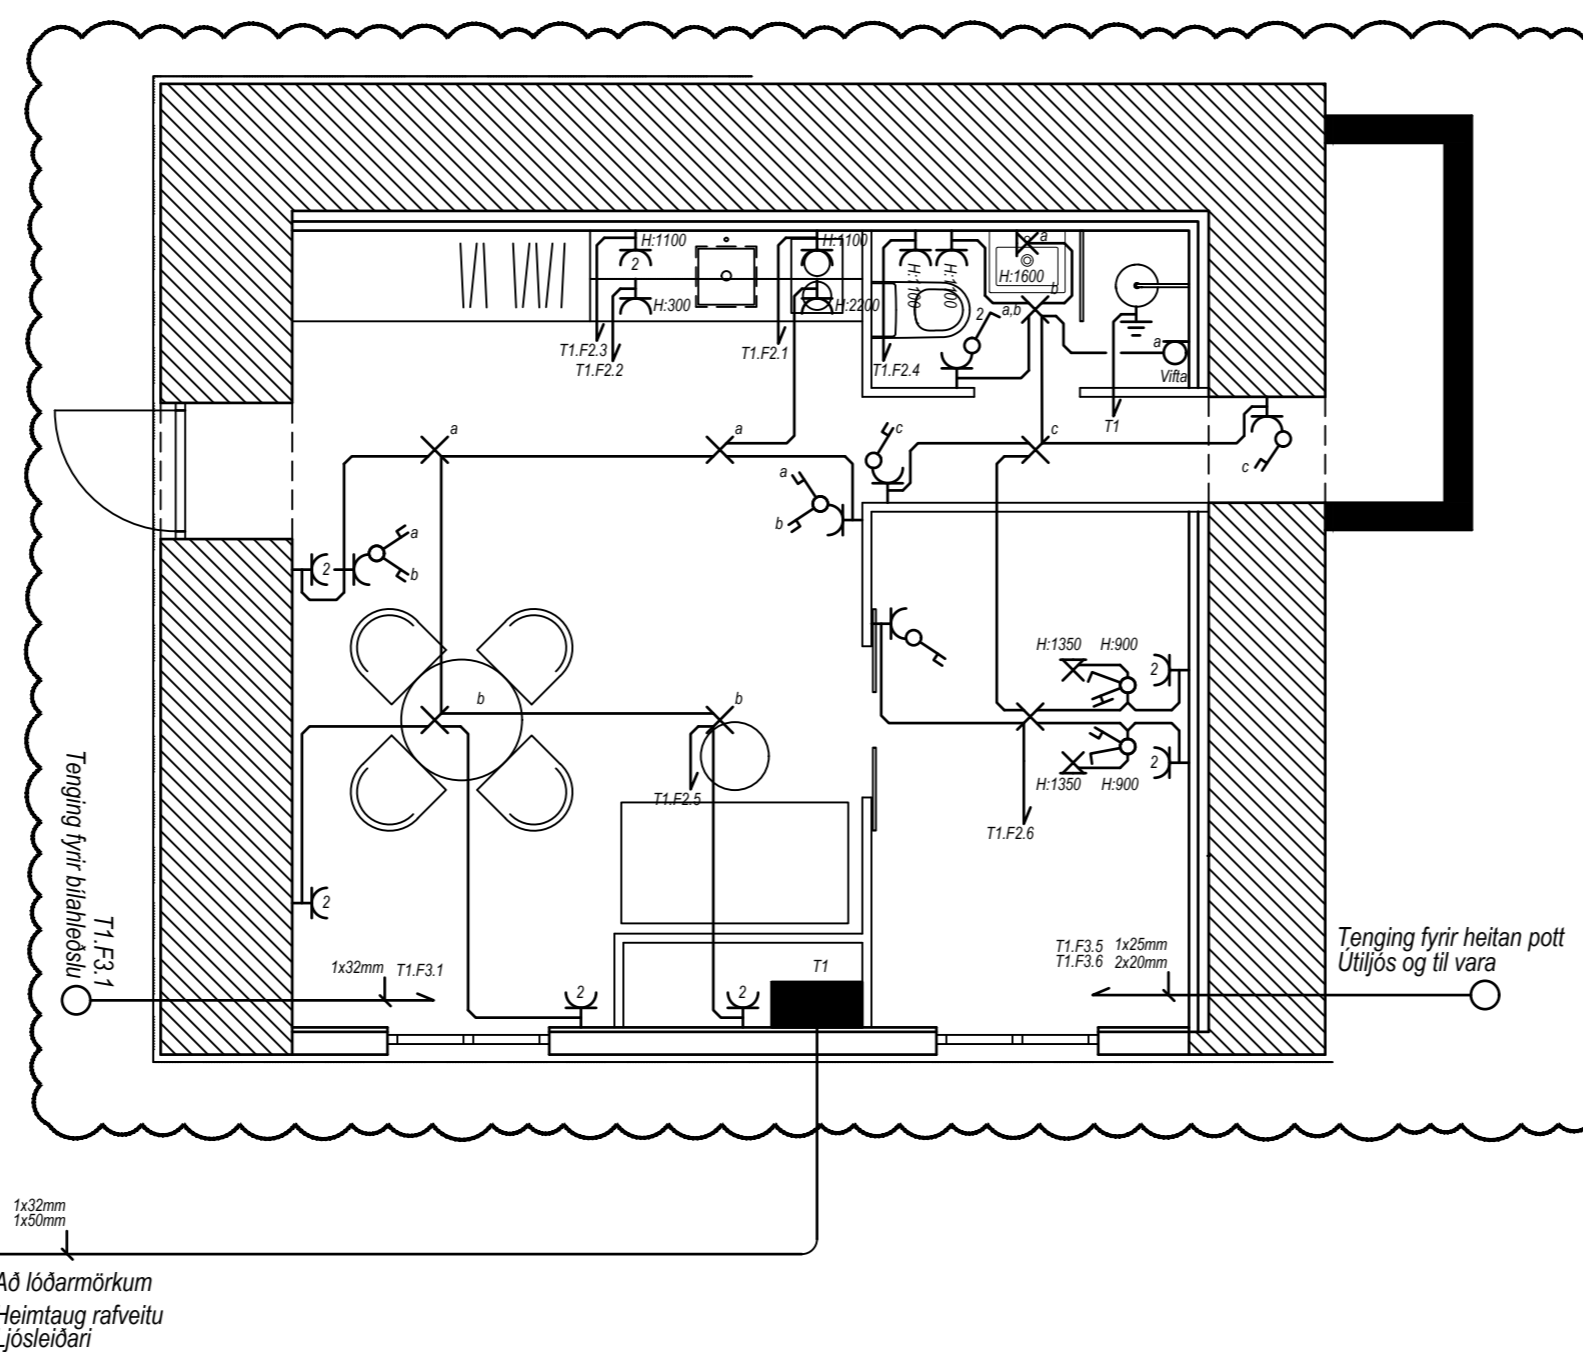

Háttur: _____
 Nafn: _____ Kennitala: _____

Samb. Raftögnunúmer: _____
 Björn Þorgeirsson 120769-4729
 Nafn: _____ Kennitala: _____

www.hpraflausnir.is Sími +354 6996080

| BREYTINGAR | | BREYTING | | HA. | VF. |
|------------|------------|----------|----|-----|-----|
| UTG. | DAGS. | | | | |
| H | 23.10.2023 | Hérinn | HP | BP | |
| # | # | # | # | # | # |
| # | # | # | # | # | # |

KVAFUR
 1:50

| HAUNAD | TEKNAÐ | YFRF. | UTGÁFA |
|--------|--------|-------|--------|
| HP | HP | Bb | H |

VERKKAUPT
Simon

VERKHLUTI
 Rafagnir
 Rafagnateikningar

GÖTUNEYTI
 Reykjavíkurvegur 4B


STADUR
 220, Hafnarfjörður

HÖNNUÐIR
 Hubert Pawlik, kt. 030493-2819
 Björn Þorgeirsson, kt. 120769-4729

TEKING NR.
 00_16_04

| DAGS. | VERK NR. |
|------------|----------|
| 18.10.2023 | 220-004 |

SAMB.
 BP KENNIT.
 120769-4729

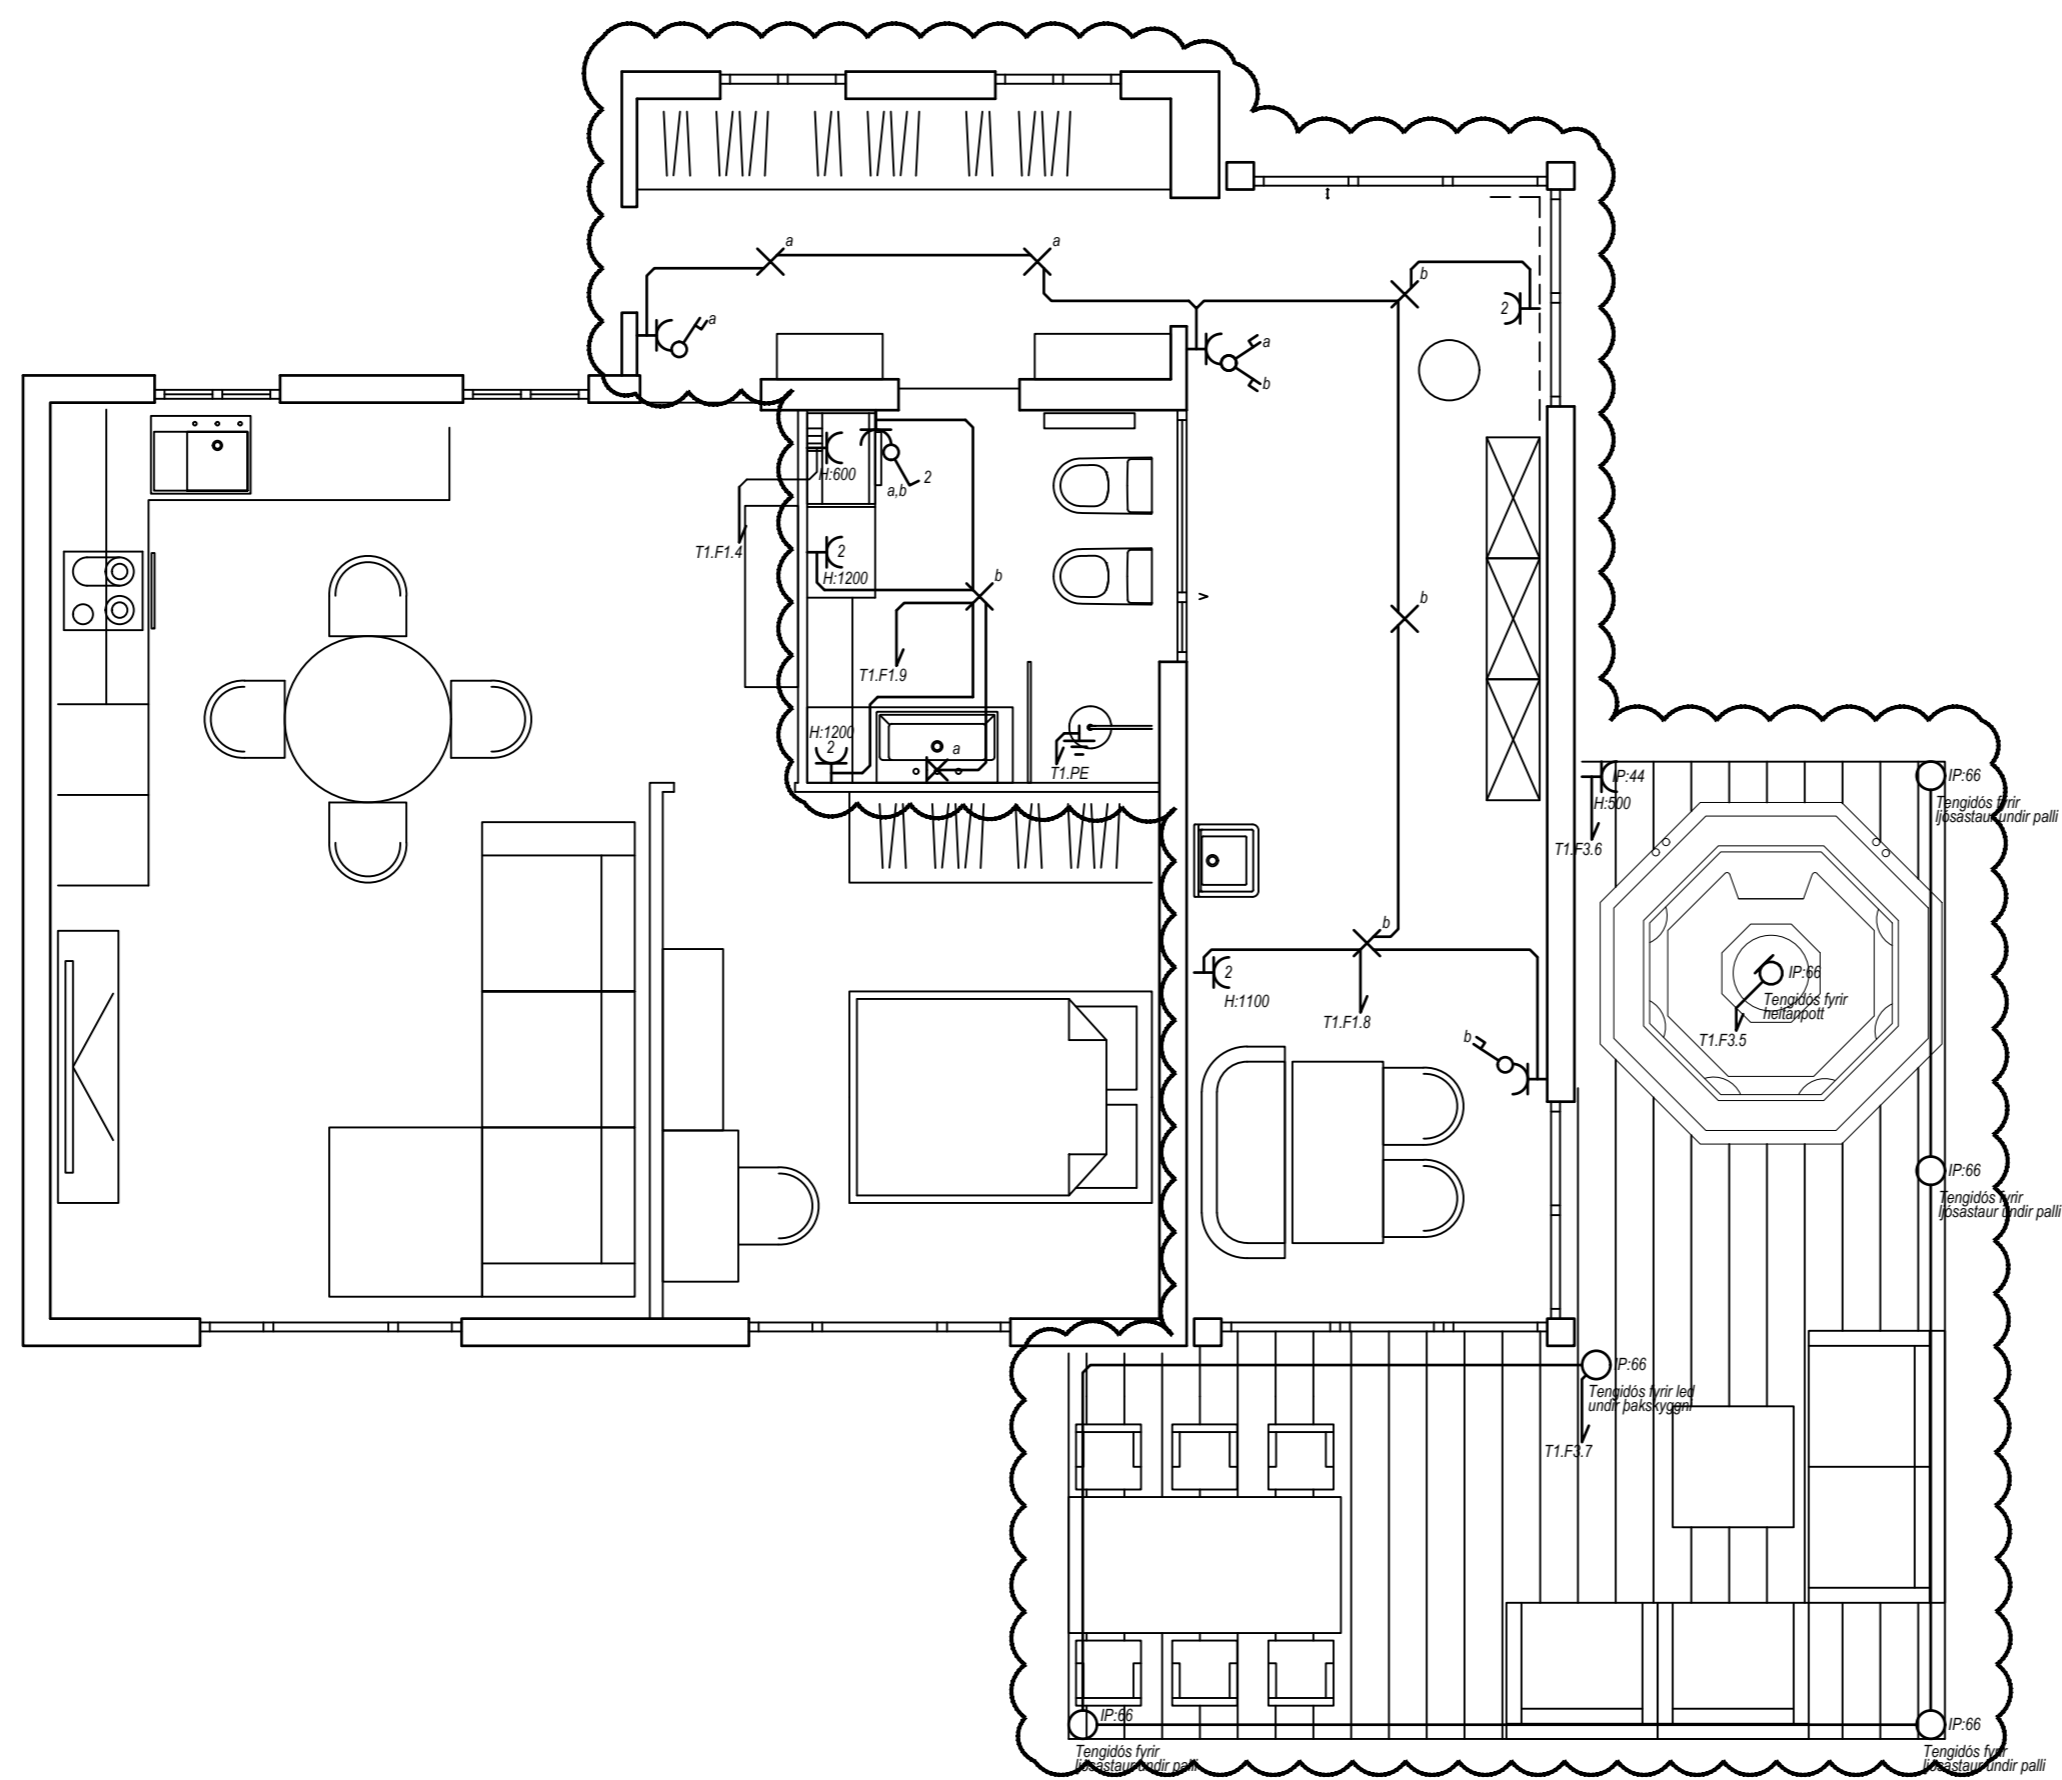

Háttalun

Nafn: _____ Kennitala: _____

Samb. Rafagnisnúmer

Björn Þorgeirsson 120769-4729

Nafn: _____ Kennitala: _____

www.hpraflausnir.is Sími +354 6996080

| BREYTINGAR | | BREYTING | | HA. | VF. |
|------------|------|----------|----|-----|-----|
| UTG. | DAGS | Höfundur | HP | BP | |
| # | # | # | # | # | # |
| # | # | # | # | # | # |

KVAFUR
1:50

| HANNAÐ | TEKNAÐ | YFRF. | UTSÁFA |
|--------|--------|-------|--------|
| HP | HP | Bb | H |

VERKKAUPT

Simon

VERKSLUTI

Rafagnir

GÖTUNEFTIR

Reykjavíkurvegur 4B

STADUR

220, Hafnarfjörður

HÖNNUNIR

Hubert Pawlik, kt. 030493-2819
Björn Þorgeirsson, kt. 120769-4729

TEKNIING NR.

01_16_05

DAGS

18.10.2023

VERK NR.


220-004

SAMB.

Bb

KENNT.

120769-4729

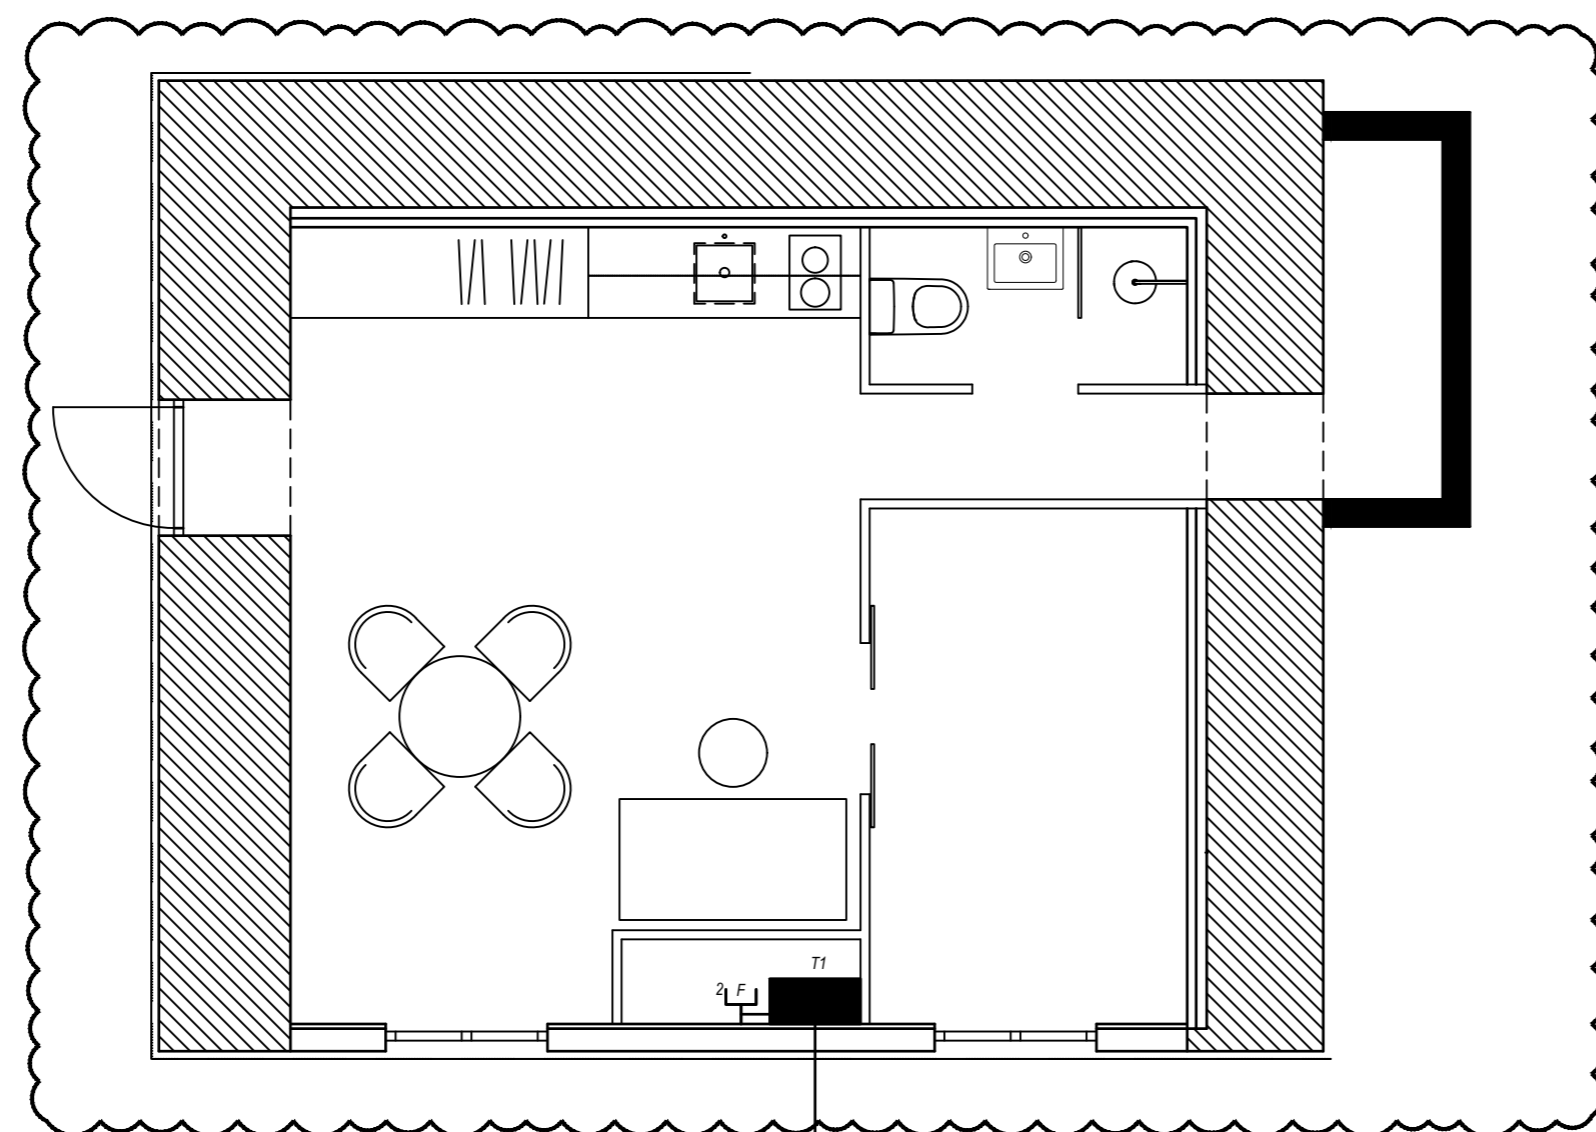

1x32mm
1x30mm
Að lóðarmörkum
Heimtaug rafveitu
Ljósleiðari

Háttalæsing

Nafn: _____ Kennitala: _____

Samb. Raftögnastofur

Björn Þorgeirsson 120769-4729
Nafn: _____ Kennitala: _____

www.hpraflausnir.is Sími +354 6996080

| BREYTINGAR | | BREYTING | | HA. | VF. |
|------------|-------|----------|----|-----|-----|
| ÚTG. | DAGS. | Hérkun | HP | EP | |
| # | # | # | # | # | # |
| # | # | # | # | # | # |

KVAFUR
1:50

| HAUNAD | TEKNAÐ | YFRF. | ÚTGÁFA |
|--------|--------|-------|--------|
| HP | HP | Bb | H |

VERKKAUPT
Simon

VERKHLUTI
Rafagnir
Rafagnateikningar

GÖTUNEITI
Reykjavíkurvegur 4B

STADUR
220.Hafnarfjörður

HÖNGBER
Hubert Pawlik, kt. 030493-2819
Björn Þorgeirsson, kt. 120769-4729

TEKING NR.
00_31_06

DAGS.
18.10.2023

VERK NR.
220-004

SAMB.
HP

KENNT.
120769-4729