



Grunnmynd 1h (mhl 03)
1 : 100

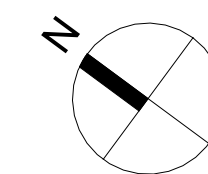

A	09.06.2023	Sorpgámar á einum stað á suðurhluta lóðar	
ÚTGÁFA	DAGS	BREYTING	YFIRFARID

ASK arkitektar ehf
Geirsgötu 9 101 Reykjavík
Sími 515 0300 www.ask.is

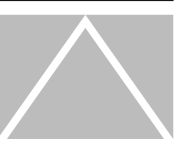

ÁRITUN HÖNNUNAR ADALUPPDRÁTTA



Gunnar Óm Sigurðsson Arkitekt F.A.Í. Kt:130666-3379
gunnar@ask.is

VERKEFNI
Stekkarberg 9
Hafnarfirði

TEGUND TEIKNINGAR
03-ADALTEIKNINGAR
HEITI TEIKNINGAR
Grunnmynd 1h (mhl 03)

MKV. I A3
1 : 100
HANNAÐ
GÖS
TEIKNAD
GÖS / SLS
YFIRF.
SS
DAGS.
18.08.2021

VERK NR.	AUÐKENNI - NÚMÉR TEIKNINGAR	ÚTGÁFA
1411	03-10-02	A

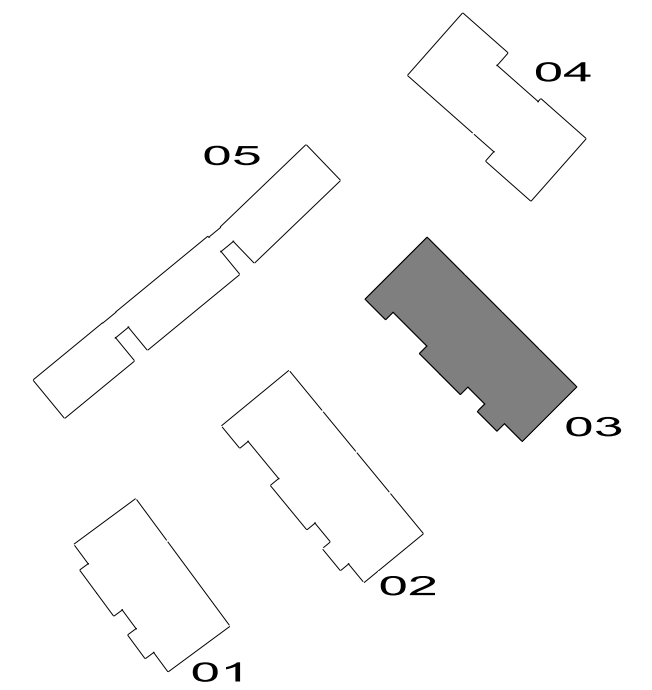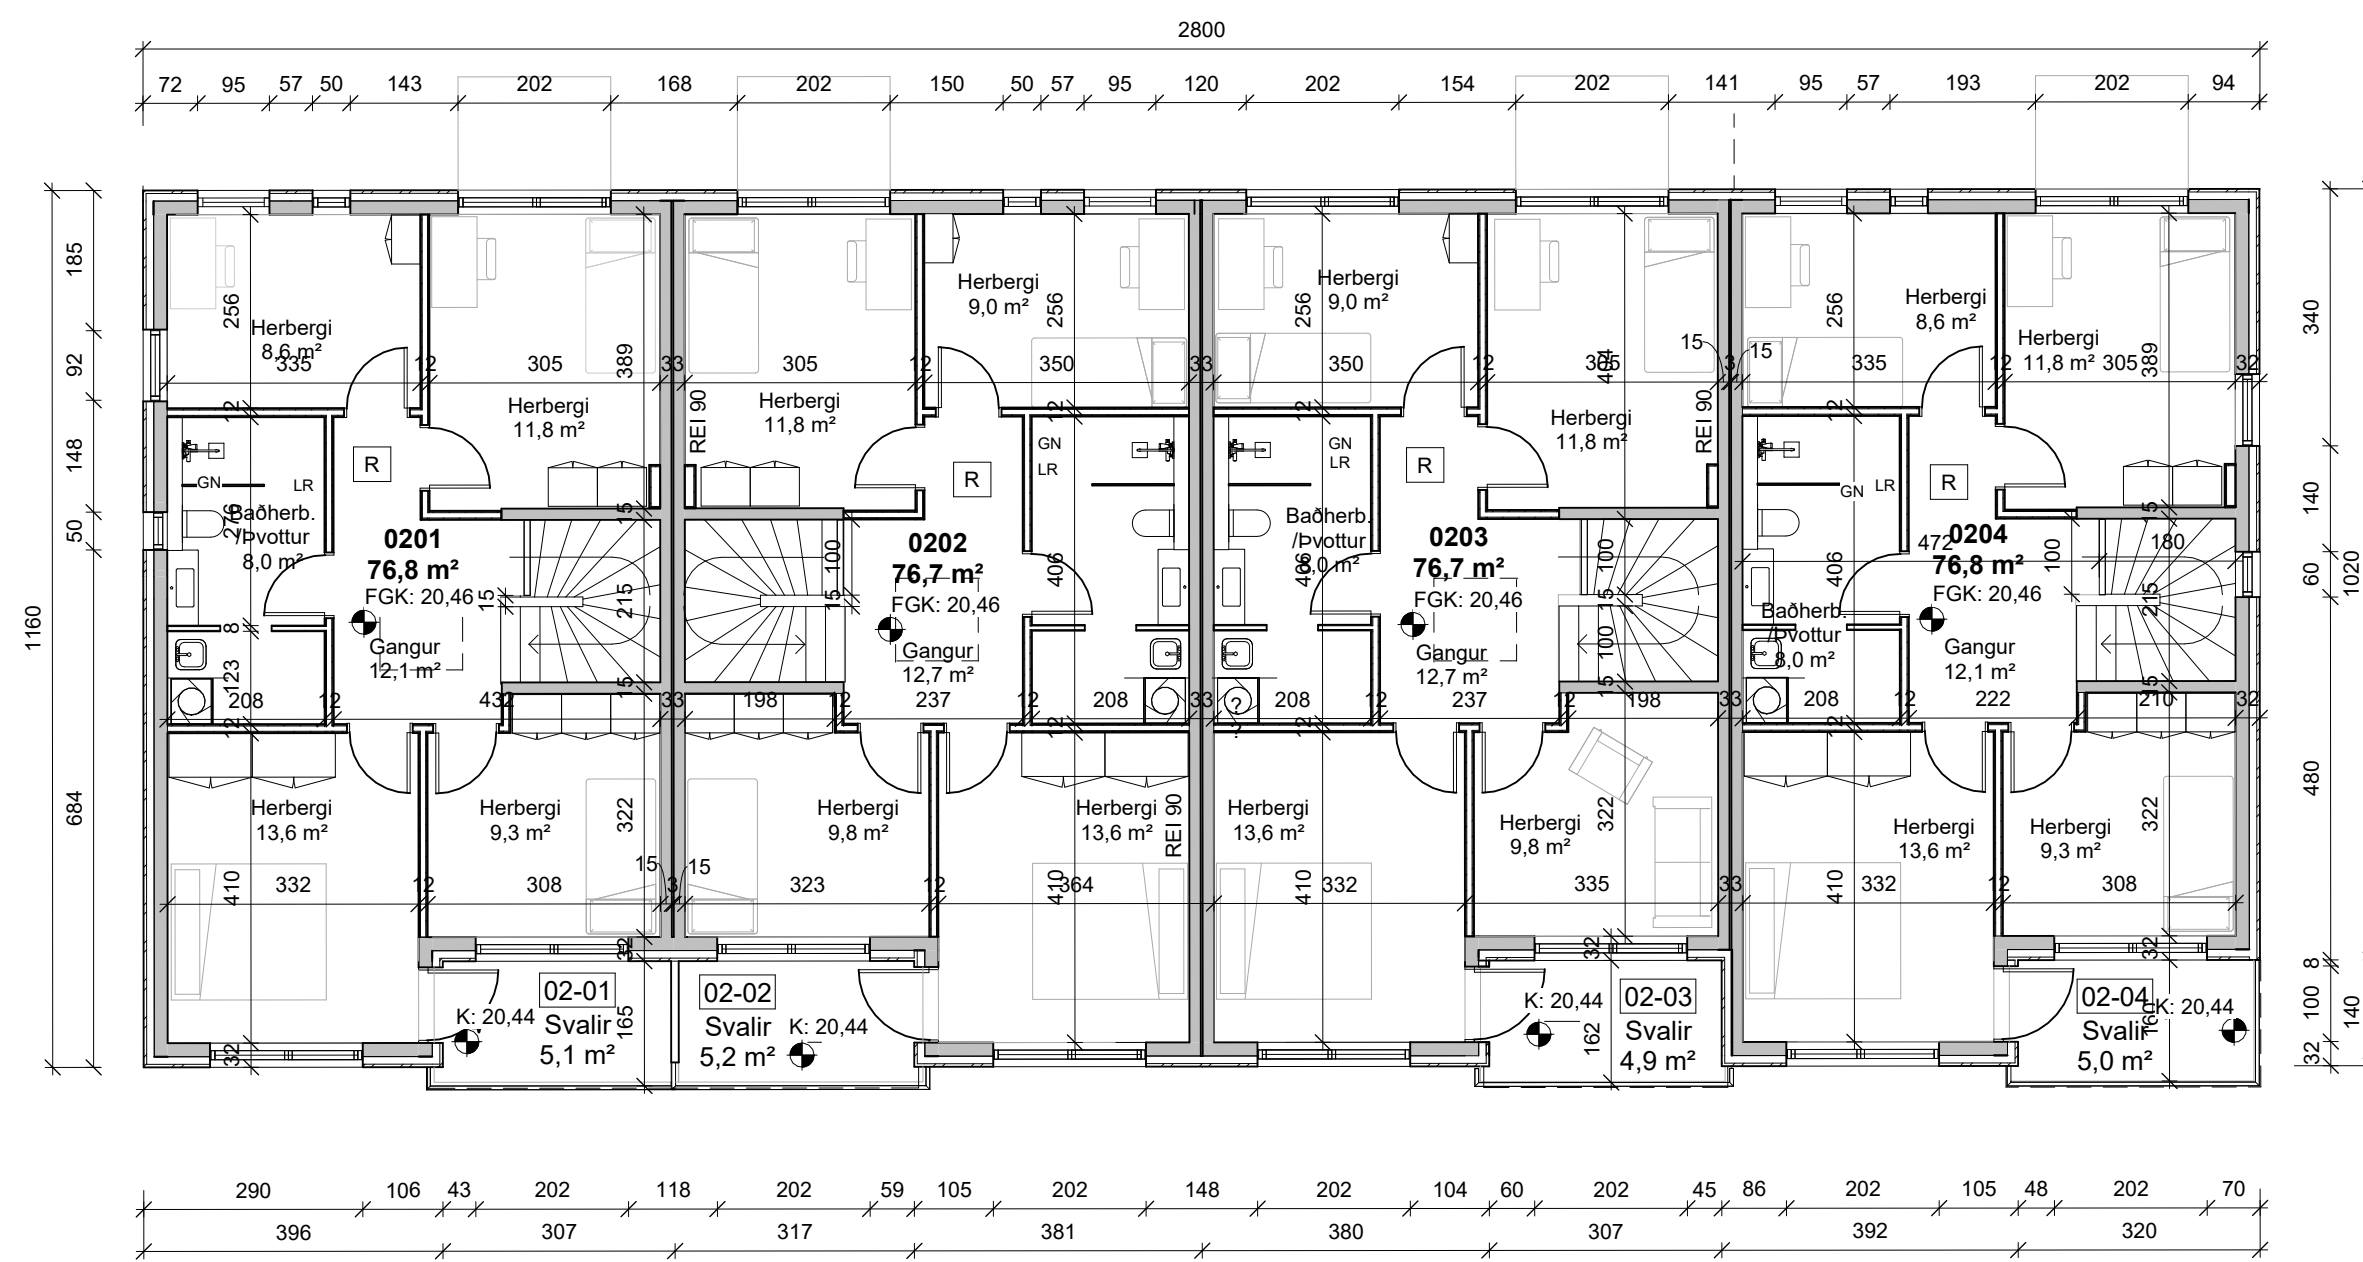

Grunnmynd 2h (mhl 03)
1 : 100

A	09.06.2023	Skyggni fellt út við tækniryri	
ÚTGÁFA	DAGS	BREYTING	YFIRFARID

ASK arkitektar ehf
Geirsgötu 9 101 Reykjavík
Sími 515 0300 www.ask.is




ÁRITUN HÖNNUBAR ADALUPPDRA'TTA

Gunnar Óm Sigurðsson Arkitekt F.A.Í. Kt:130666-3379
gunnar@ask.is


VERKEFNI		MRV. I A3
Stekkjærberg 9		1 : 100
Hafnarfirði		HANNAÐ
TEGUND TEIKNINGAR		GÖS
HEITI TEIKNINGAR		TEIKNAD
Grunnmynd 2h (mhl 03)		GÖS / SLS
		YFIRF.
		SS
		DAGS.
		20.06.2021
VERK NR.	AUDKENNI - NÚMER TEIKNINGAR	ÚTGÁFA
1411	03-10-03	A



Snið 1 (mhl 03)
1 : 100

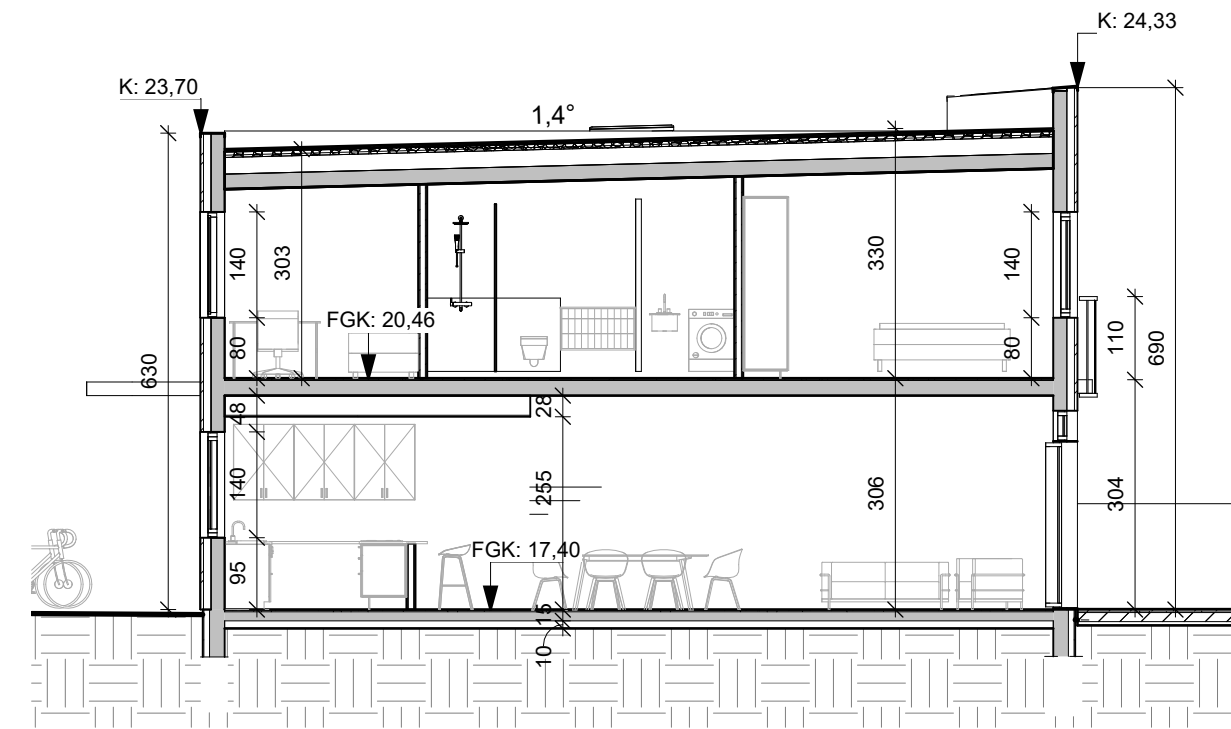


Snið 4 (mhl 03)
1 : 100

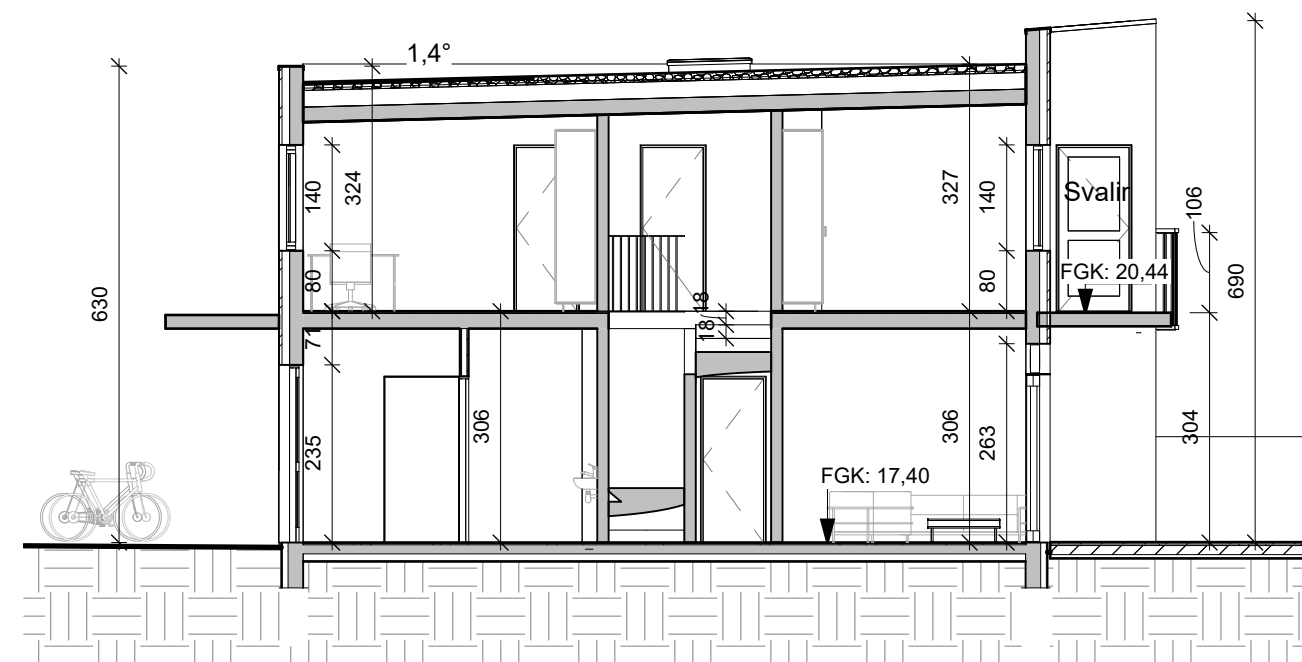

Snið 3 (mhl 03)
1 : 100



Snið 2 (mhl 03)
1 : 100

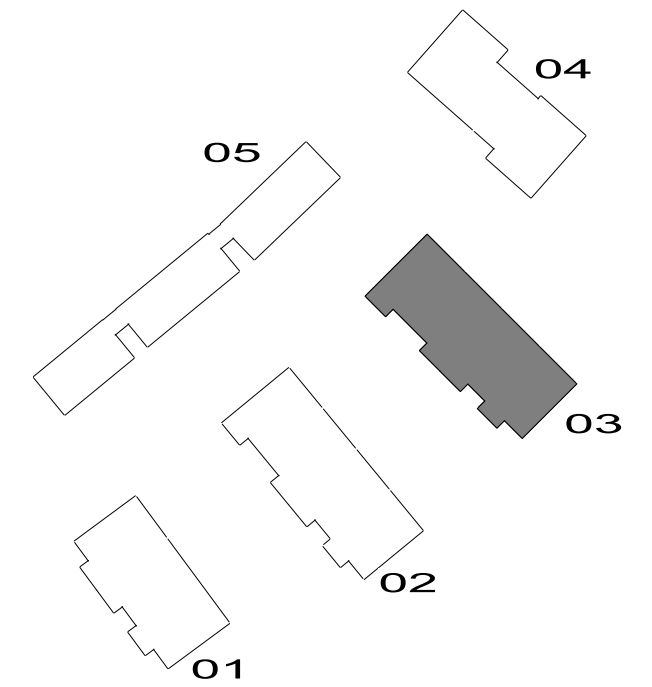

A	09.06.2023	Stækkun baðherbergis á 2.hæð	
ÚTGÁFA	DAGS	BREYTING	YFIRFARID

ASK arkitektar ehf
Geirsgötu 9 101 Reykjavík
Sími 515 0300 www.ask.is

ÁRITUN HÖNNUNAR ADALUPPRÁTTA




ASK
ARKITEKTAR

Gunnar Óm Sigurðsson Arkitekt F.A.I. Kt:130666-3379
gunnar@ask.is


VERKEFNI		
Stekkjærberg 9		
Hafnarfirði		
TEGUND TEIKNINGAR	03-ADALTEIKNINGAR	MKV. I A2 1 : 100
HEITI TEIKNINGAR	Snið (mhl 03)	HANNAÐ GÖS
		TEIKNAD GÖS/SLS
		YFIRF. SS
		DAGS. 18.08.2021
VERK NR.	1411	ÚTGÁFA
AUDKENNI - NÚMÉR TEIKNINGAR	03-10-04	A




Suð-Vestur (mhl 03)
1 : 100

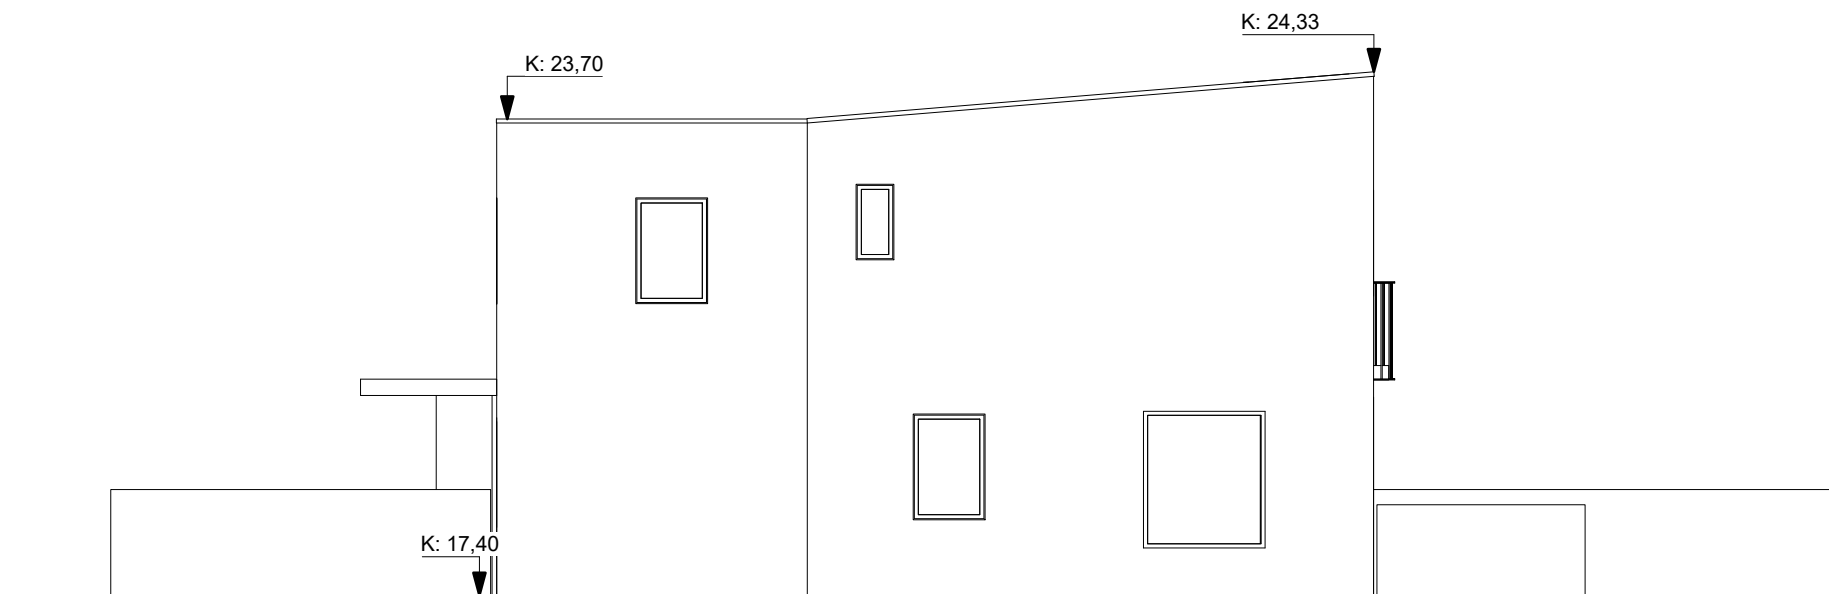

Norð-Vestur (mhl 03)
1 : 100

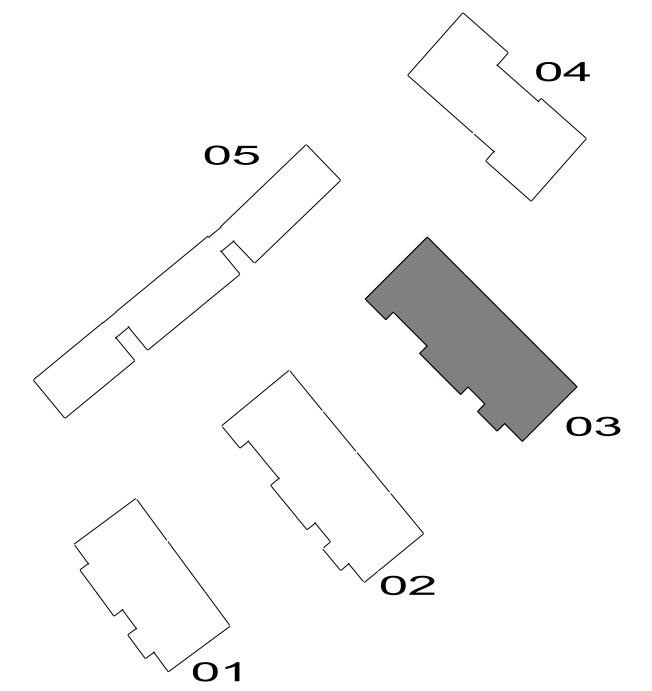

Norð-Austur (mhl 03)
1 : 100

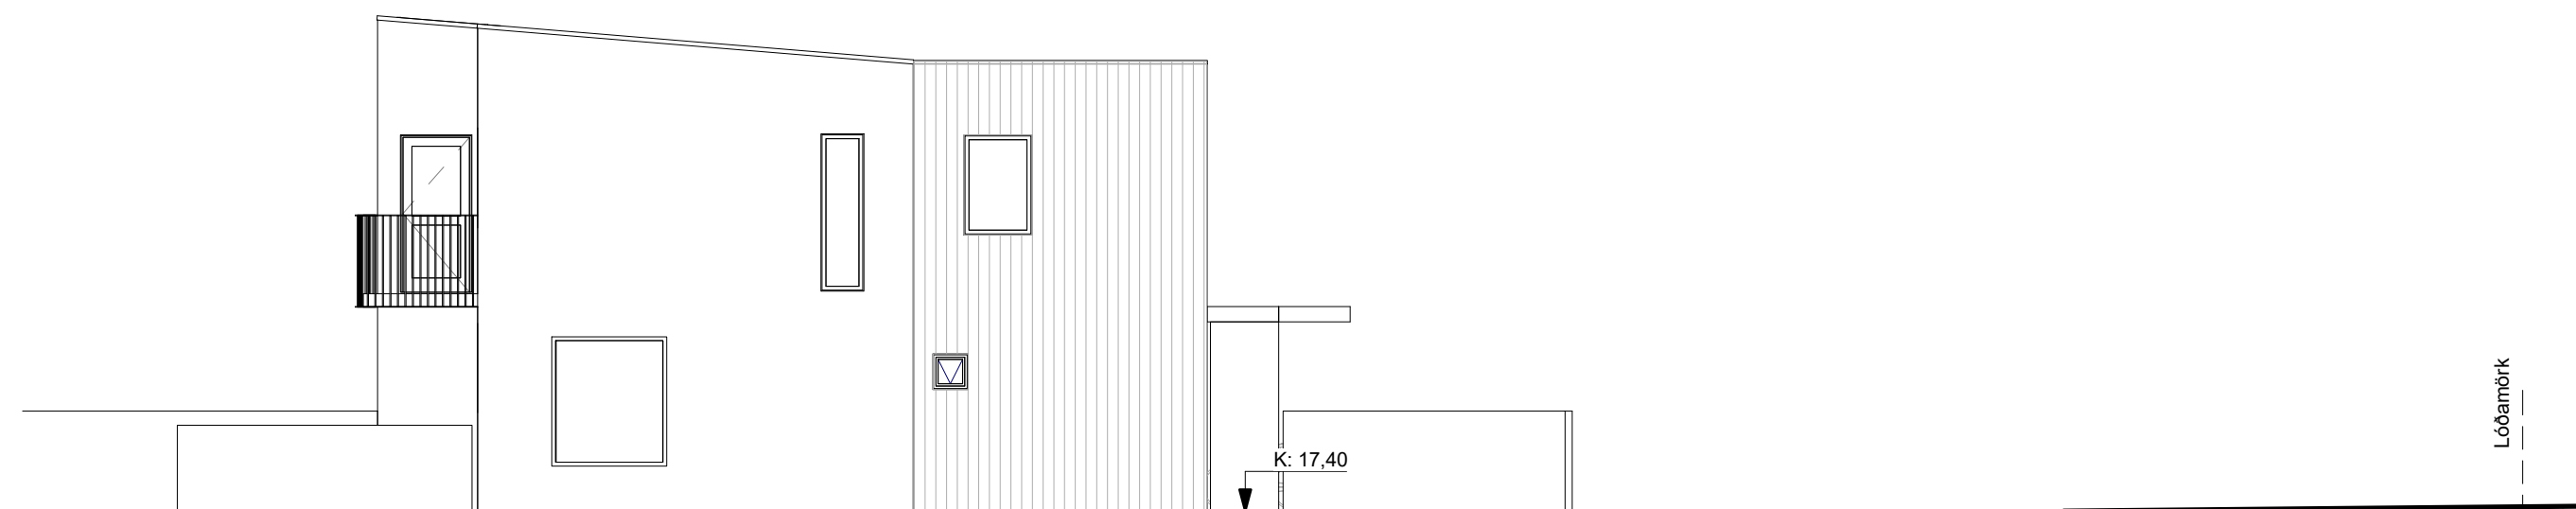

Suð-Austur (mhl 03)
1 : 100

ÚTGÁFA	DAGS	BREYTING	YFIRFARIÐ
--------	------	----------	-----------

ASK arkitektar ehf.
Geirsgötu 9 101 Reykjavík
Sími 515 0300 www.ask.is



ASK
ARKITEKTAR

ÁRITUN HÖNNUNAR ADALUPPDRA'TTA

Gunnar Örn Sigurðsson Arkitekt F.A.Í. Kt:130666-3379
gunnar@ask.is

VERKEFNI
Stekkjærberg 9

Hafnarfirði

TEGUND TEIKNINGAR
03-ADALTEIKNINGAR

HEITI TEIKNINGAR
Útlit (mhl 03)

MKV. I A2
1 : 100
HAMNAÐ
GÖS
TEIKNAD
GÖS/SLS
YFIRF.
SS
DAGS
18.08.2021
ÚTGÁFA

VERK NR. **1411** AUKENNÍ - NÚMER TEIKNINGAR **03-10-05**