

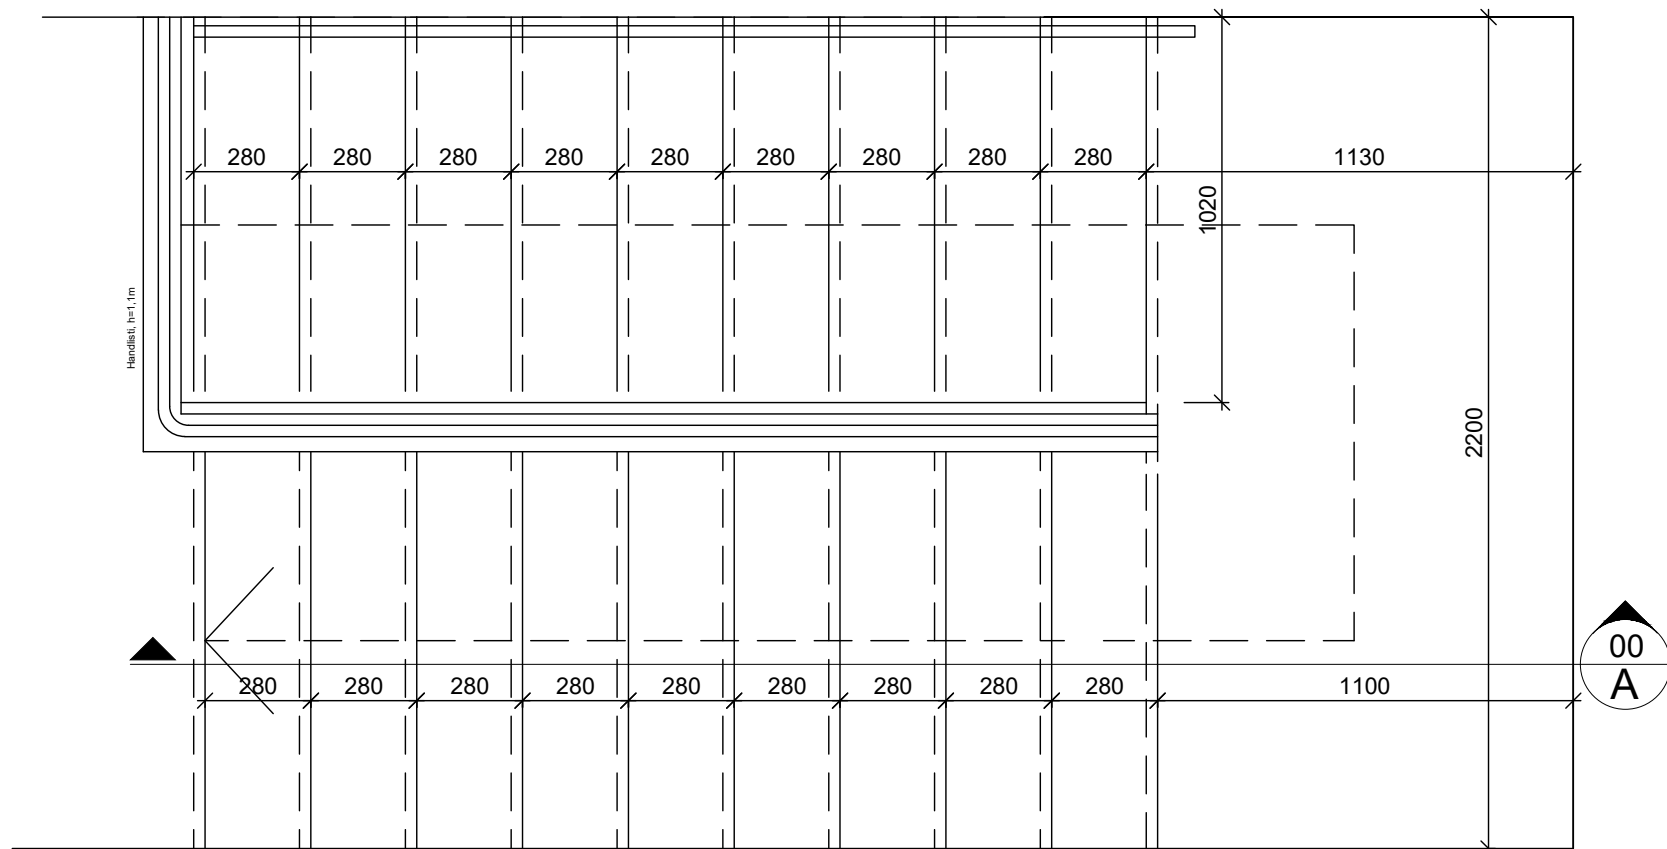


SNID A  
Mkv. 1/20 00

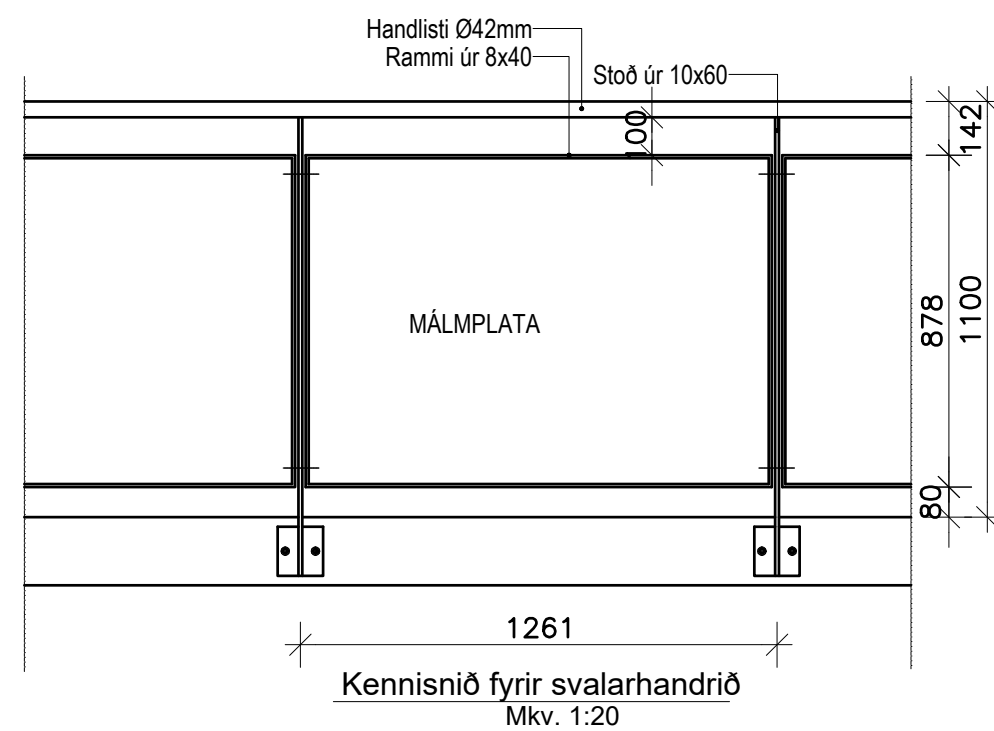

Grunnmynd stiga  
Mkv. 1:20

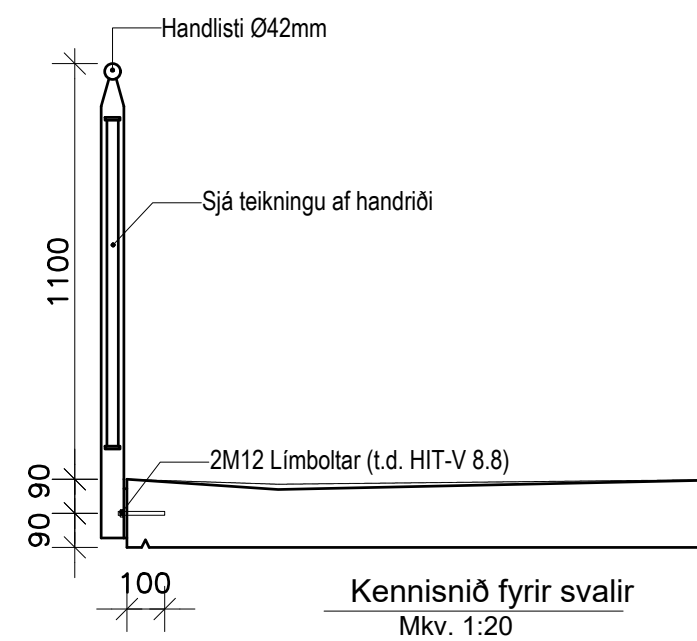

ÚTGÁFUFERILL			
NÚMER:	DAGS.	SKÝRINGAR:	UNNIÐ:
I	07.08.'24	REYNDARTEIKNINGAR	H.Á.
DAGS.	SAMRÆM.HÖNNUÐUR		
<p>Verkfræðistofa Hauks Ásgeirssonar</p> <p>SUÐURLANDSBRAUT 46 108 REYKJAVÍK SÍMI: 897 8132</p> <p>NETFANG: haukur@vha.is kt: 560600-3050</p>			
<p>HEITI VERKS:</p> <p><b>VÍKURGATA 11B</b> <b>HAFNARFIRÐI</b></p>			
<p>HEITI TEIKNINGAR:</p> <p><b>STIGI OG HANDRIÐ</b> <b>SVALAHANDRIÐ</b></p>			
MKV: 1:20	DAGS. NOV.'19	VERK NR 19-040	
TEIKNAD. H.Á.	YFIRFARID Í.H.	SAMPYKKT Í.H.	TEIKN.NÚMER 9
DAGS.undirskr. 07.08.2024	NAFN HÖNNUÐAR Ívar Hauksson kt: 110383-5339		
UNDIRSKR.HÖNNUÐAR			ÚTGÁFA I