
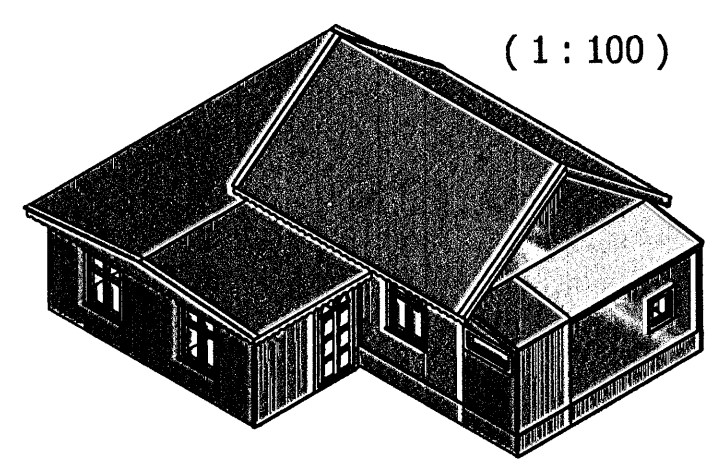
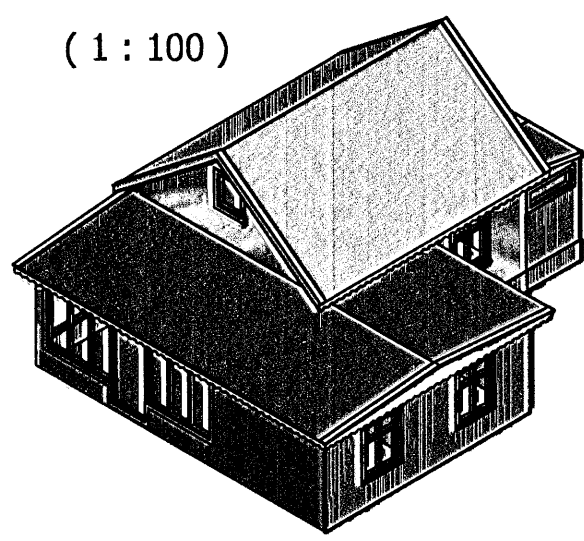
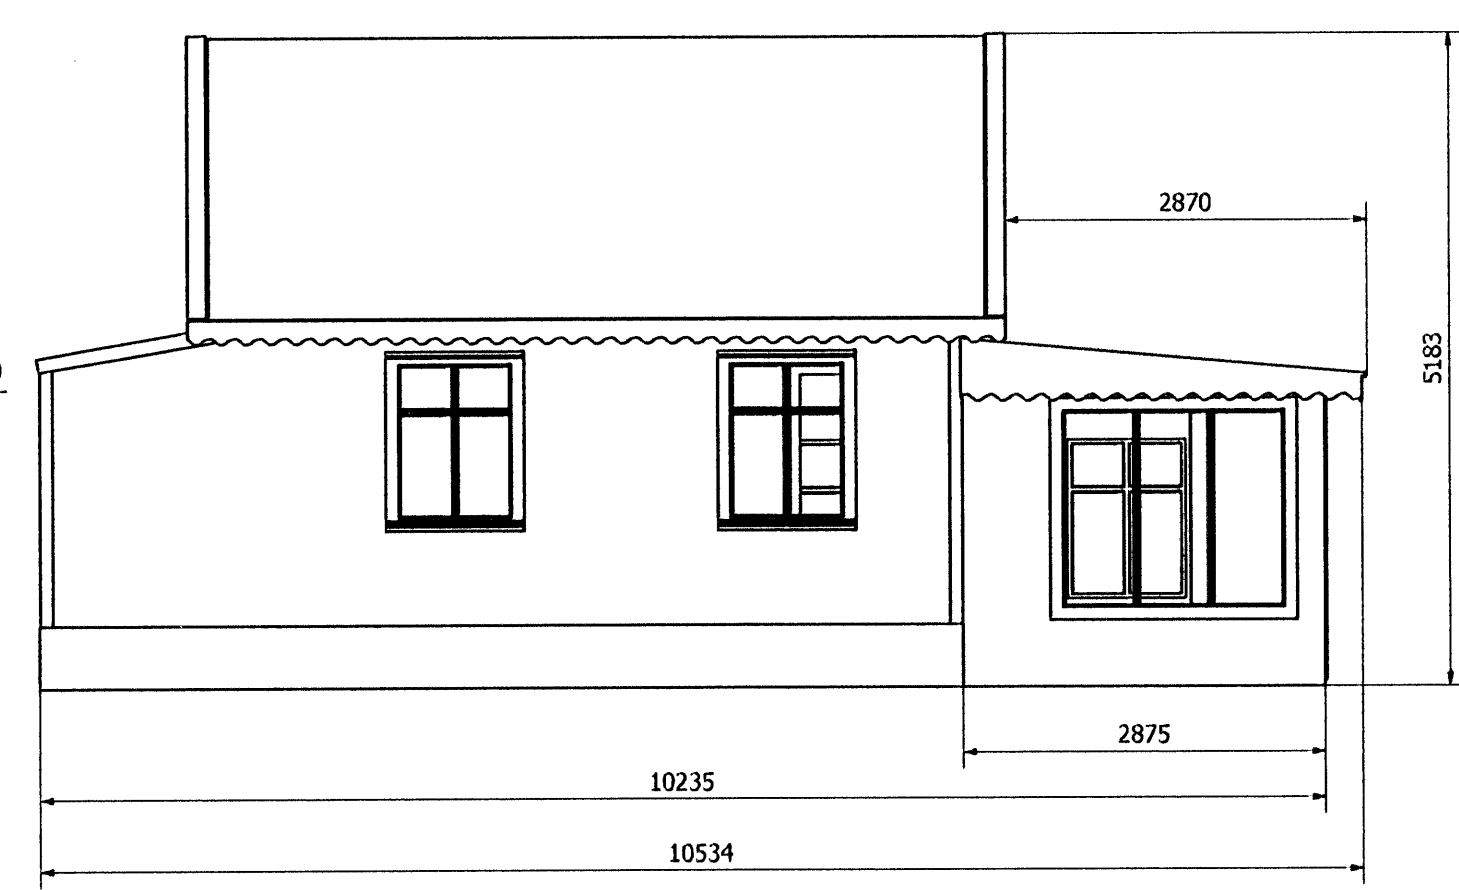
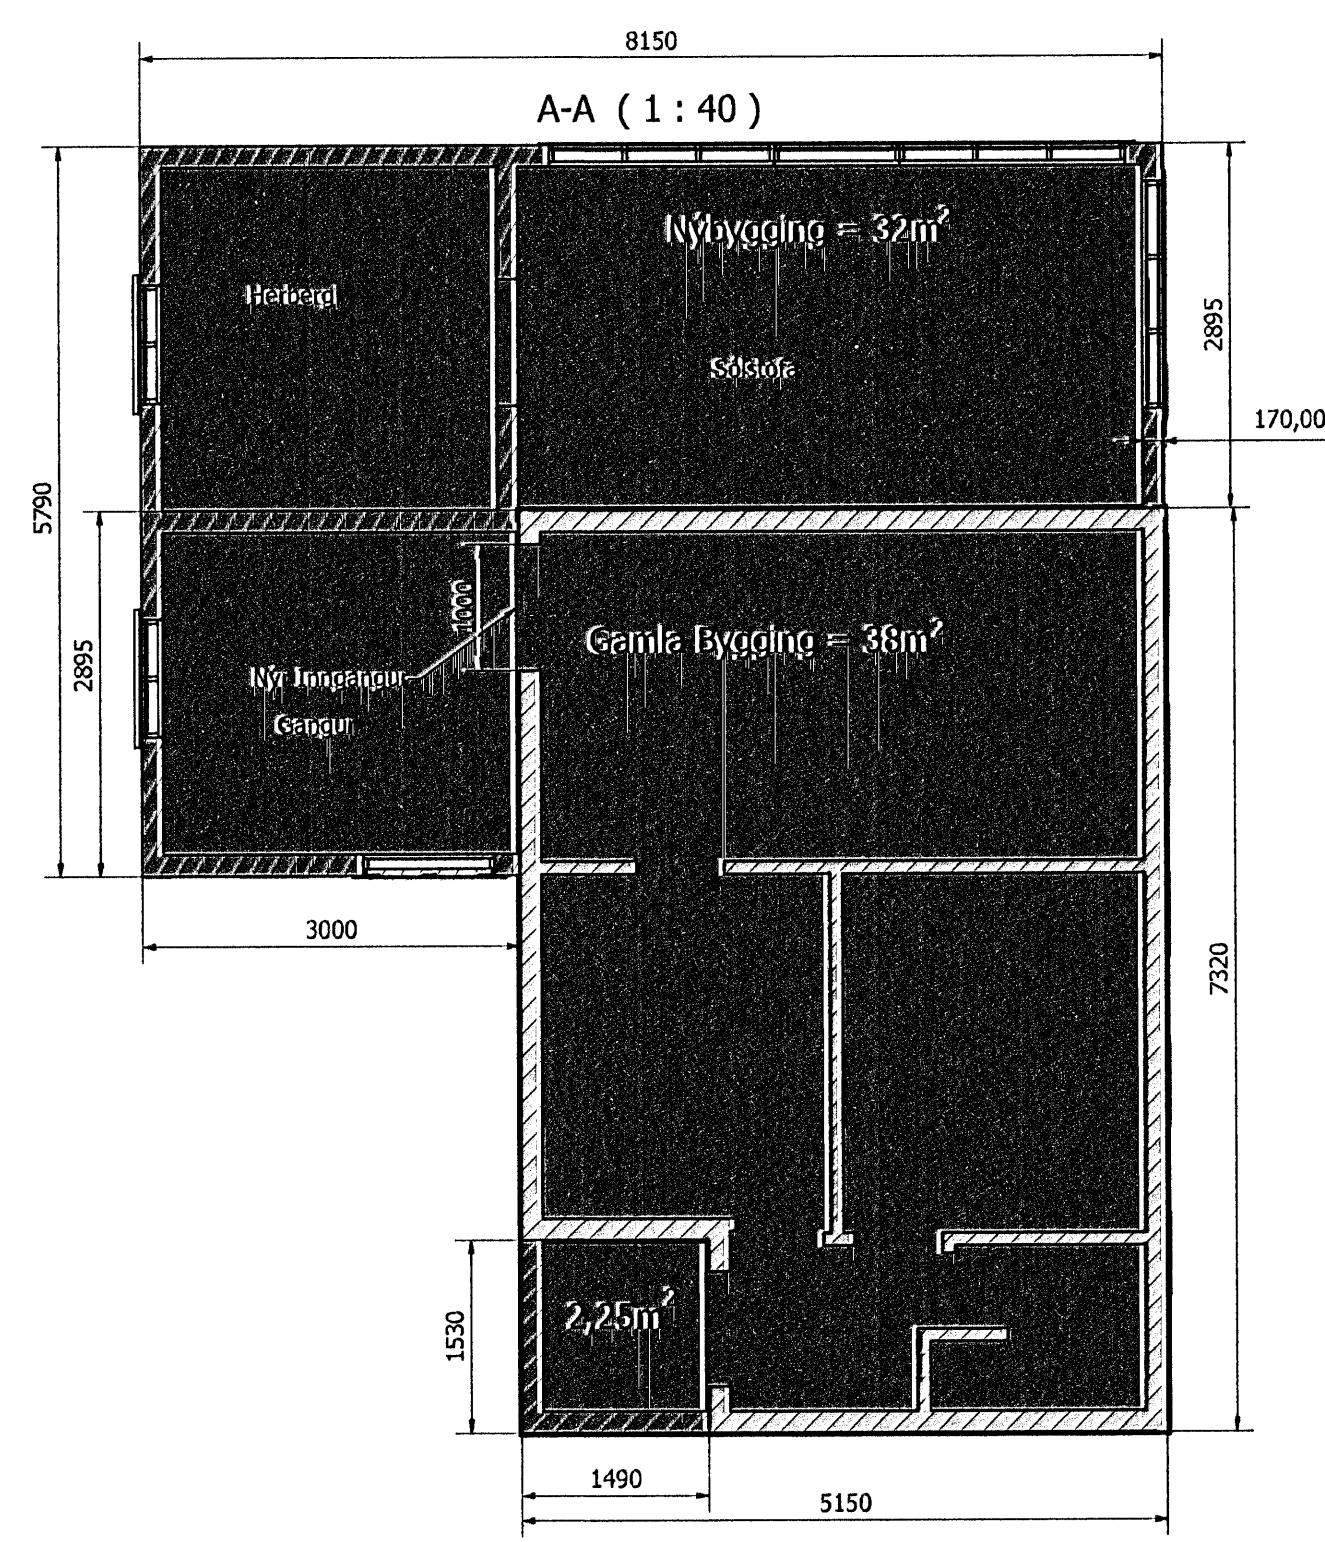
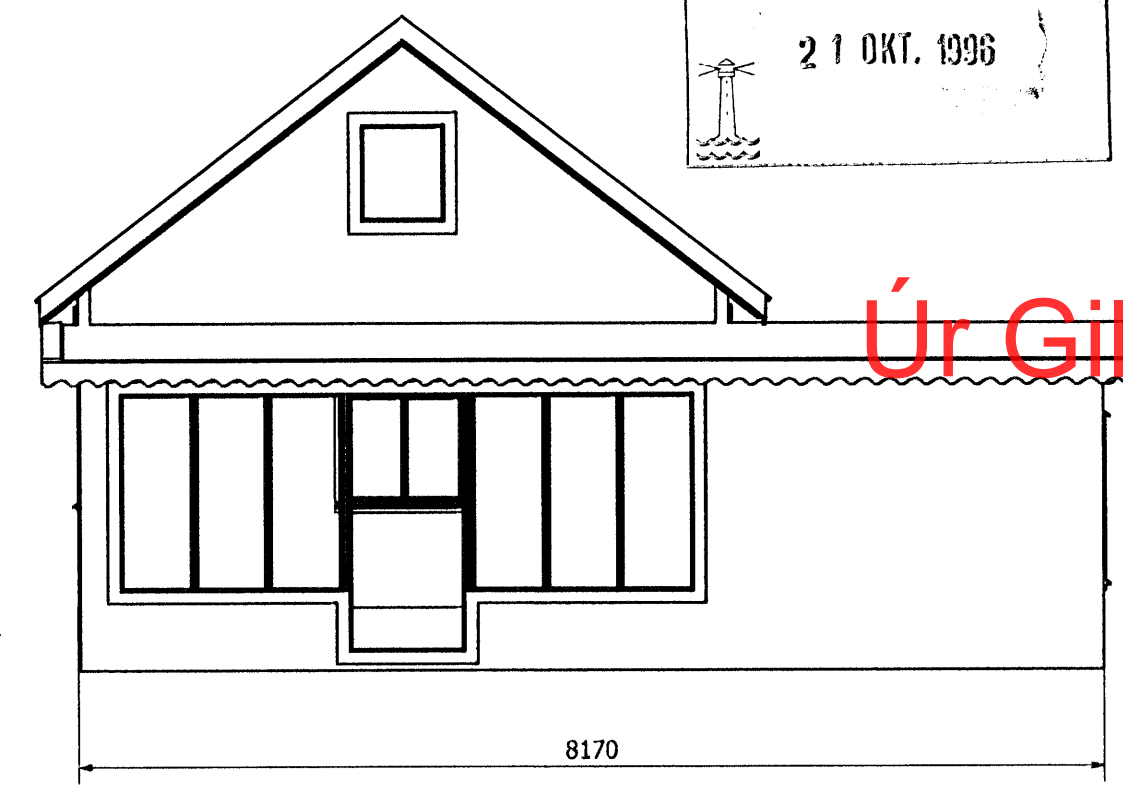
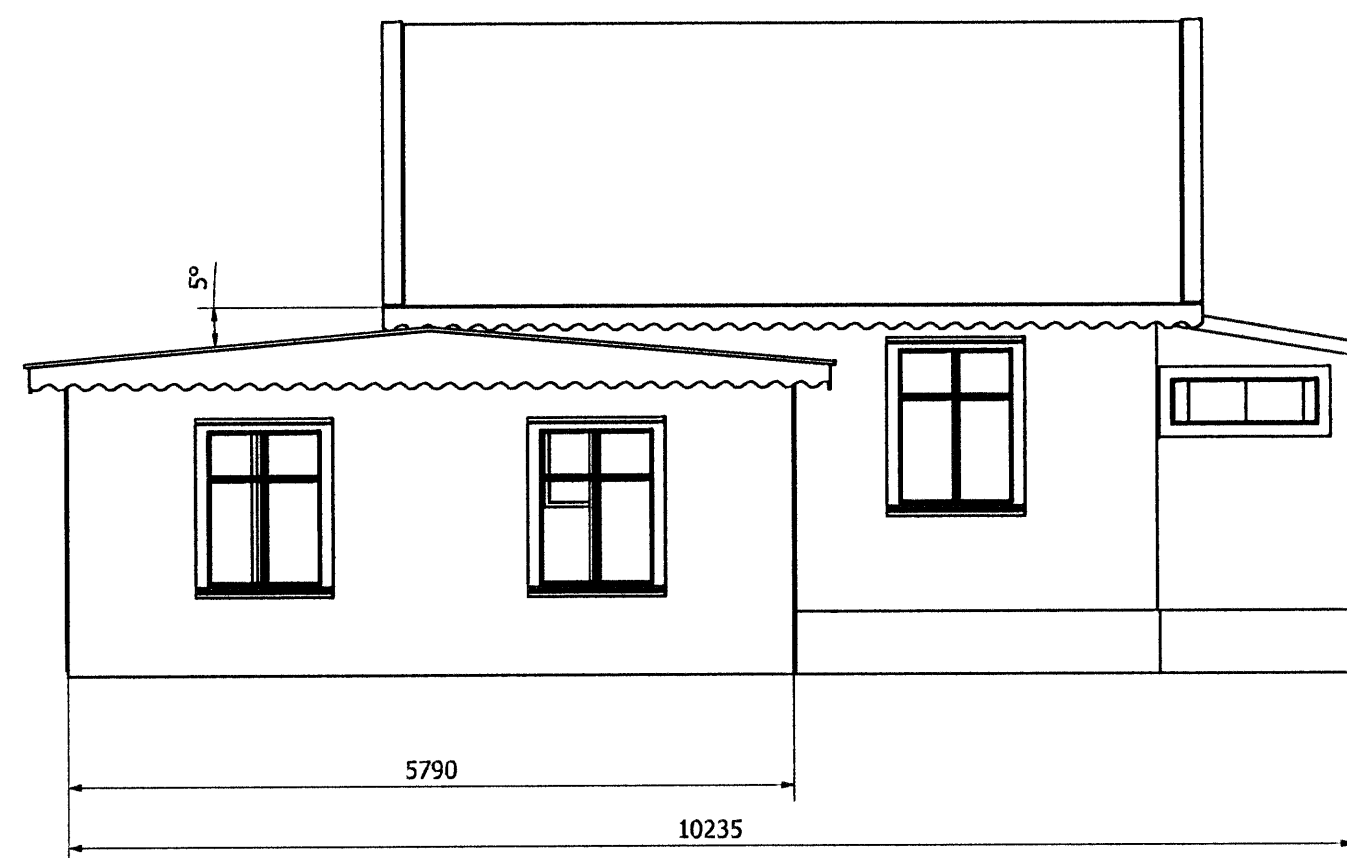


(1 : 40)

Synjað þann
21 OKT. 1996

Úr Gildi

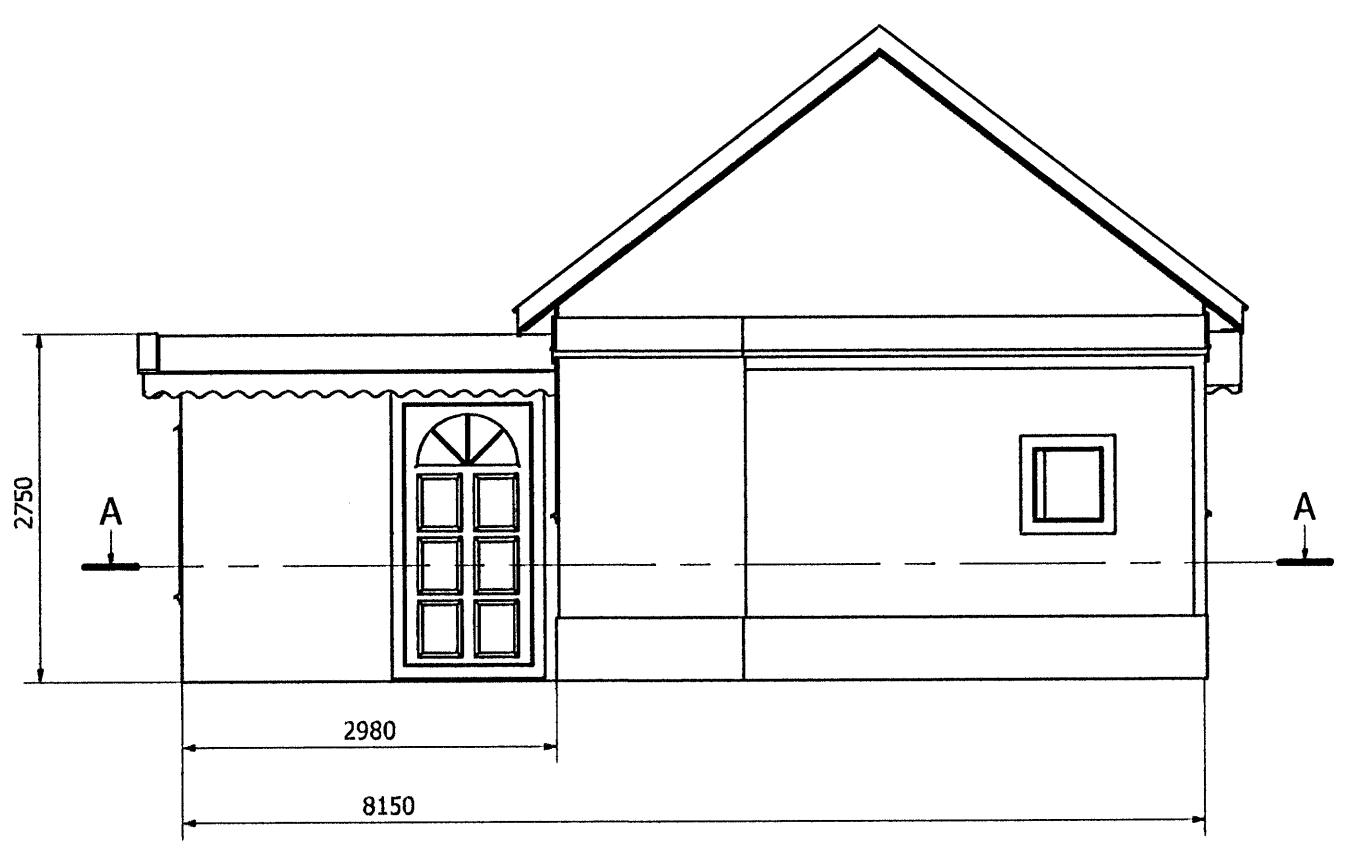

Designed by GH	Checked by GH	Date 28.05.2006	<i>Gestur Halldórsson</i> 2805542869	
Gestur Halldórsson GSM: 8496021 e-mail: gh@hive.is		Viðbygging Merkursgata 9B Hafnarfirði		Edition 1 Sheet 1 / 1