



SKÝRINGAR:

Sjá skýringar á teikningu B-00-11

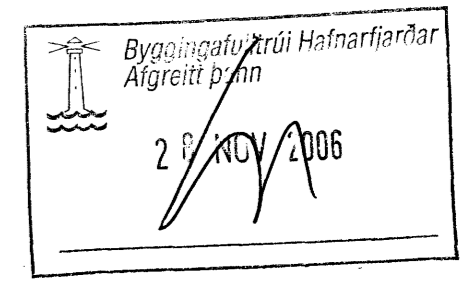

A	19.10.2006	SæJ	peL	GAM
Rauf fyrir stiga				
ÚTGAFA	DAGSETNING	TEIKNAD	YFIRFARID	SAMÞYKKT
EDLI Breytingar				

Lykilmynd

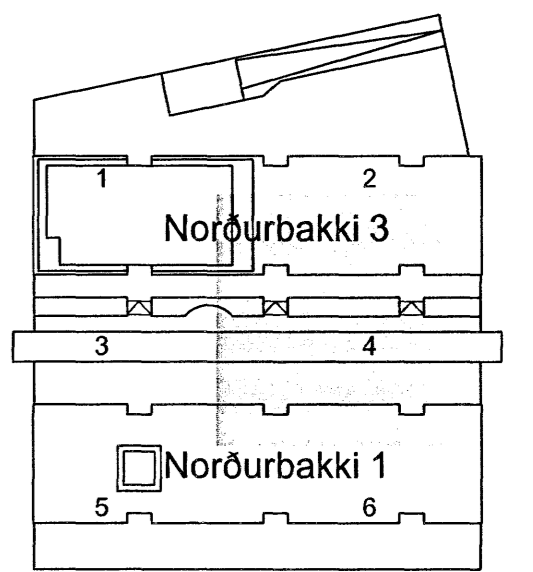

Sigr. Hólmgrímsson

HANNAD:	SæJ	DAGS:	16.05.2006
TEIKNAD:	SæJ/SI	KVARDI:	1:50
YFIRF.:	peL	VERK NR.:	5275
SKRÁ:	b-00-10.dwg	TEIKN NR.:	B-00-14
SAMP.:			090954-2459

**FRUMSTÆRÐ BLADS A1
BLADSTÆRÐ A3, MINNKUN 1:2**

Norðurbakki 1 og 3

Burðarvirki
Undirstöður – Botnplata
Grunnmynd 4

FJARHITUN HF
VERKFRÆÐISTOFA

SUDURLANDSBRÁUT 4 108 REYKJAVÍK NETFANG: fjarhitun@fjarhitun.is
SÍMI 578 4500 – FAX 578 4599 VEFSIDA: www.fjarhitun.is
KENNITALA: 700186-1649