




Bill of material for 1 Shop - POS. 1101 total 4 X done

No.	Qty	pos.	designation	city	part#	quality	length	weight	item
1	1	II	1101	FLANGER	S205.ER3	200	9.2		
2	2	II	1101	SCREW M8	S205.ER3	80	19.42		
3	1	II	1101	FLANGER	S205.ER3	45	38.30		
total weight kg									67.64
Shipping dimensions 01 x B x L3 218 x 465 x 893									

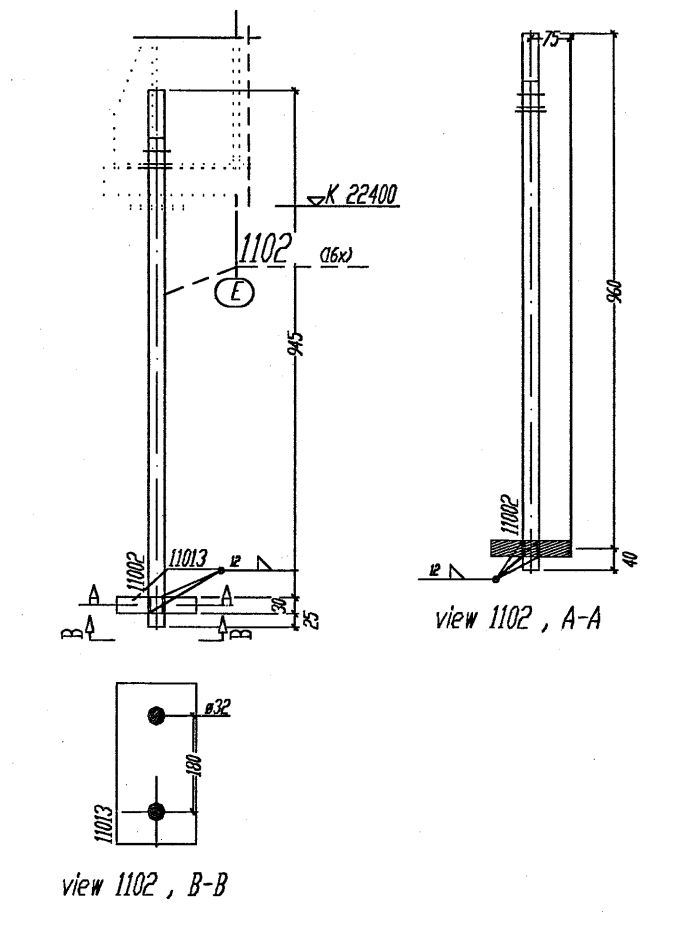


Bill of material for 1 Shop - POS. 1102 total 16 X done

No.	Qty	pos.	designation	city	part#	quality	length	weight	item
1	1	II	1102	SCREW M8	S205.ER3	100	5.53		
2	2	II	1102	SCREW M8	S205.ER3	100	5.53		
3	1	II	1102	FLANGER	S205.ER3	300	10.62		
total weight kg									21.77
Shipping dimensions 01 x B x L3 158 x 300 x 1000									

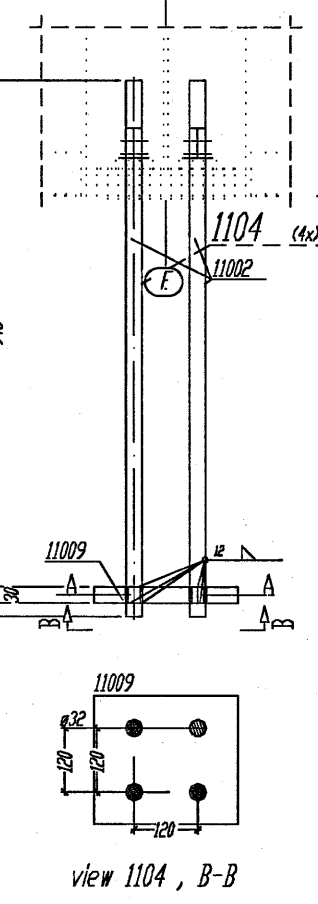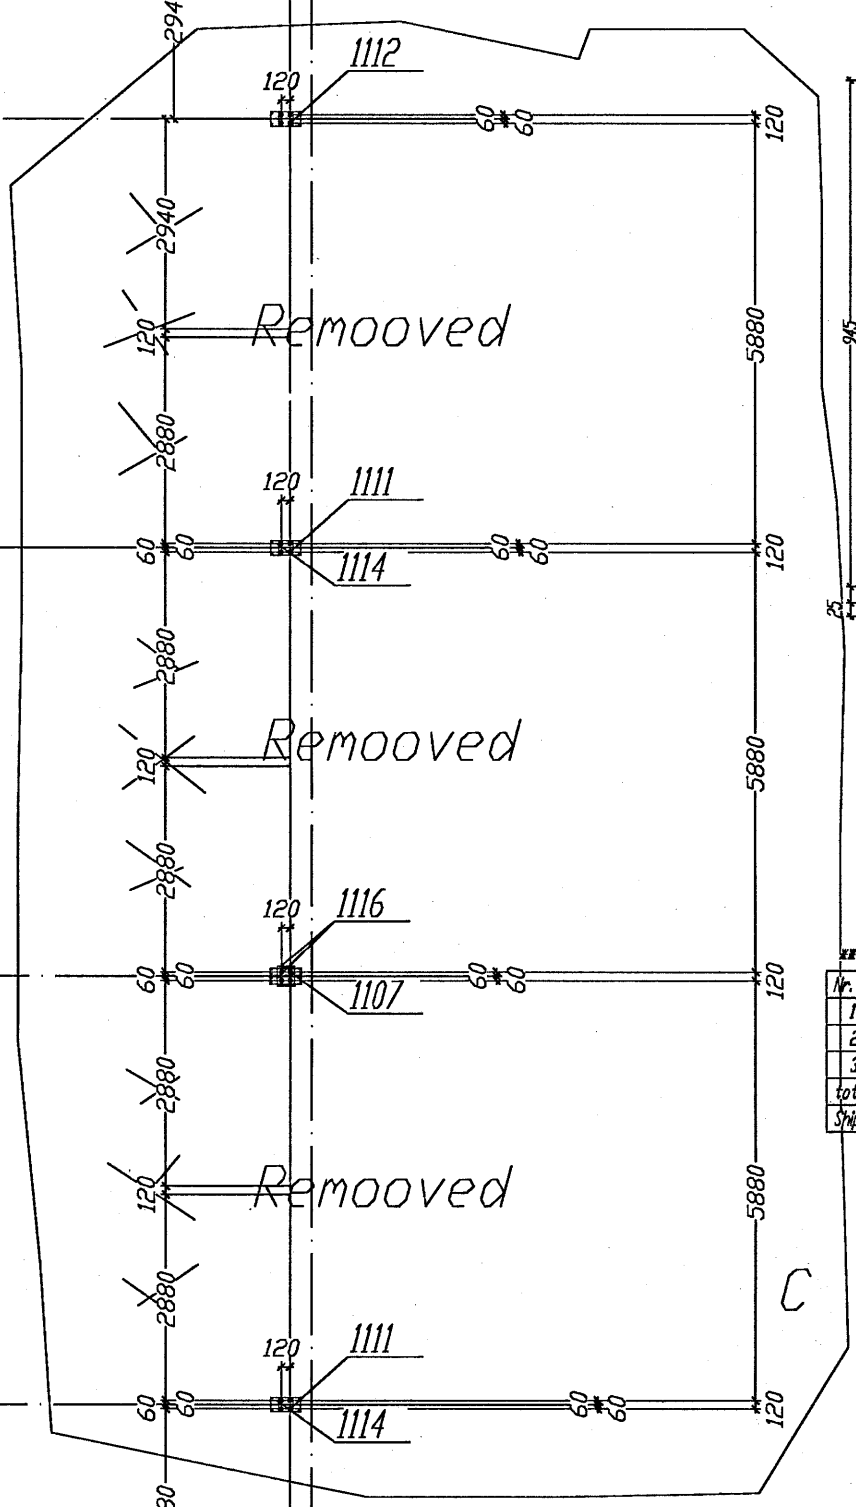

Bill of material for 1 Shop - POS. 1104 total 4 X done

No.	Qty	pos.	designation	city	part#	quality	length	weight	item
1	1	II	1104	SCREW M8	S205.ER3	100	5.53		
2	1	II	1104	SCREW M8	S205.ER3	100	16.52		
3	1	II	1104	FLANGER	S205.ER3	240	15.24		
total weight kg									37.43
Shipping dimensions 01 x B x L3 278 x 240 x 1000									

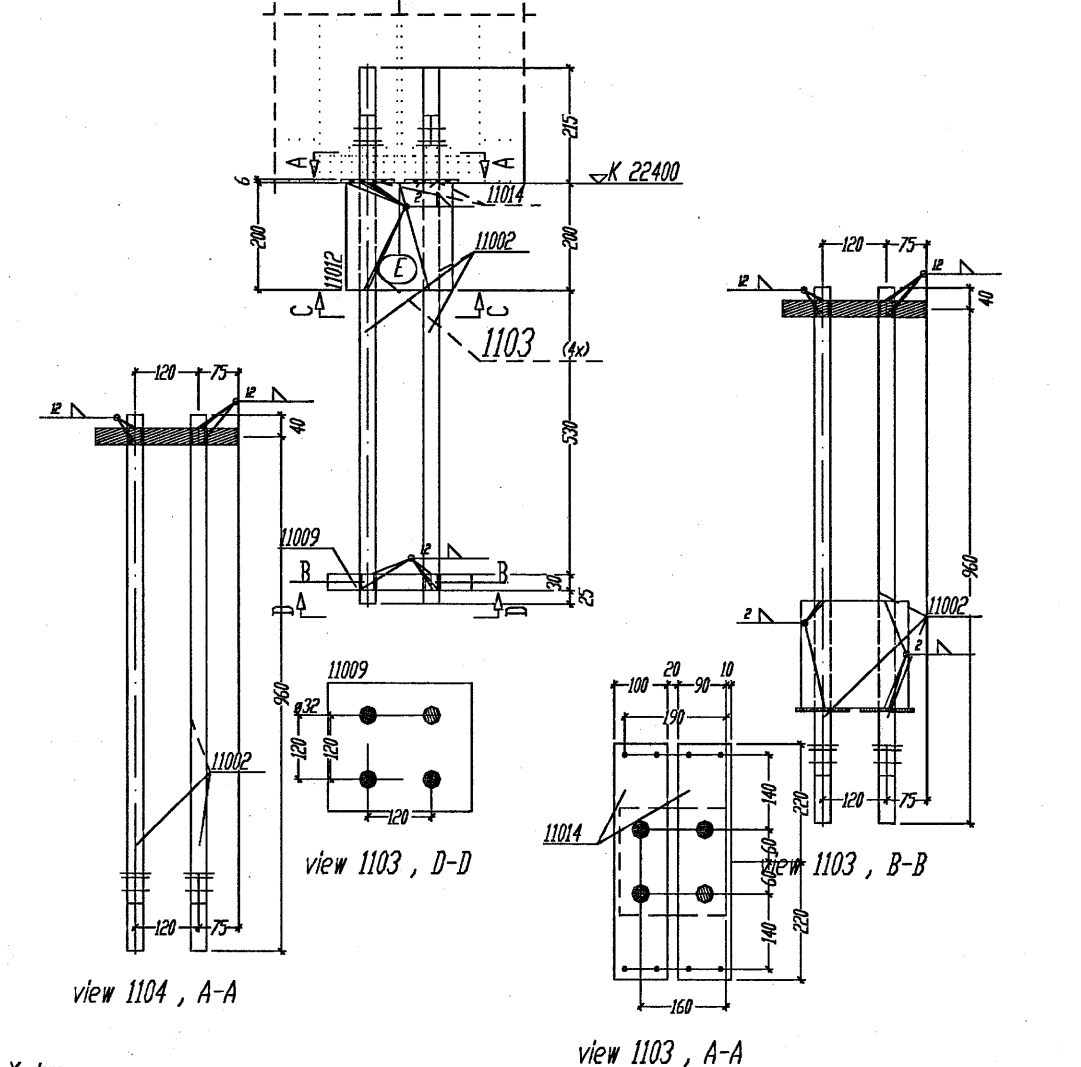

Bill of material for 1 Shop - POS. 1103 total 4 X done

No.	Qty	pos.	designation	city	part#	quality	length	weight	item
1	1	II	1103	SCREW M8	S205.ER3	100	5.53		
2	1	II	1103	SCREW M8	S205.ER3	100	16.52		
3	1	II	1103	FLANGER	S205.ER3	240	15.24		
4	1	II	1103	FLANGER	S205.ER3	280	8.7		
5	1	II	1103	FLANGER	S205.ER3	440	4.74		
total weight kg									47.73
Shipping dimensions 01 x B x L3 278 x 440 x 1000									

Samykkt þann  
07 AUG. 2007  
Byggingufulltrúinn í Hafnarfirði  
F.h. Sigurbjartur Halldórsson

Fyrir hönd Confs ehf. kt. 600105-1400  
staðfestist að teikning þessi hefur verið  
yfirlit. Teikningin er í samræmi við  
íslenska staða og reglugerðir. 7/6 07

*[Signature]* 130657-4475  
Nafn Kennitala

Look also on drgno 1002b

Tolerance for welded constructions according to DIN 8570, Pt.1+2+3+4, 10.87

Welding (V.P.S.) according to DIN EN 288 - 2

Required torques, prestressing forces and forced tension angles according to DIN 18810 Pt. 7, 10.83


The material for cap plates X30 mm thick to be exorb for laminations

BIURO INZYNIERSKIE Marek i Janina MUCHA  
Osiny, ul. Opolska 30a, 46-070 Komprachcice tel.077-46 46 757

DATE	NAME	SIGNATURE	JOB SCALE
2007.08.07	MUCHA	<i>[Signature]</i>	

Pos. 1101-1105  
TJARNARVELLIR 11  
FUNDAMENT BOLTAR  
1001 c

Bill of material for 1 Shop - POS. 1105 total 3 X done

No.	Qty	pos.	designation	city	part#	quality	length	weight	item
1	1	II	1105	SCREW M8	S205.ER3	80	4.2		
2	1	II	1105	SCREW M8	S205.ER3	80	14.15		
3	1	II	1105	FLANGER	S205.ER3	240	21.69		
4	1	II	1105	FLANGER	S205.ER3	190	2.91		
total weight kg									43.94
Shipping dimensions 01 x B x L3 278 x 340 x 890									