


Snið í útbyggðan glugga
1 = 50 mm

Tengikista 1 í kjallara

Slanga 1	L=~102 m
" 2	L=~ 98 m
" 3	L=~115 m
" 4	L=~109 m
" 5	L=~104 m
" 6	L=~105 m
" 7	L=~105 m
" 8	L=~112 m
" 9	L=~108 m
" 10	L=~110 m
" 11	L=~ 98 m
" 12	L=~106 m
" 13	L=~104 m
" 14	L=~ 97 m
" 15	L=~ 99 m
" 16	L=~101 m
" 17	L=~113 m
" 18	L=~114 m
" 19	L=~113 m
" 20	L=~106 m
" 21	L=~112 m

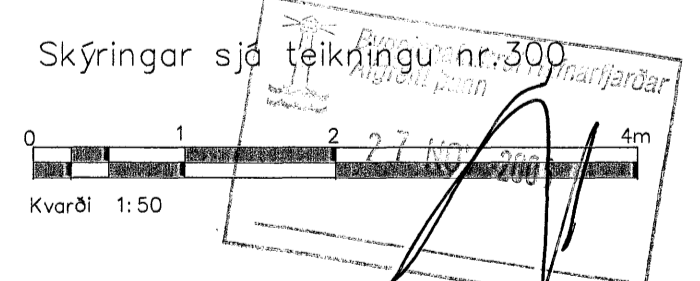

B	Silögum 11 og 12 í kistu 2 batt við	SG	02.11.06	
A	Legu lagna og snið í glugga batt við	SG	01.11.06	
Ölg.	Nr.	Þreytingar	Háttmálur	Daga

Verkteikning

Ásvellir 2 – Sundmiðstöð Hafnarfjarðar

Strendingur ehf. Verkfæðisjónusta
Fjarlægata 13-B - 220 Hafnarfjarður
Sími 565 2446, Fax 565 2441

Gólfhitalagnir
Grunnmynd 1. hæð – A

Daga: sept. 2006
Telning / Hornstaf: JW/SG

Malkostur: 1:50
Númer teikningar: 380
Blátt: B