
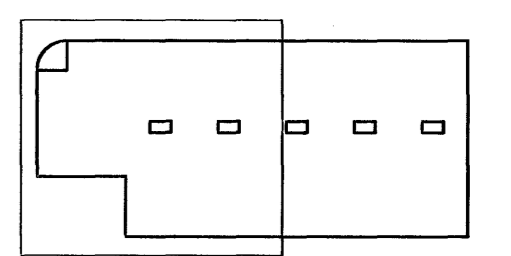


Byggingafultrúi Hafnarfjarðar
 Afgreitt þann
 17 AUG 2007
 G.G.

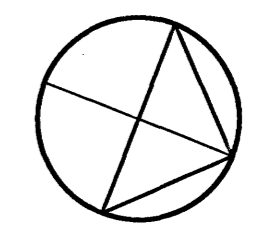

BREYTINGAR			
NR.	DAGS.	BREYTING	SP.
01	08.08.07	Lofaplani breytt til samr. við grunnmynd	

TEKTON

HÖNNUN - SKIPULAG - RÁÐGJÖF

HÁTEIGSVEGUR 7 TEL: +354 561 1910
 105 REYKJAVÍK FAX: +354 561 1921
 ICELAND TEKTON@TEKTON.IS
 KT: 471293-2109 WWW.TEKTON.IS

HAUKUR HÁRDARSON ARKIT. FAI / FSSA KT: 221162-2269
 GUDM. HUGI GUDMUNDSSON KT: 211068-5129
 GUNNLAUGUR JÓNÁSSON ARKIT. KT: 090462-2299
 ÞORLEIFUR EGGERTSSON ARKIT. KT: 040803-4849

SAMÞYKKT
 VERK
 HRADFLUTNINGAR / FEDEX
 SELHELLA 9

TEIKNING
 GRUNNMÝND 2 H/ÆD

KVAFDI
 1:50

DAGS.
 29.01.2007
 TEIKNAD AF
 GJ, ÞE

TEIKNING NR.

A0210