
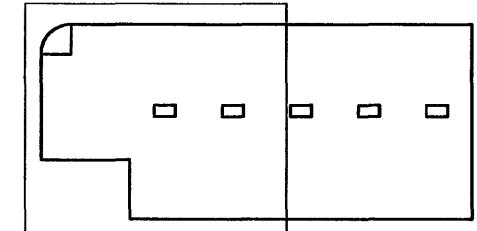


Byggingafræðingur
Algræitt þann
17 AUG 2007
G. G.

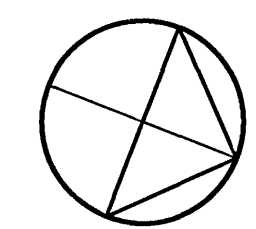

BREYTINGAR	NR.	DAGS.	BREYTING	SP.
	01	08.08.07	Fyrirkomulagi skrifstofa breytt	

TEKTON

HÖNNUN - SKIPULAG - RÁÐGJÖF

HÁTEIGSVEGUR 7 TEL: +354 561 1910
105 REYKJAVÍK FAX: +354 561 1921
ICELAND TEKTON@TEKTON.IS
KT: 471293-2109 WWW.TEKTON.IS

HAUKUR HÁRDARSON ARKIT. FAI / FSSA KT: 221162-2269
GUDM. HUGI GUDMUNDSSON KT: 211066-5129
GUNNLAUGUR JÓNASSON ARKIT. KT: 090462-2299
ÞORLEIFUR EGGERTSSON ARKIT. KT: 040603-4849

SAMÞYKKT
VERK
HRAÐFLUTNINGAR / FEDEX
SELHELLA 9

TEIKNING
LOFTAPLAN 2 HÆD

KVARDI
1:50