




P-1
6 stk.

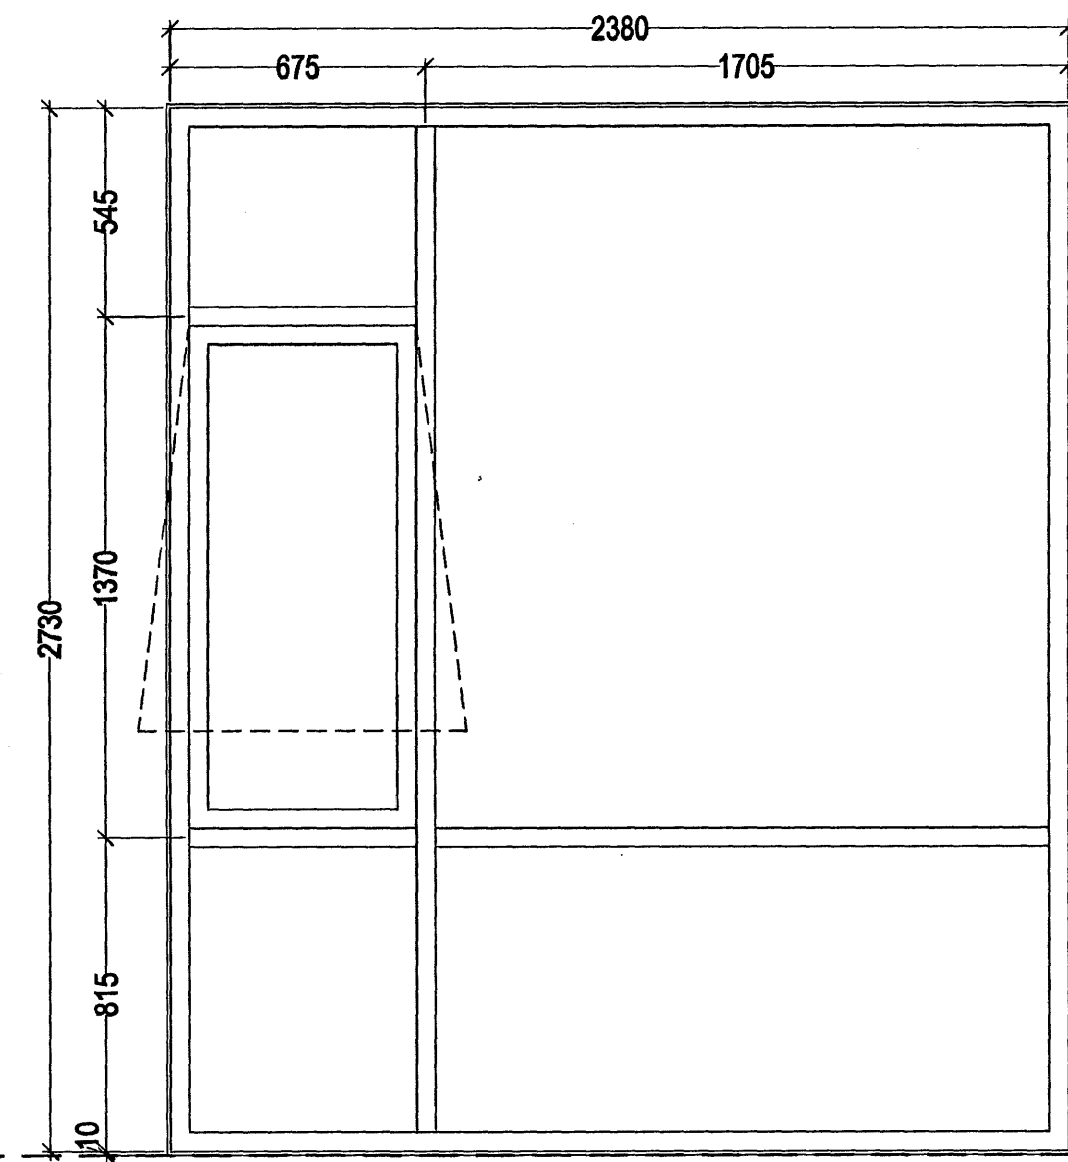


Æ-1
5 stk.

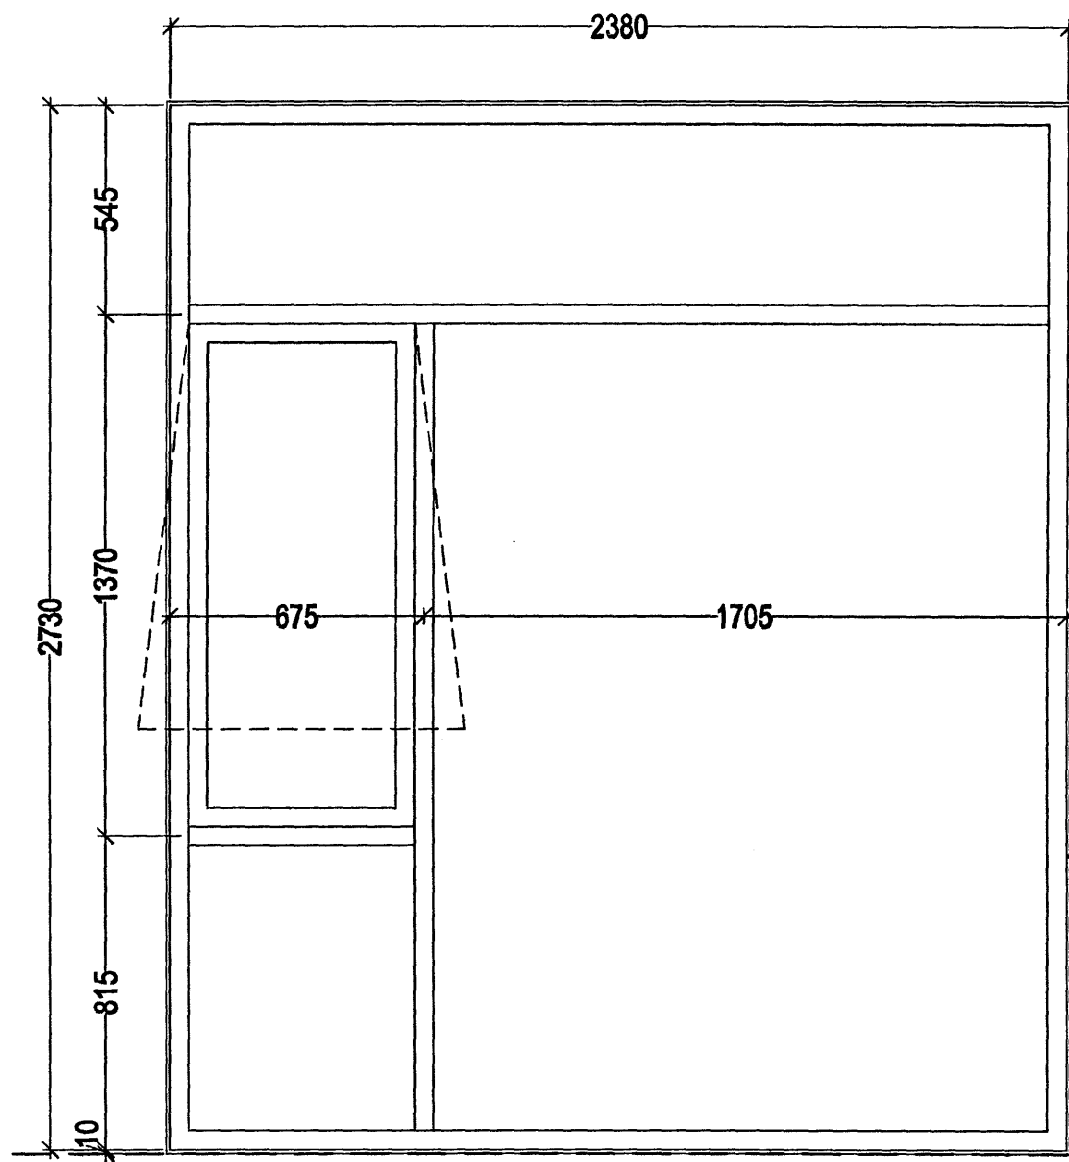


Æ-2
1 stk.

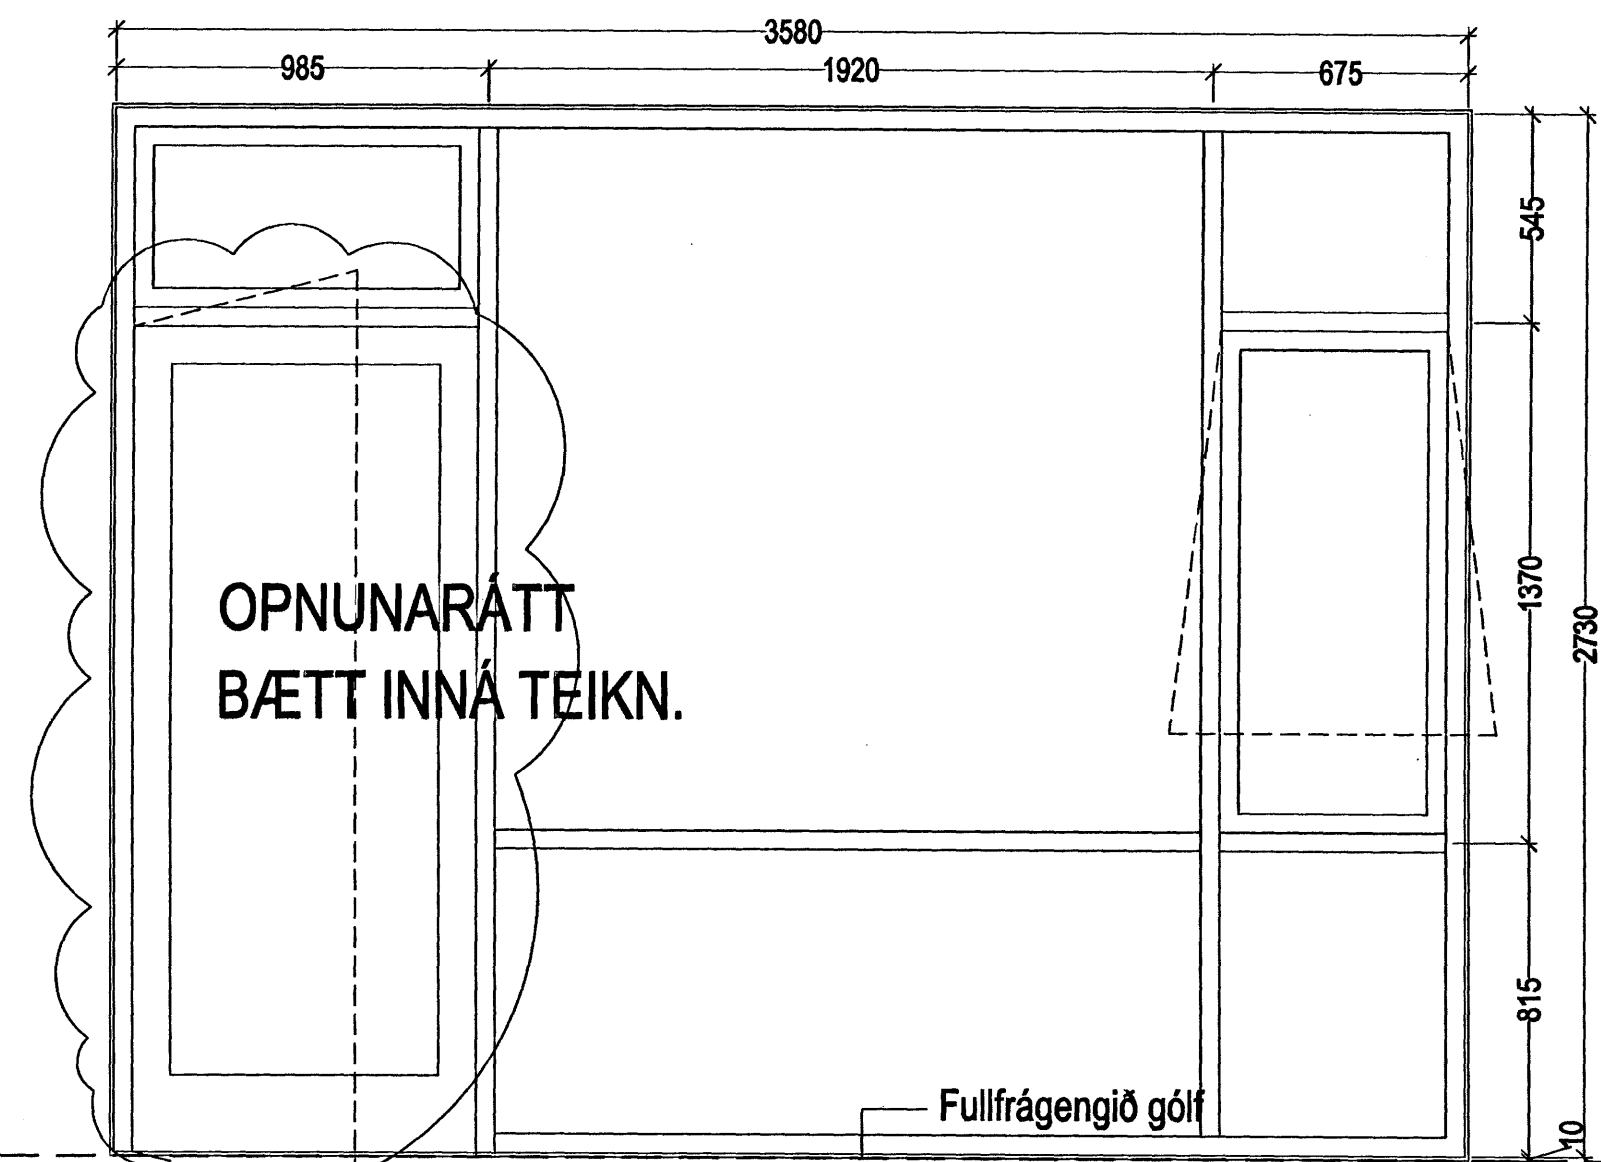


Ó-1
1 stk.

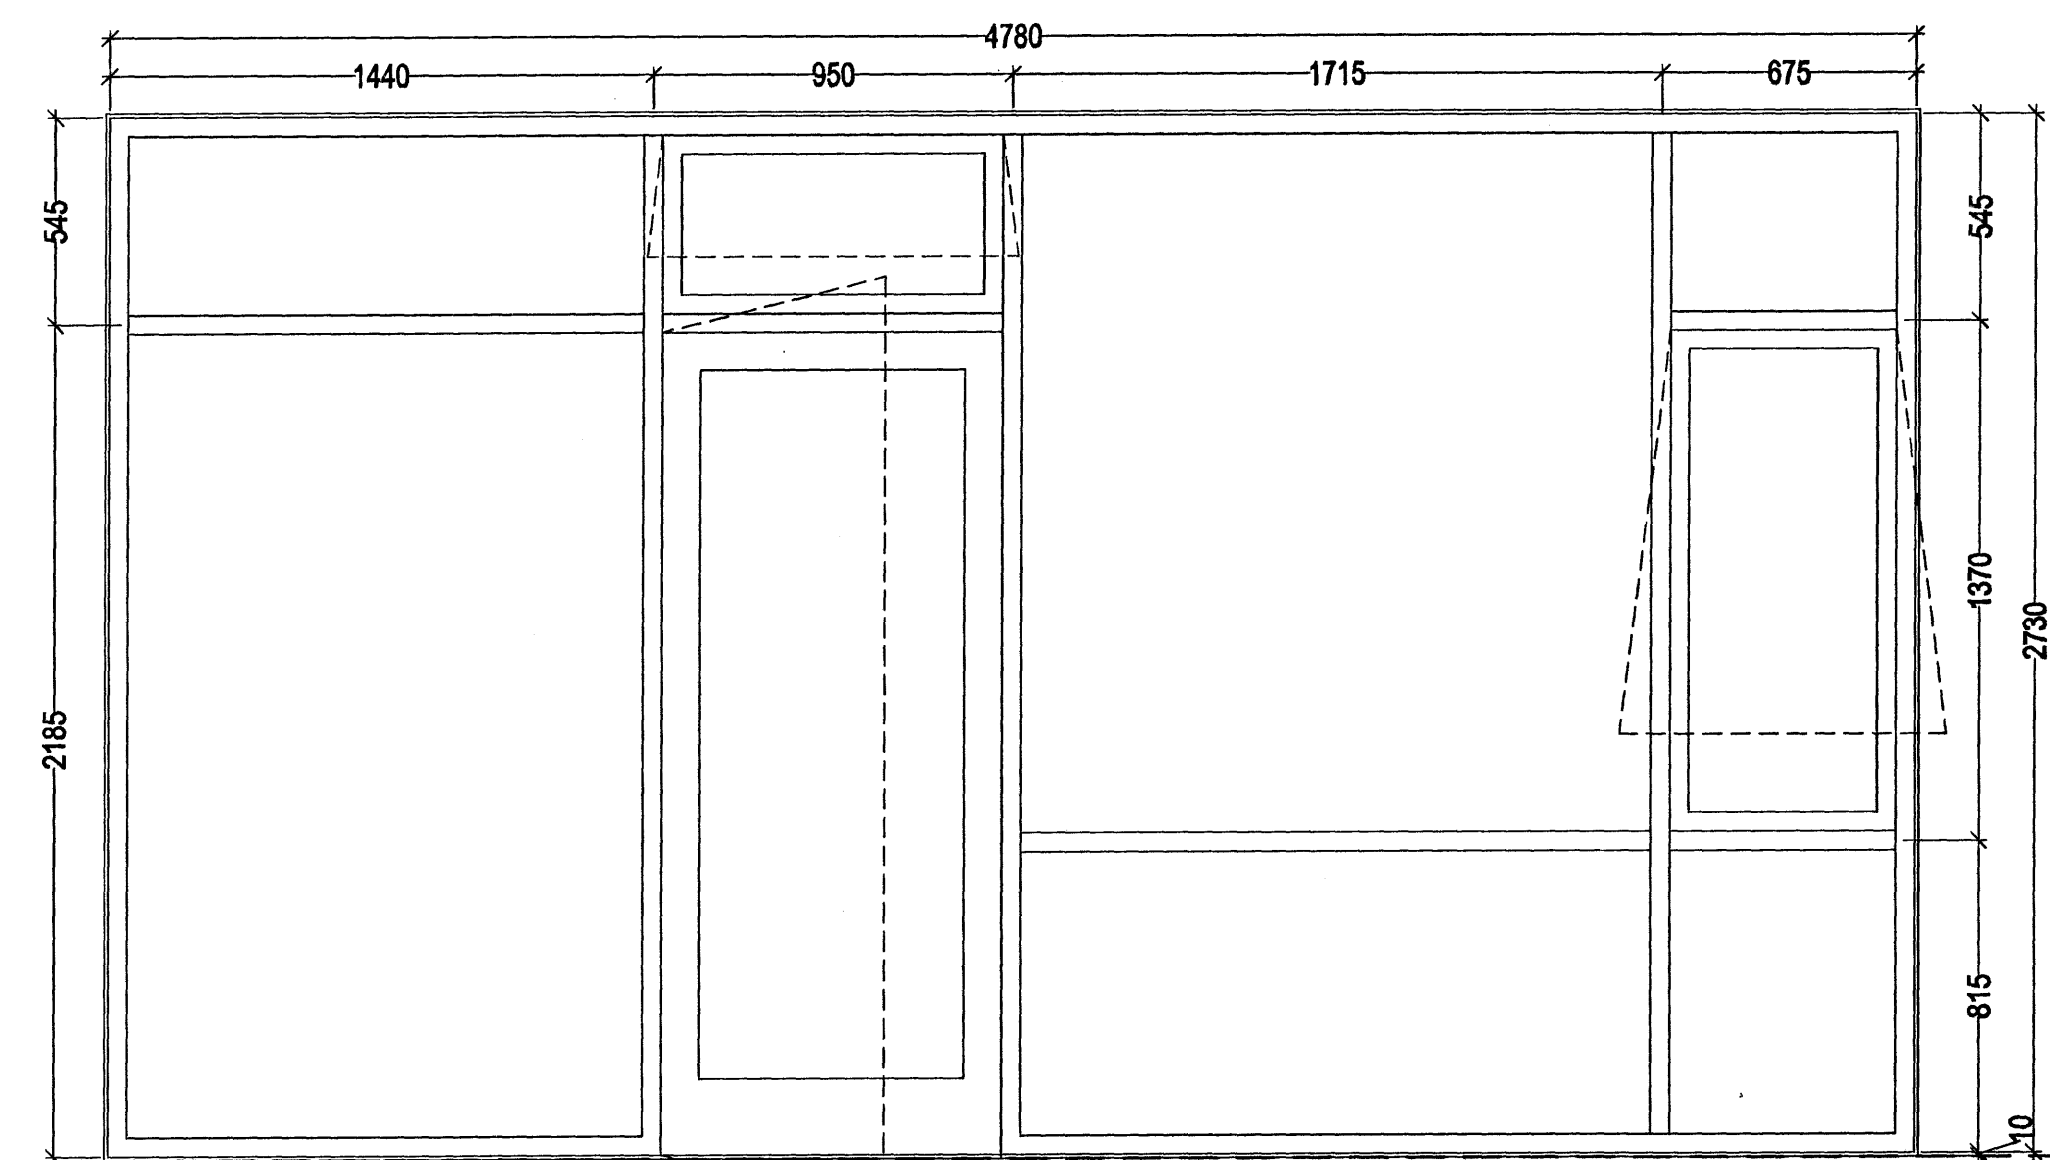


AA-1
3 stk.

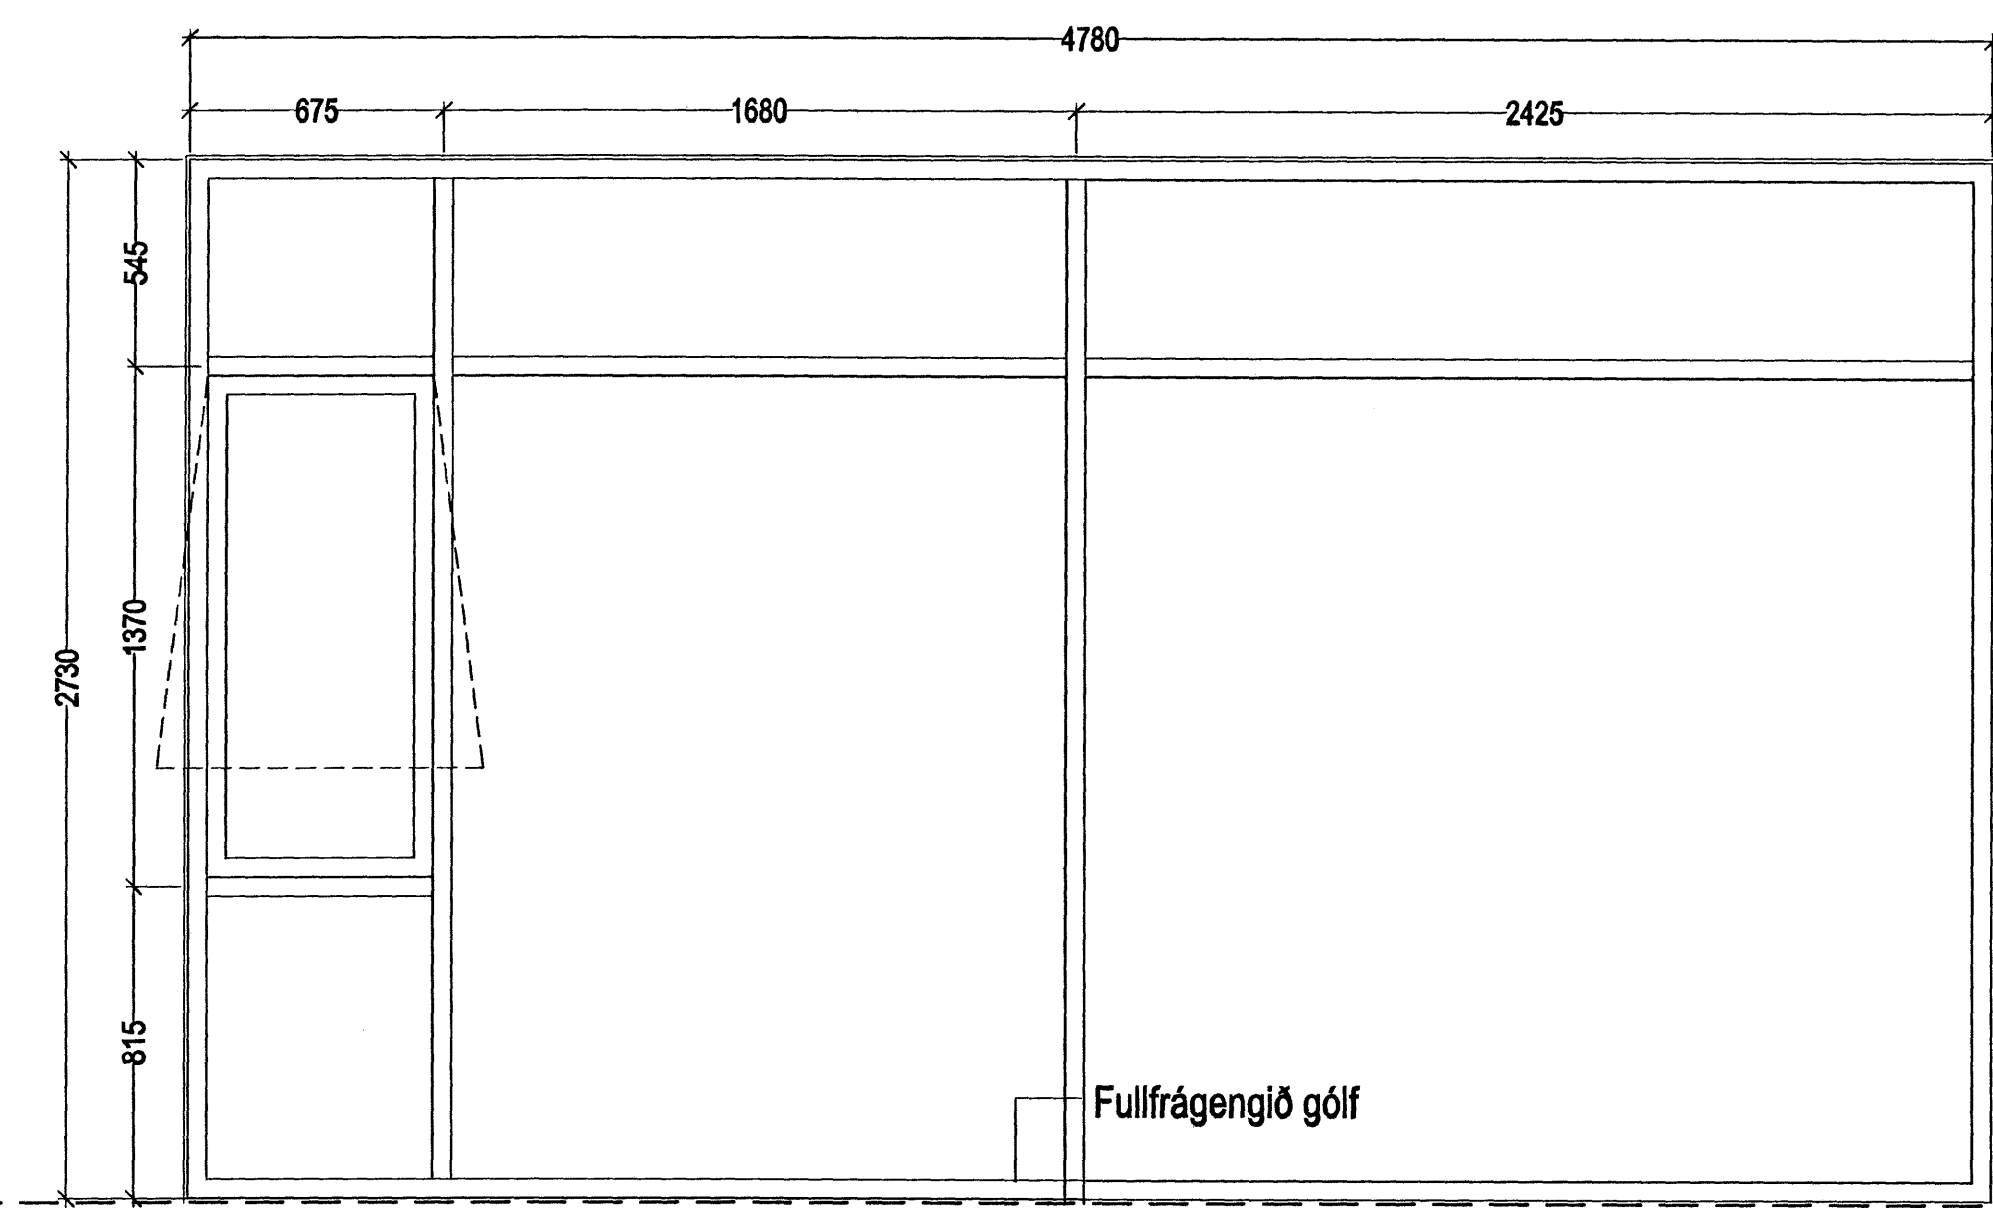


AA-4
1 stk.

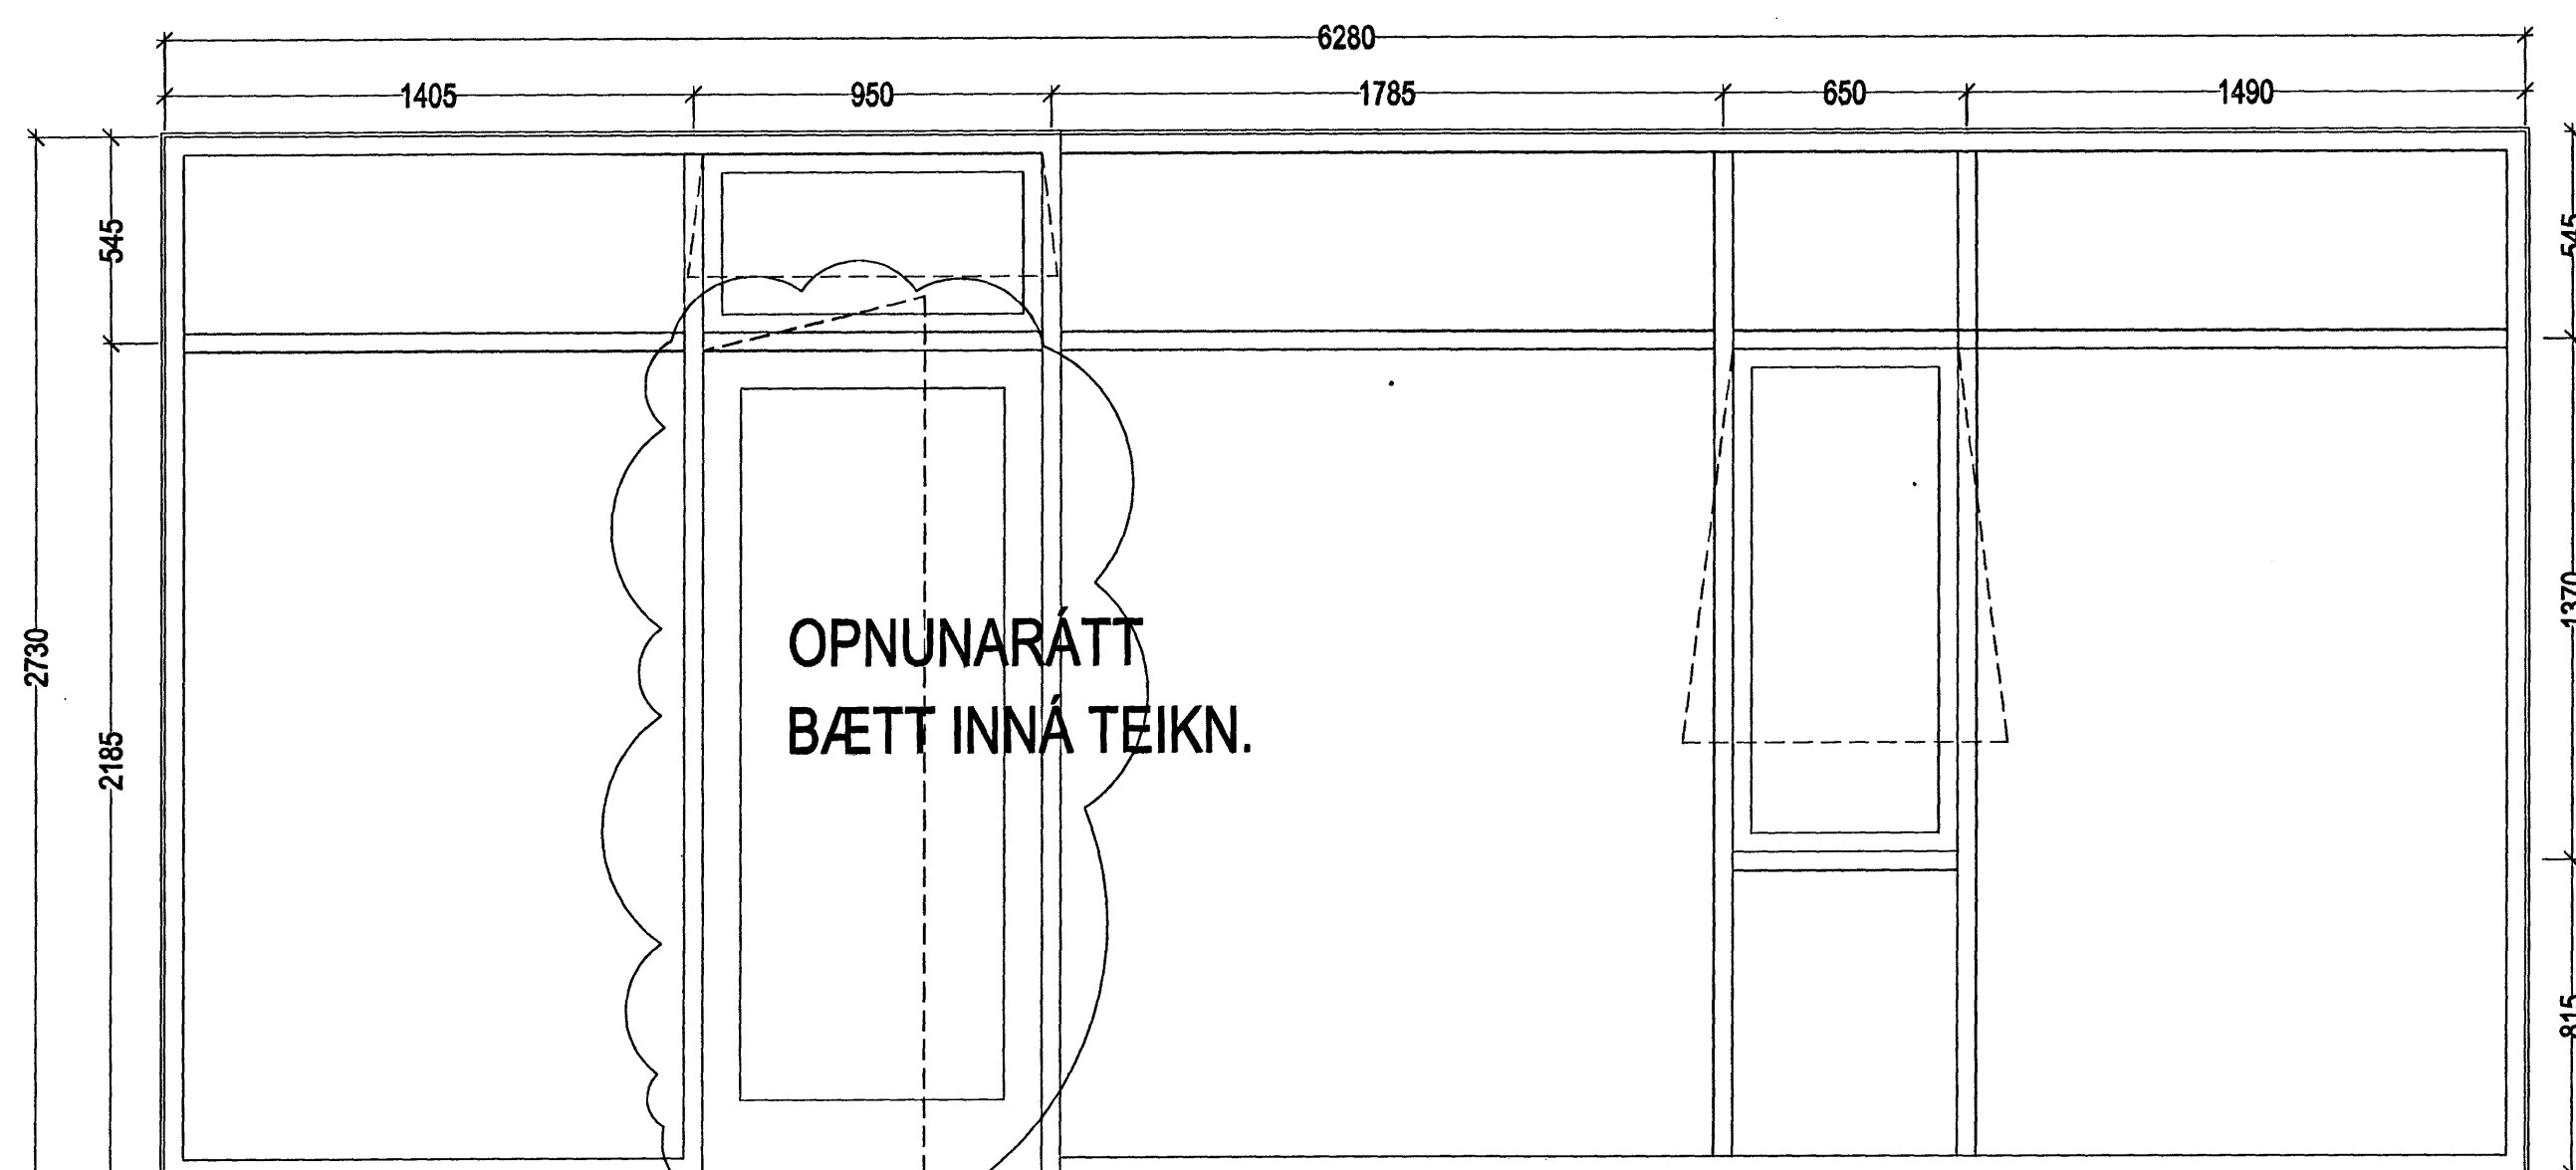

BB-1
1 stk.

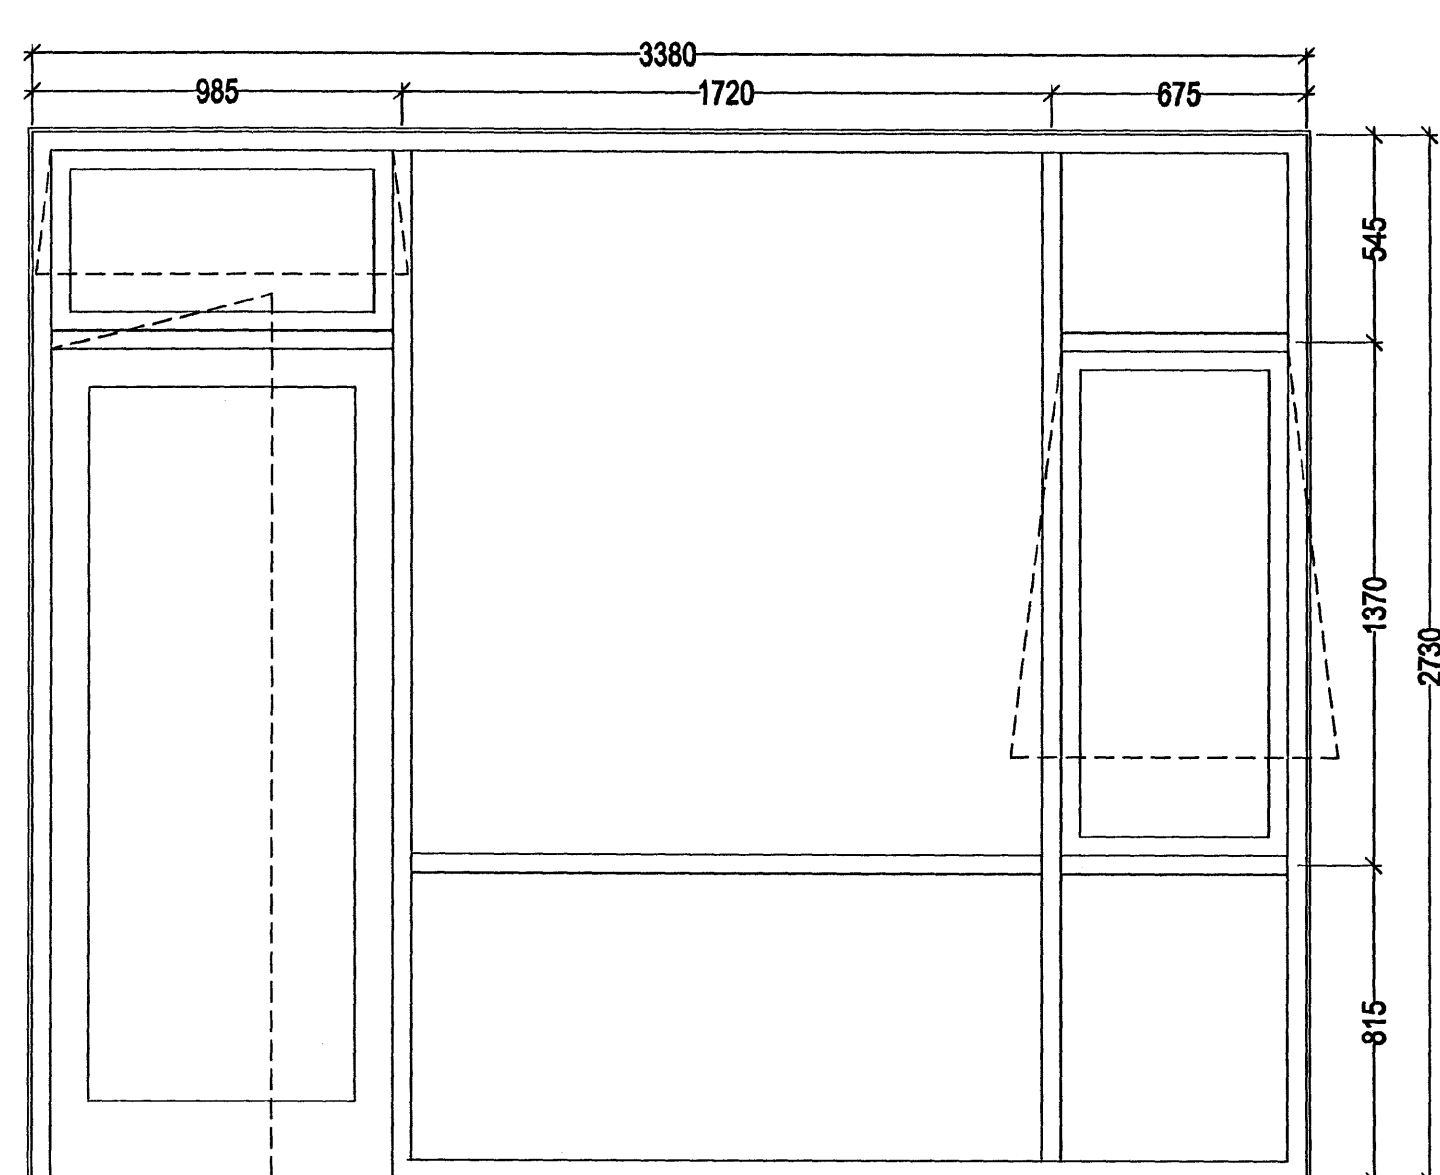


Z-1
1 stk.

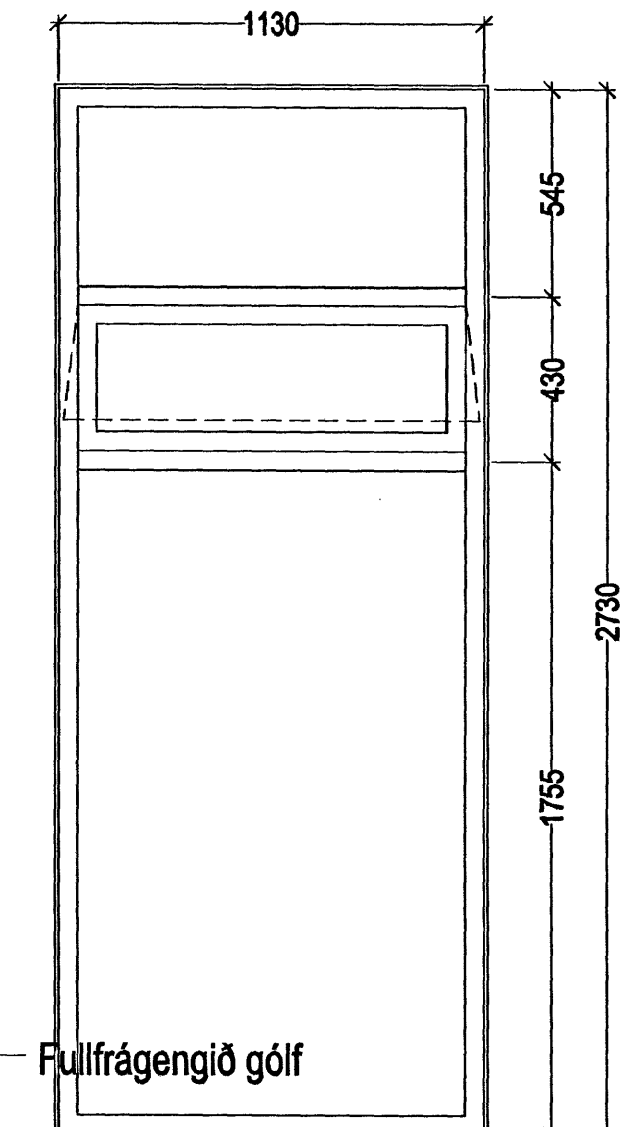

CC-1
1 stk.

Samþykkt þann
19 FEB. 2007
Byggingafulltrúinn í Hafnarfirði
F.h. Sigurbjartur Halldórsson

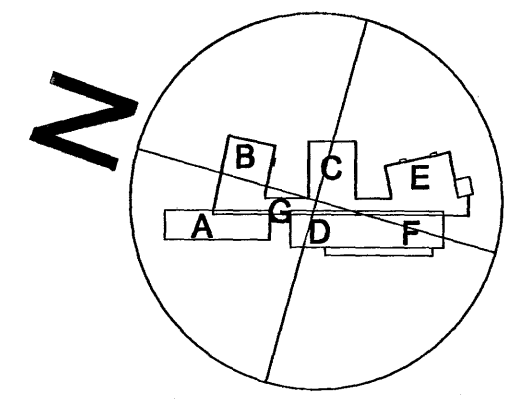

á stofunni arkitektar
Berglaðastræti 10. Rvk. Sími 551 1460. Stofna@stofunni.is

Flinnur Björgvinsson, arkitekt FAI KT: 180946-3069
Hilmur Þór Björnsson, arkitekt FAI KT: 220845-3109

Sigríður Ólafsdóttir, arkitekt FAI KT: 071070-5069

DREKAVELLIR 9
HRAUNVALLASKÚLI - 2. OG 3. ÁFANGI
GLUGGAYFRJUT
ST. 650589-1390

05-01 A-VD-024 B