



KRAFA Á HURÐ
BREYTTIST

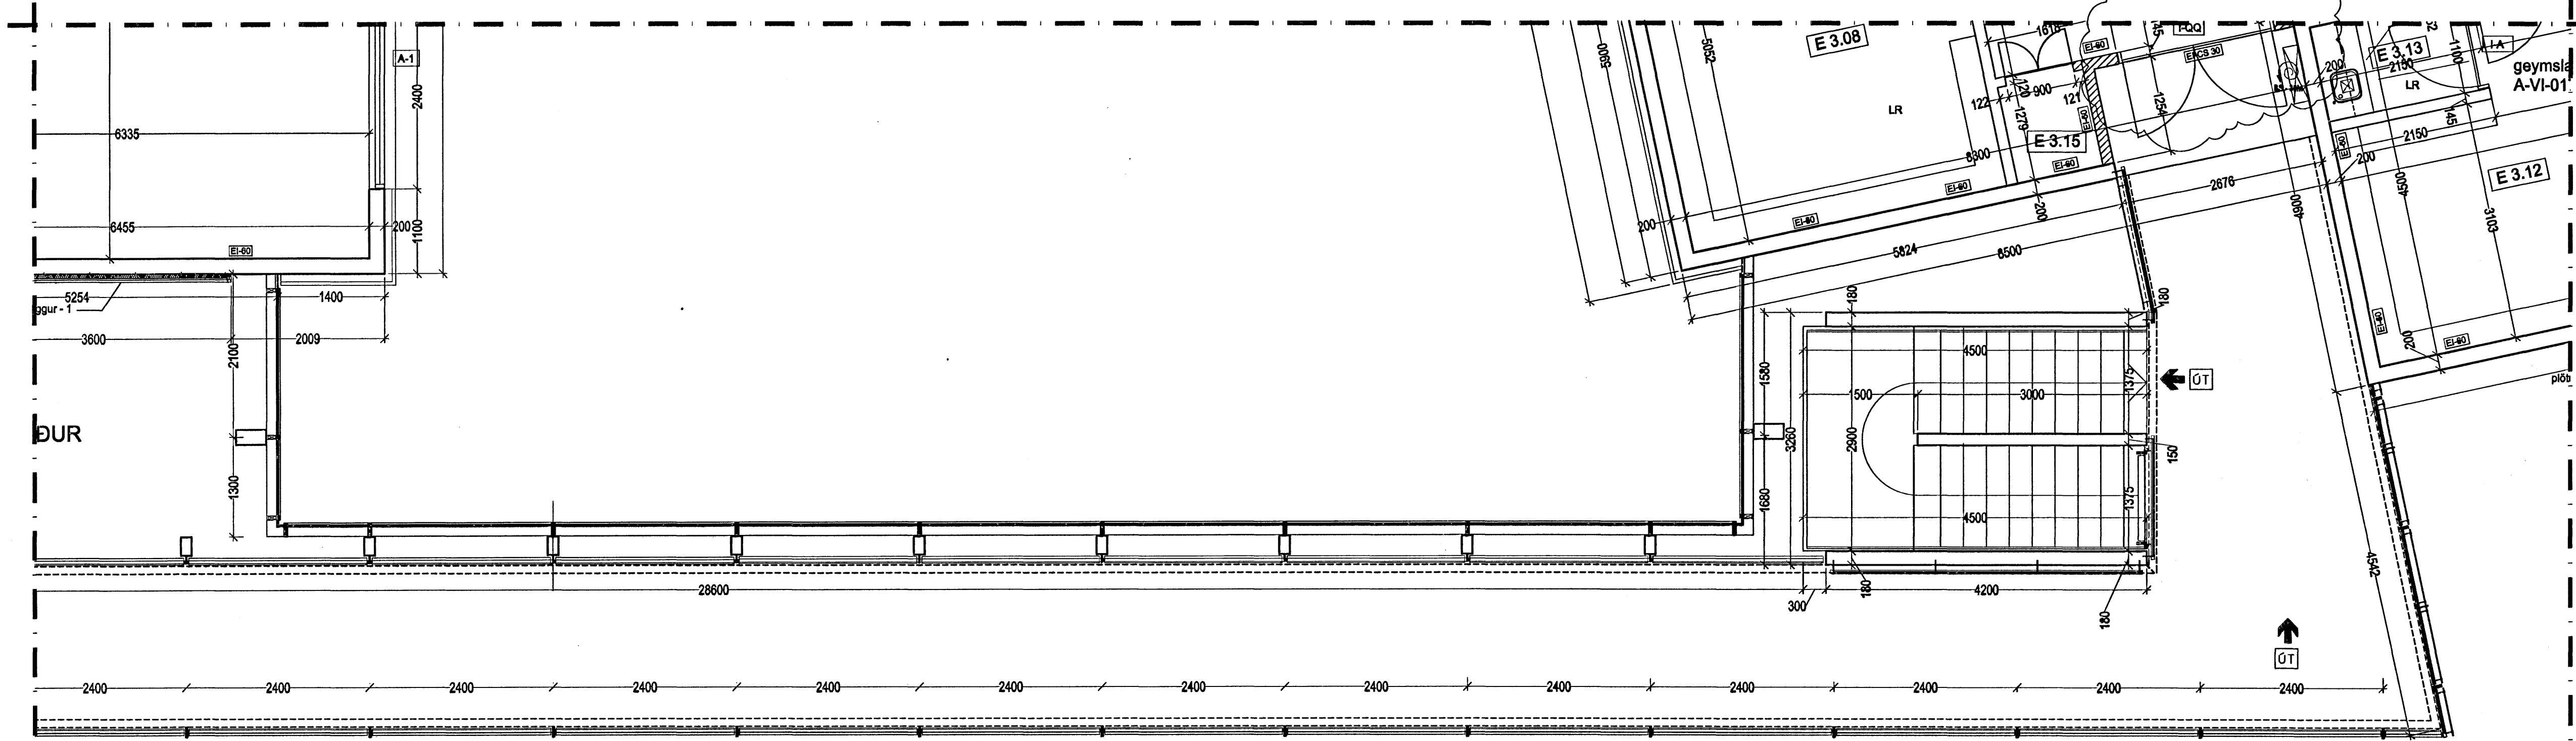


ÐUR

OP NIDUR

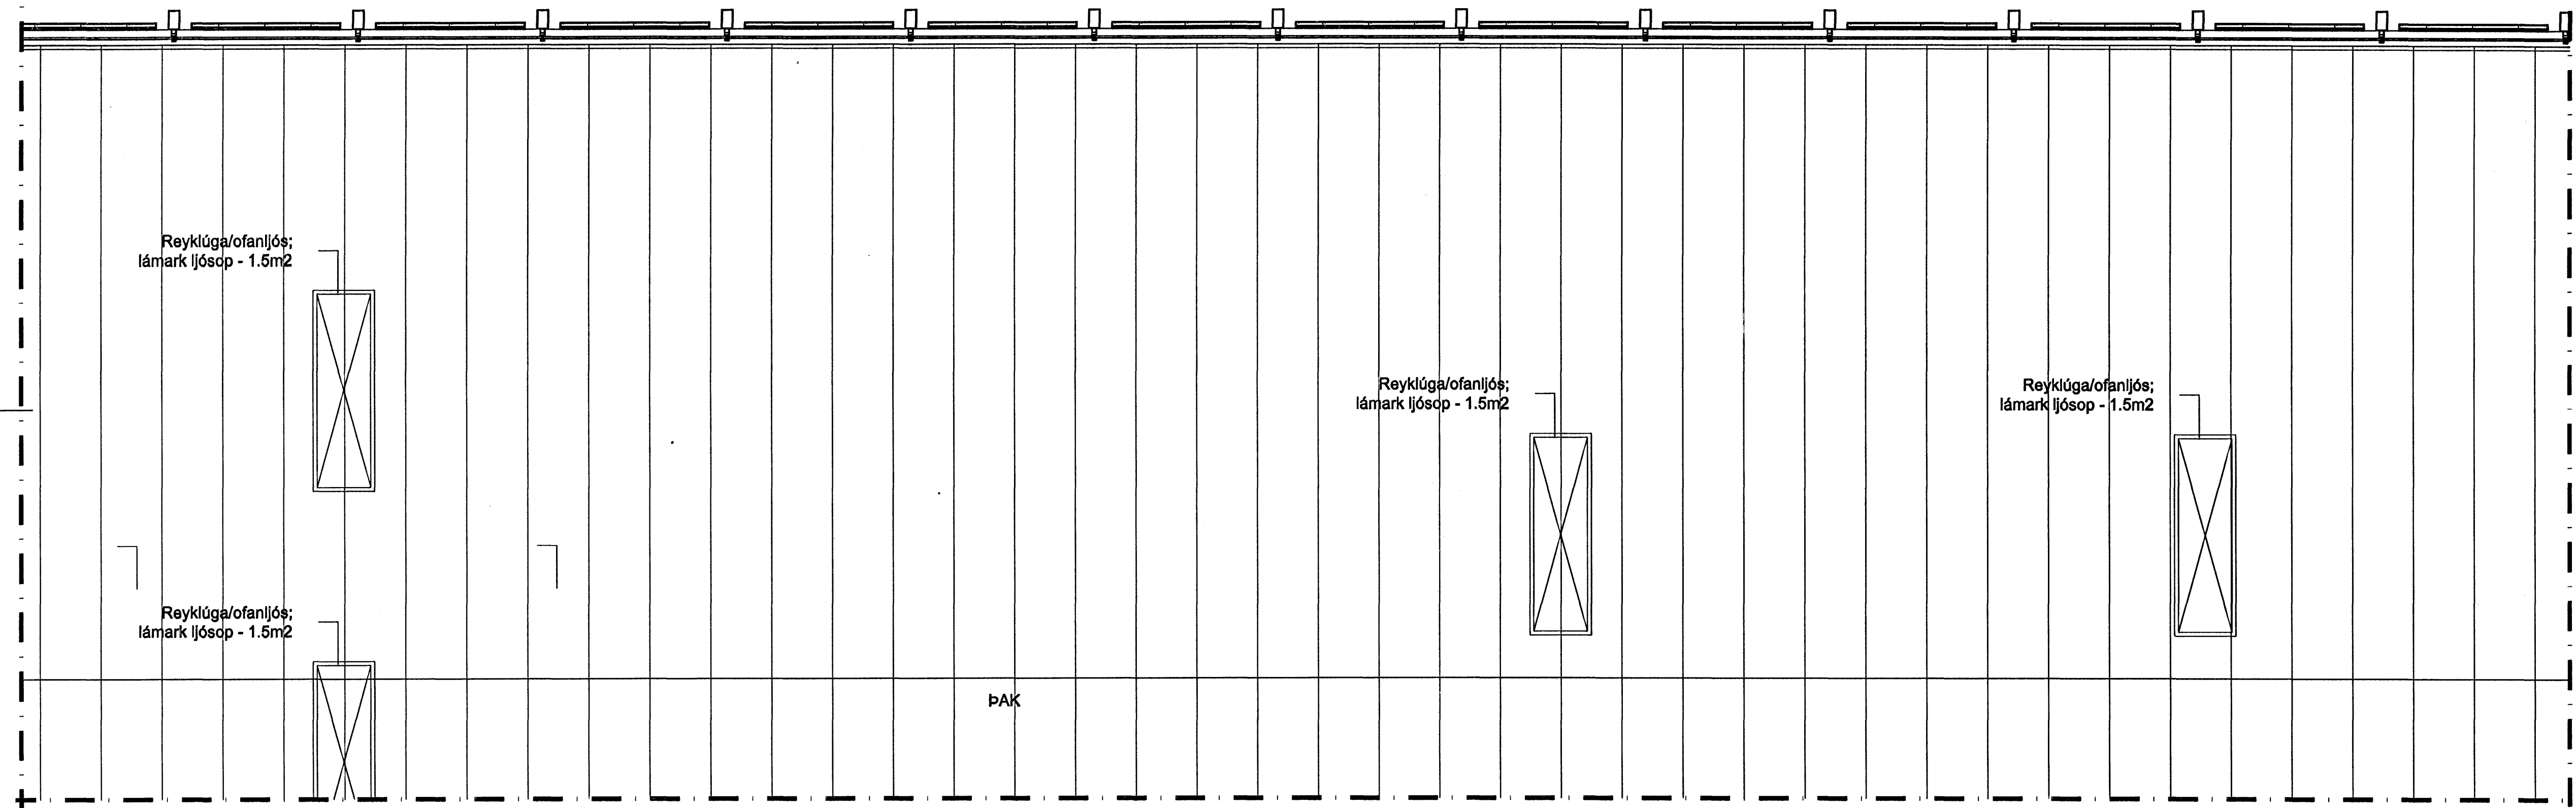

Samþykkt þann
19 FEB. 2007

Byggingafulltrúinn í Hafnarfirði
E.h. Sigurbjartur Halldórsson

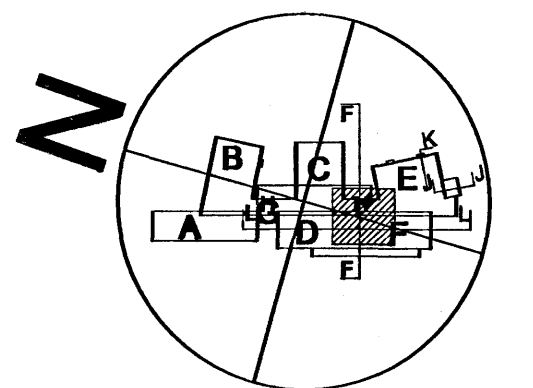

á stofunni arkitektar
Bergstaðastræti 10. Rvk. Sími 661 1460. Stofna@stofunni.is

Finnur Björgvinsson, arkitekt FAI KT: 180948-3089

Hilmar Þór Björnsson, arkitekt FAI KT: 280845-3109

Sigrður Ólafsdóttir, arkitekt FAI KT: 071070-5089

DREKAVELLIR 9
HRAUNVALLASKÓLI - 2. ÁFANGI
Skráning - 50 húsur - GRUNNMYND 3. HÆÐAR
Kt. 660589-1399

KVARN 1:50
MÁLST. 30.10.2008

05-01 A-VG3-005