




1  
70-03 SNEIDING 1:20

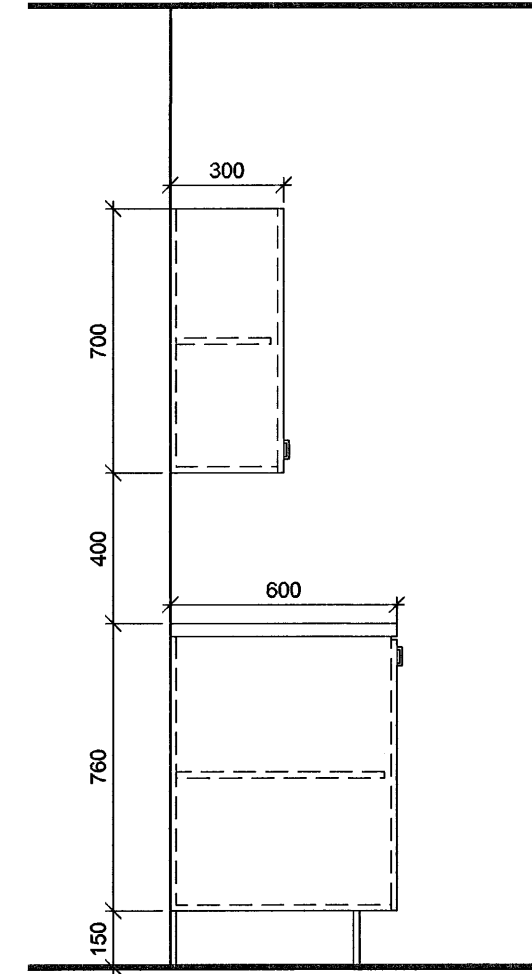


2  
70-03 SNEIDING 1:20

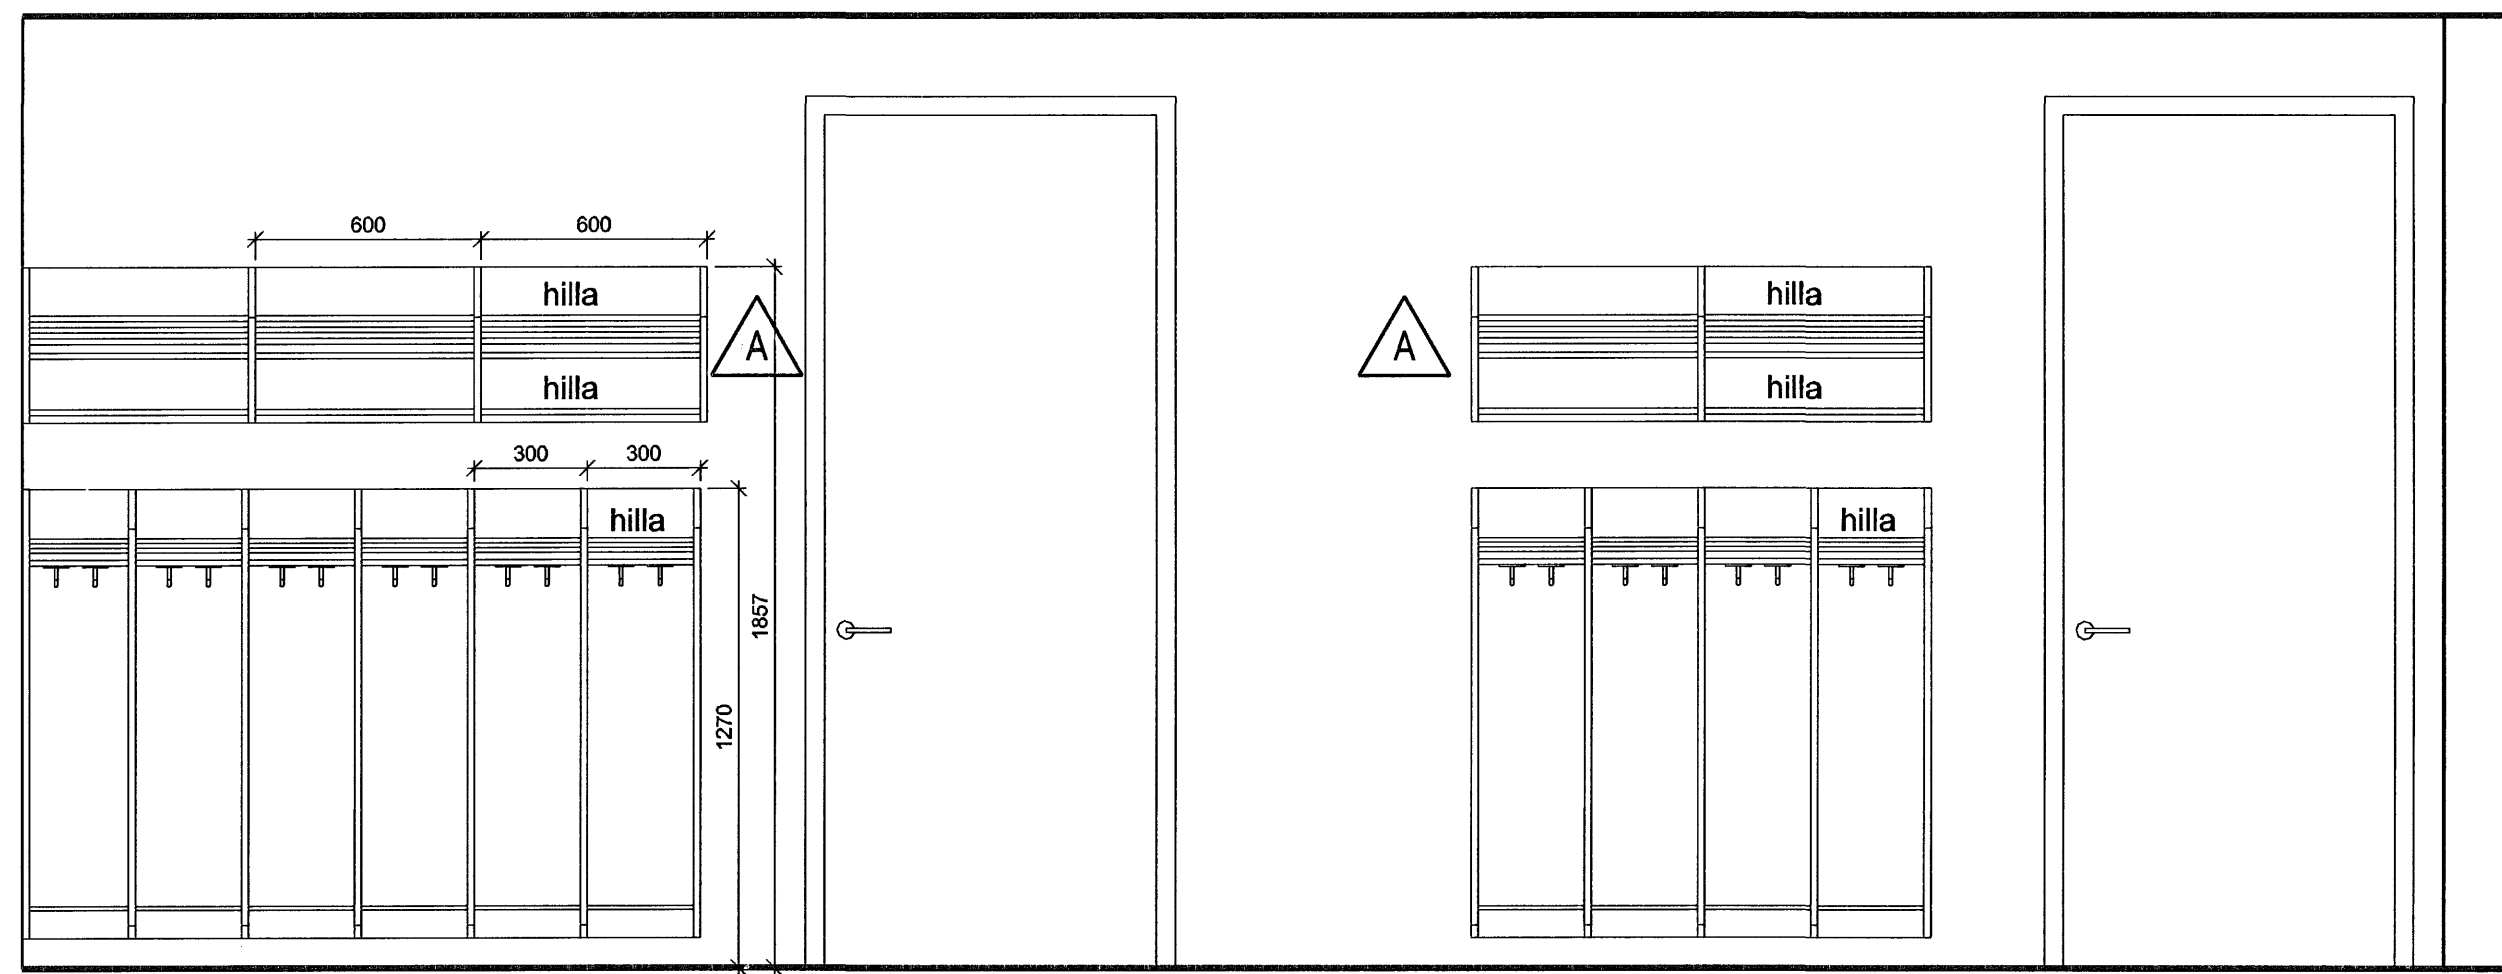


3  
70-03 SNEIDING 1:20

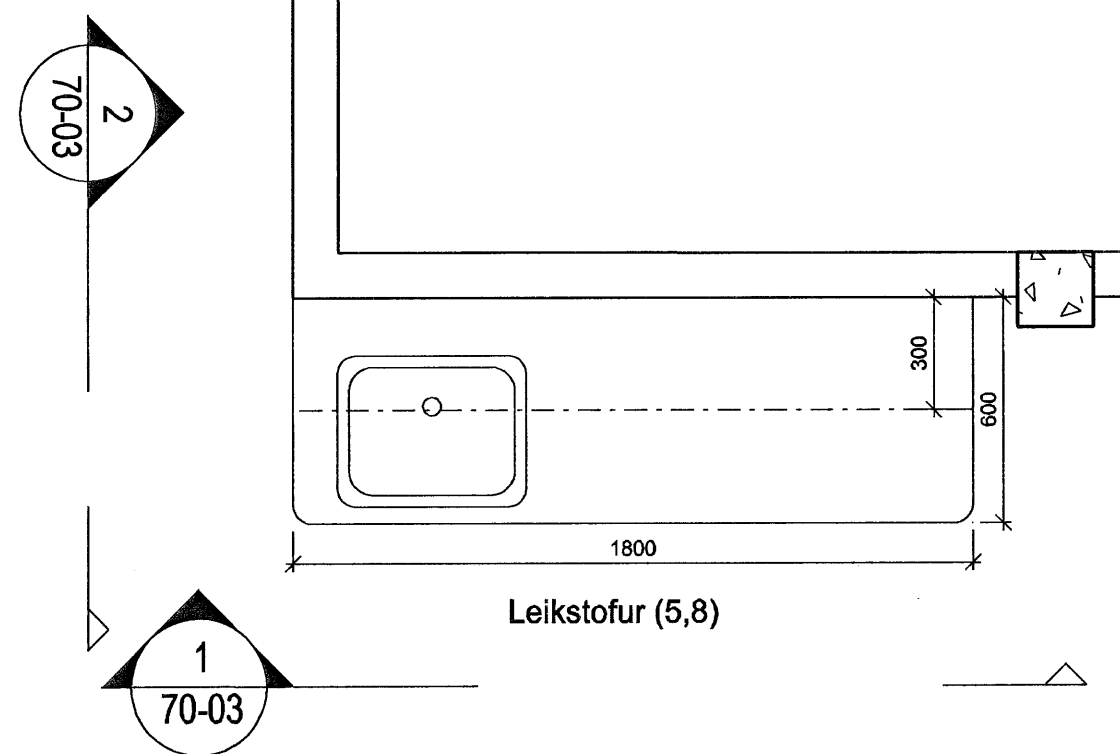


1  
70-03

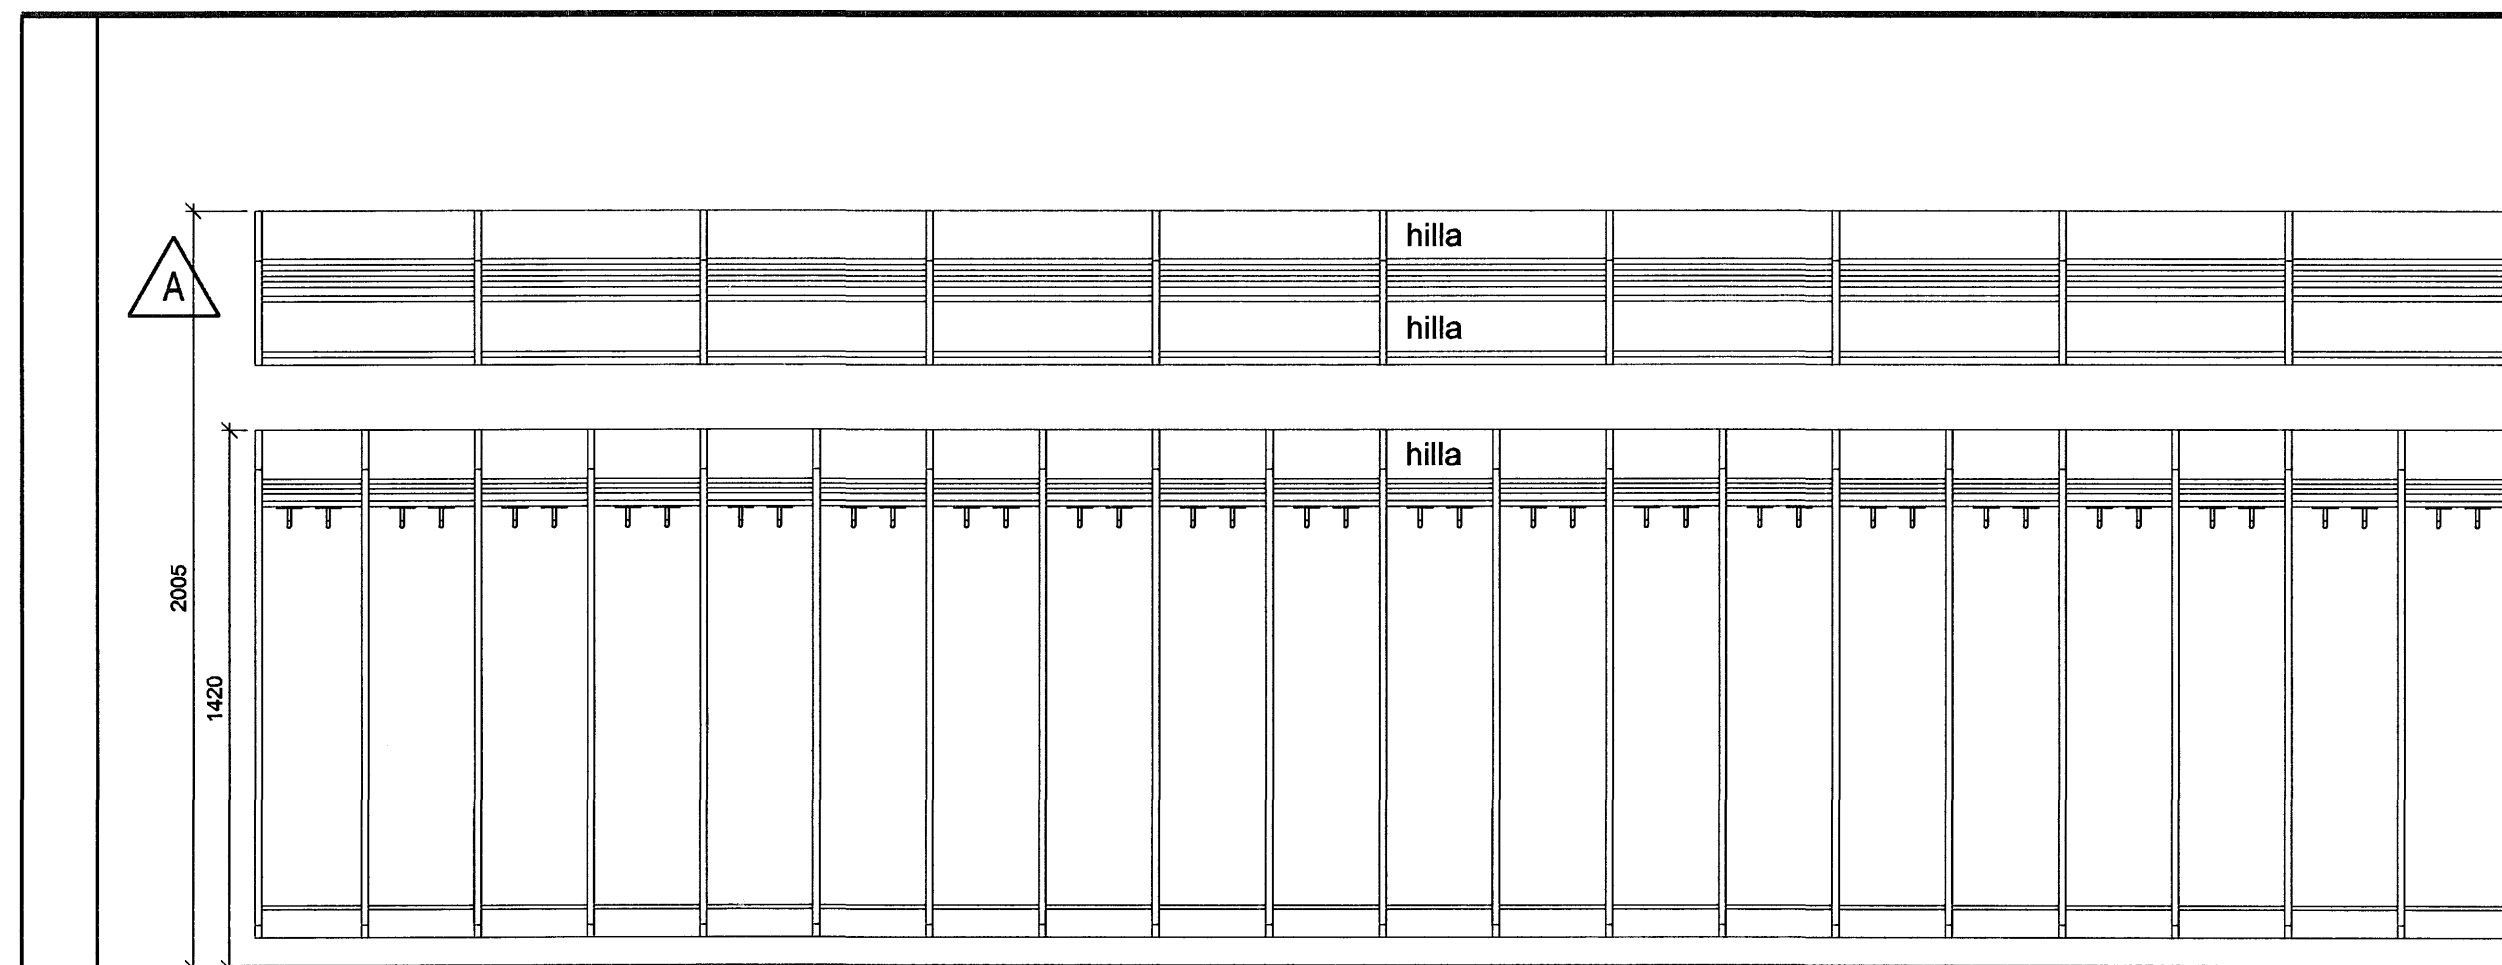

4  
70-03 SNEIDING 1:20

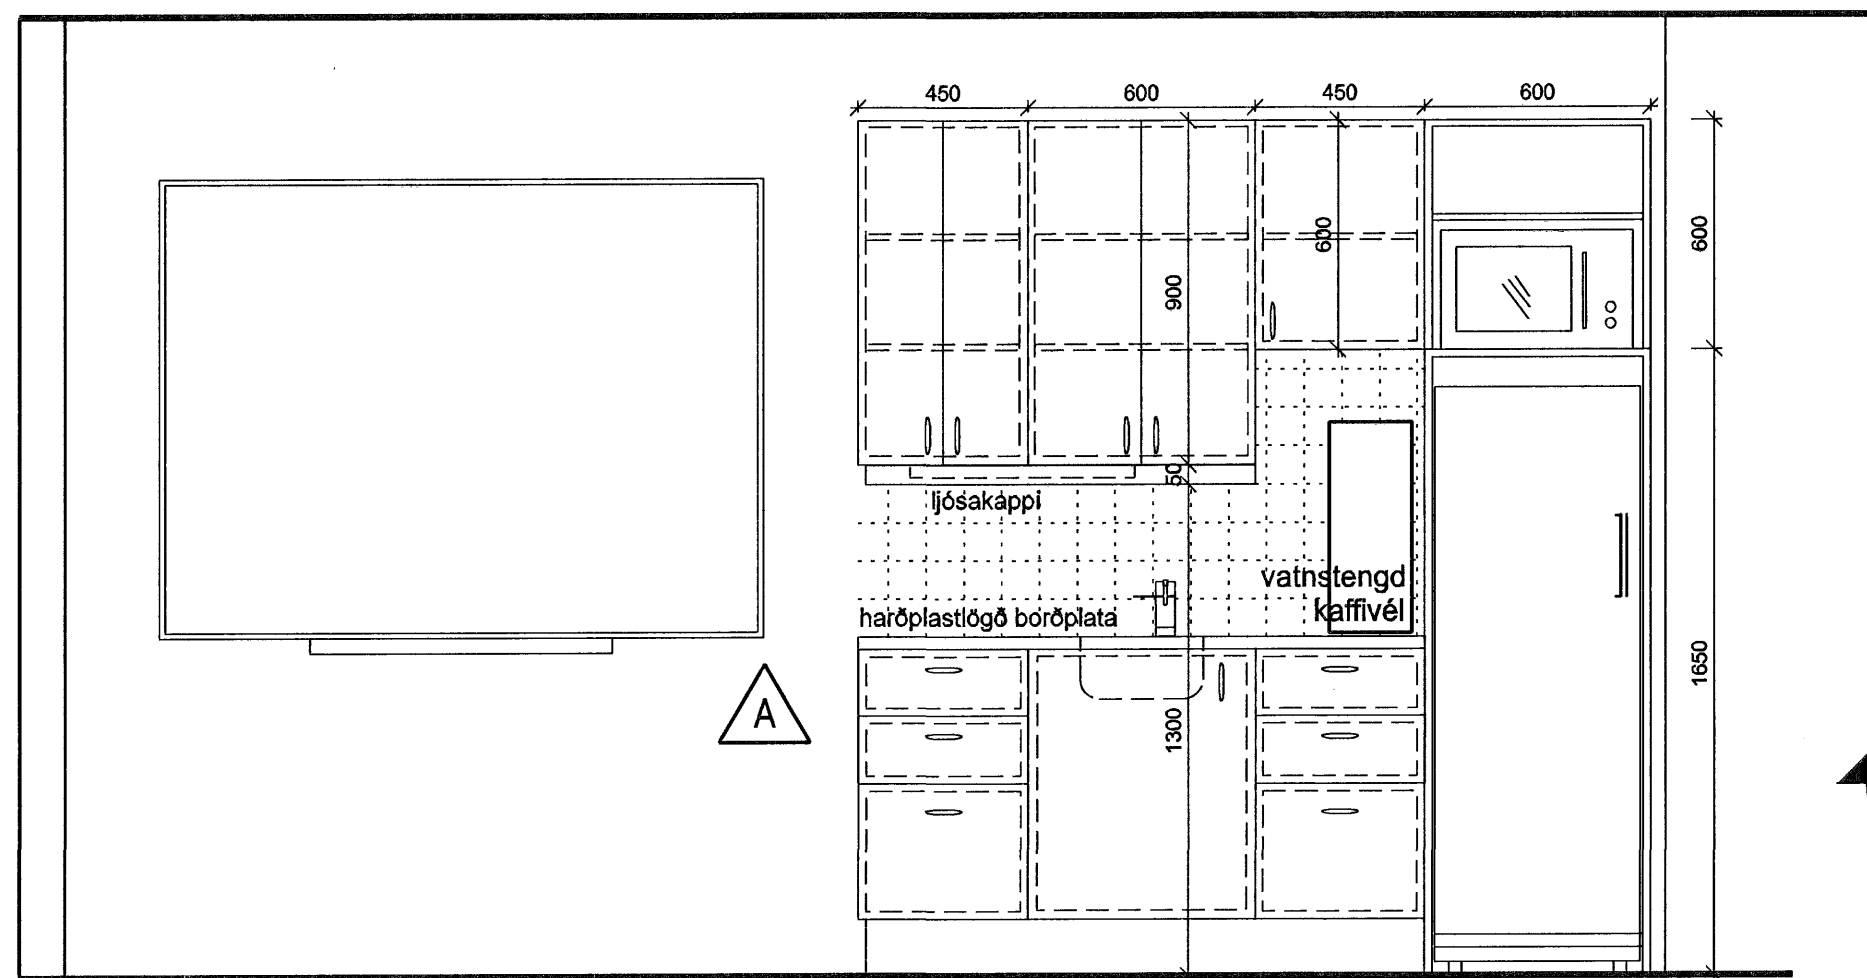


5  
70-03 SNEIDING 1:20

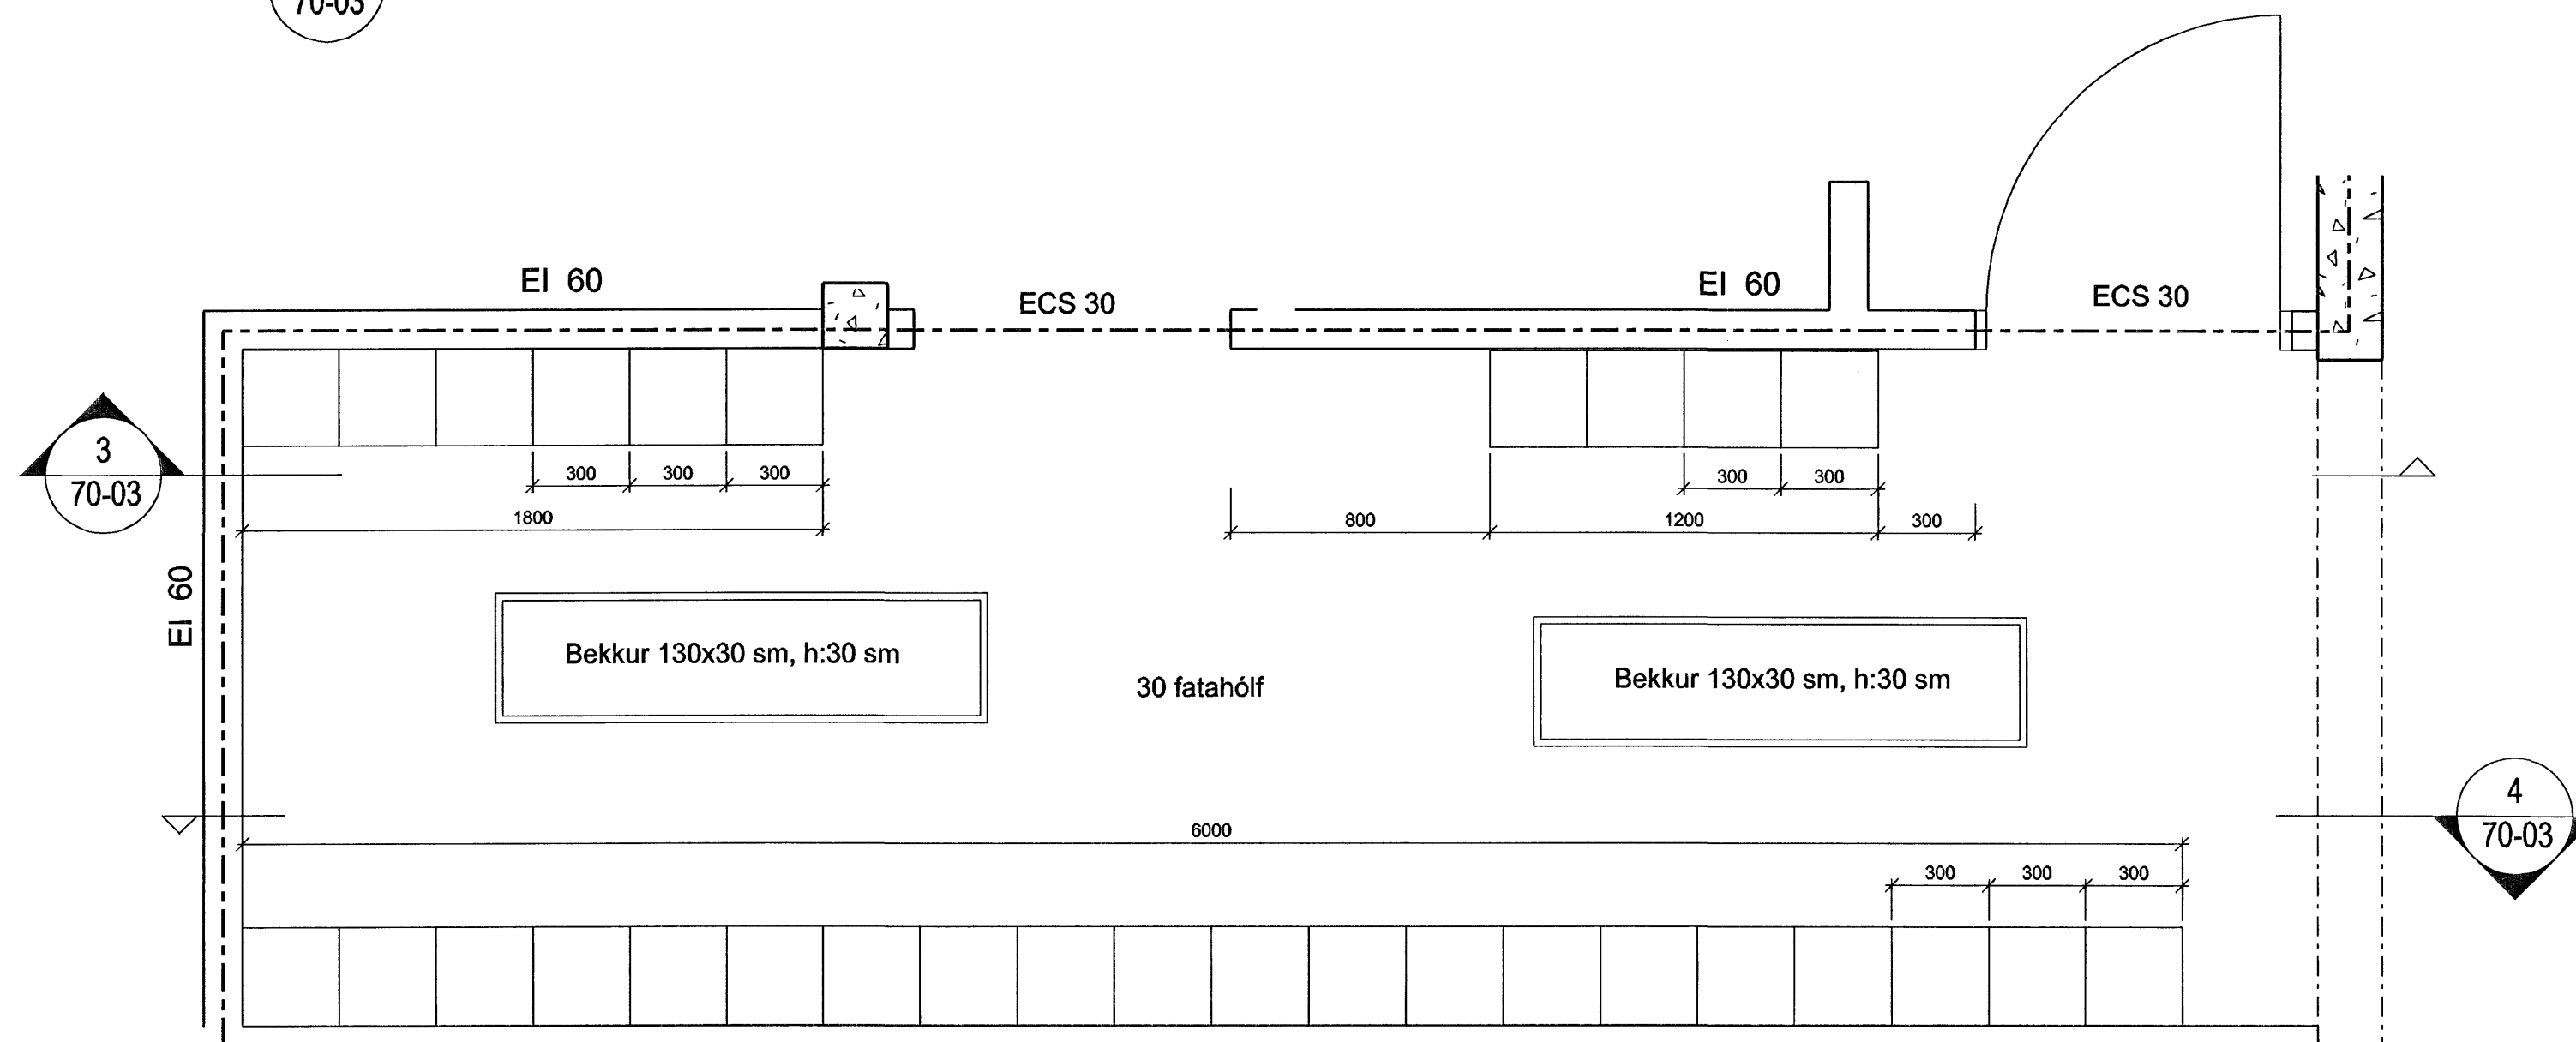

3  
70-03

4  
70-03

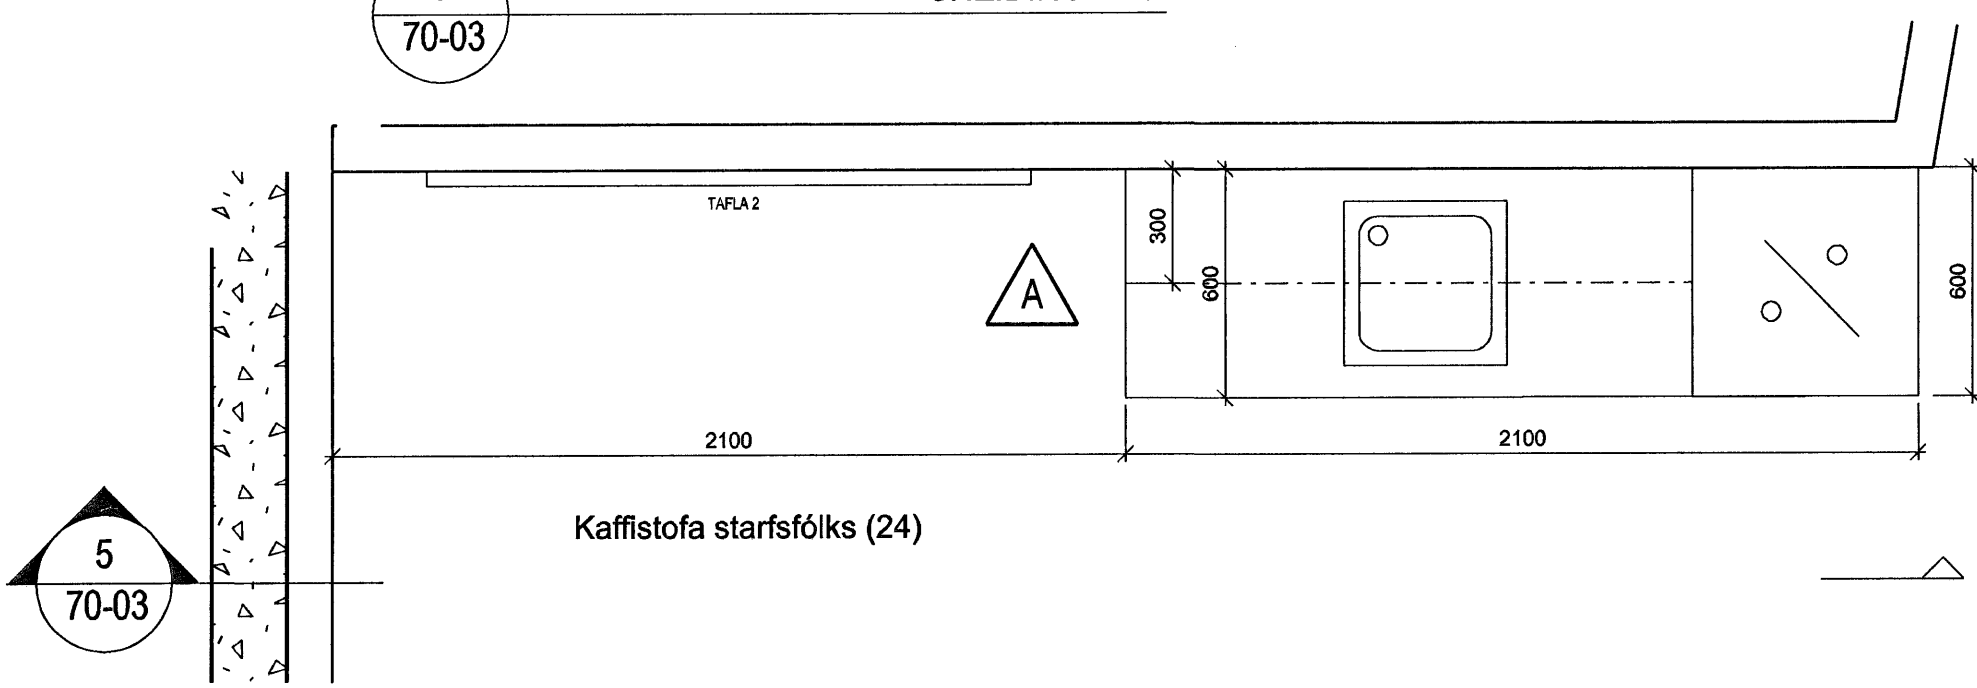

5  
70-03

A TH PG 21.08.2006  
HILLUR OFAN VÍD FATAHÖLF, KAFFISTOFUNNRETTING FÆRD TIL  
ÓTTÁFA I TEKNAÐ ISMÞRYKT 1 DAGS  
BREYTINGAR

Byggingatillitri Háinnarjardar  
Alfreitt þann  
30 JUN 2006

ASK Arkitektar  
Geirsgötu 9  
101 Reykjavík  
Sími 515 0300  
Fax 515 0319  
www.ask.is

Áritun aðshönnuðar:  
Páll Guðnason arkitekt Fax. kt. 210552-2199

Leikskólinn Hjall, Hjallabraut 55  
Viðbygging og breyting

HEITI TEKNINGAR	MYN. 1 A1
Innréttingar í	1:20
Leikstofur	TEKNAÐ
Kaffistofu starfsfólks	HP
Fataherbergi barna	DAGS
	23.03.2006
VERK NR.	ÓTTÁFA
0255	A
NUMER TEKNINGAR	
70-03	

MÁL ATHUGIST Á  
STADNUM ÁÐUR  
EN SMÍÐI HEFST