


DREIFITAFLA T.O.G.1

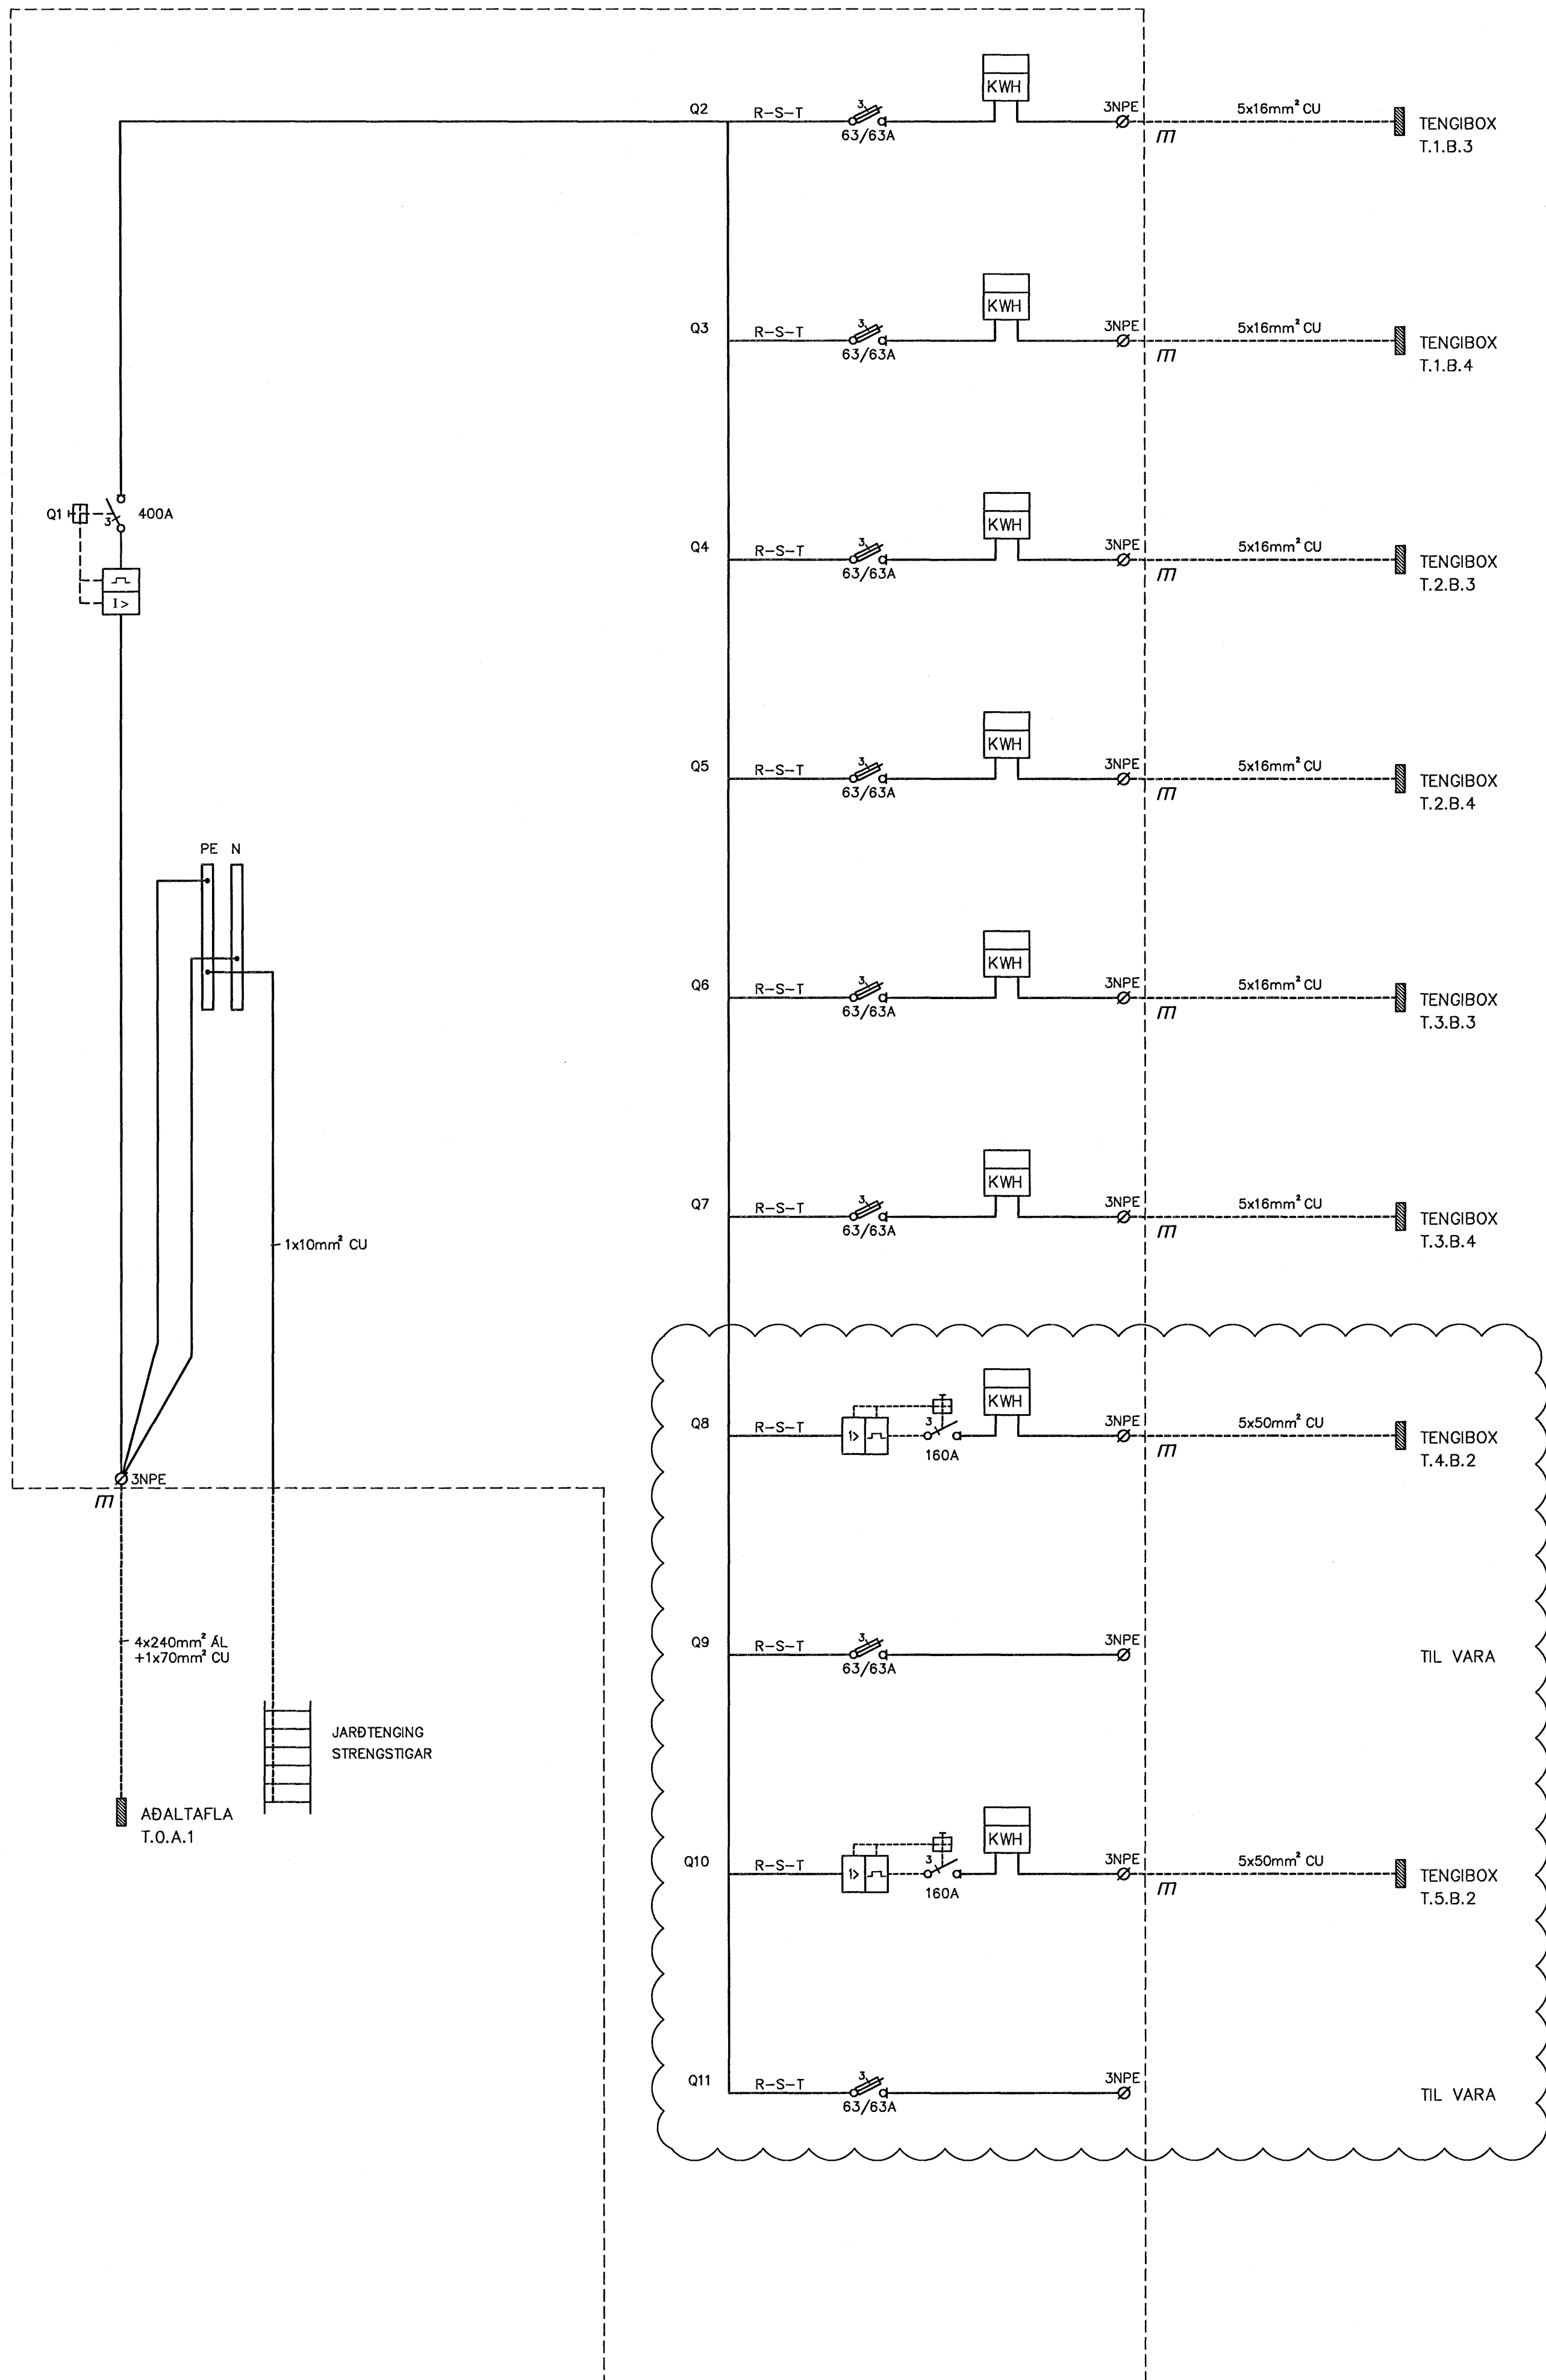

Byggingafultrúi Hafnarfjardar
Alfreitt Þann
19 SEPT. 2005

[Handwritten signature]

A	11.07.05	FULLNADARHÖNNUN	JJ	SU/EFH
ÓTG.	DAGS.	BREYTING:	HANNAÐ	SAMP.
DALSHRAUN 1 HAFNARFJÖRDUR			RAFKERFI EINLÍNUMYND DREIFITAFLA T.O.G.1	
<input type="radio"/> VSB VERKFRÆDISTOFA <small>BEJARHRAUNI 20 220 HAFNARFJÖRDUR KENNIT: 710798-2899</small>			Áritun íbgg. hönnuða: <i>[Signature]</i> Örn Guðmundsson, kt. 220961-2739	
<input checked="" type="radio"/> VSÓ RÁÐGJÖF <small>ÞORGARTONI 20, 105 REYKJAVÍK, NETFANG 4400000</small>			Hannað:	JJ
			Móð:	-A1
			Dags:	19.11.04
			Teiknað:	GÓS
			Yfirfarid:	
			Nr:	03841-R020 - A