


OFNATENGINGAR:

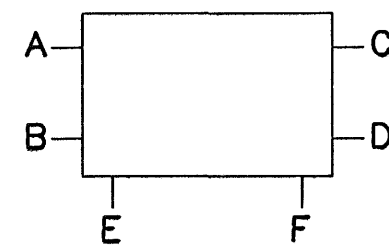

OFNALISTI

NR.	Nauðsynleg afköst [W]	Gerð/hæð [mm]	Lengd [mm]	Afköst við $\Delta T=40^{\circ}\text{C}$ [W]	Stísta staðs. 10mm	Stíllitla ofnoka
326		HANDKL/800	600	363	EF	0
327		(21)/500	1400	1260	CD	0
328		(21)/500	1800	1620	AD	0
329		(21)/500	1800	1620	BC	0
330		(21)/500	1400	1260	CD	0
331		(22)/500	1800	2187	AD	0
332		(22)/500	1400	1701	CD	0
333		(21)/500	1400	1260	AB	0
334		HANDKL/800	600	363	EF	0
335		HANDKL/800	600	363	EF	0
336		(11)/500	2800	1768	CD	0
337		(11)/500	1200	757	AB	0
338		(11)/500	1200	757	CD	0
339		(11)/500	2800	1768	AD	0
340		HANDKL/800	600	363	EF	0
341		(21)/500	1400	1260	CD	0
342		(22)/500	1400	1701	AB	0
343		(22)/500	1800	2187	BC	0
344		(21)/500	1400	1260	CD	0
345		HANDKL/800	600	363	EF	0
346		(21)/500	1800	1620	AD	0
347		(21)/500	1800	1620	BC	0
348		(21)/500	1400	1260	AD	0
349		HANDKL/800	600	363	EF	0
Samtals:				29044		

Á ALLA OFNA KOMI FRAMRÁSALOKAR, STILLITÉ, AFTÆMING OG LOFTSKRÚVA

Byggingeignunni
Alfreð benn
15 JULI 2005
70

B	11.07.05	BREYTING NEYSLUVANSLAGNI	KJM	SÁS
A	03.03.05	LOFTREIÐSTOKK BAIT VÖD Í LAGNASTOKK VEGNA BR. Á ÍBÚÐ 01-06	BS	SÁS
ÓTG.	DAGS.	BREYTING:	HANNAD	SAMP
HERJÓLFSGATA 36, 38 OG 40 LANGEYRARNÖLUM HAFNARFIRDI			HITA OG HREINLETISLAGNIR 3 HÆÐ NR.38	
VSB VERKFRÆDISTOFA			Áritun lögg. hönnuða: Sveinn Aki Sverrissón kt.230855-5609	
BEIARHRAUNI 20 • 220 HAFNARFJÖRDUR Heimasíða: www.vsb.is • Netfang: vsb@vsb.is Sími 580-8600 Fax 585-8610 • kt:710796-2899		Hannað: Áp Teiknað: Áp		Yfirfarid: SÁS
FRV		Dags: 24.01.05		Nr: 04758-P21B