

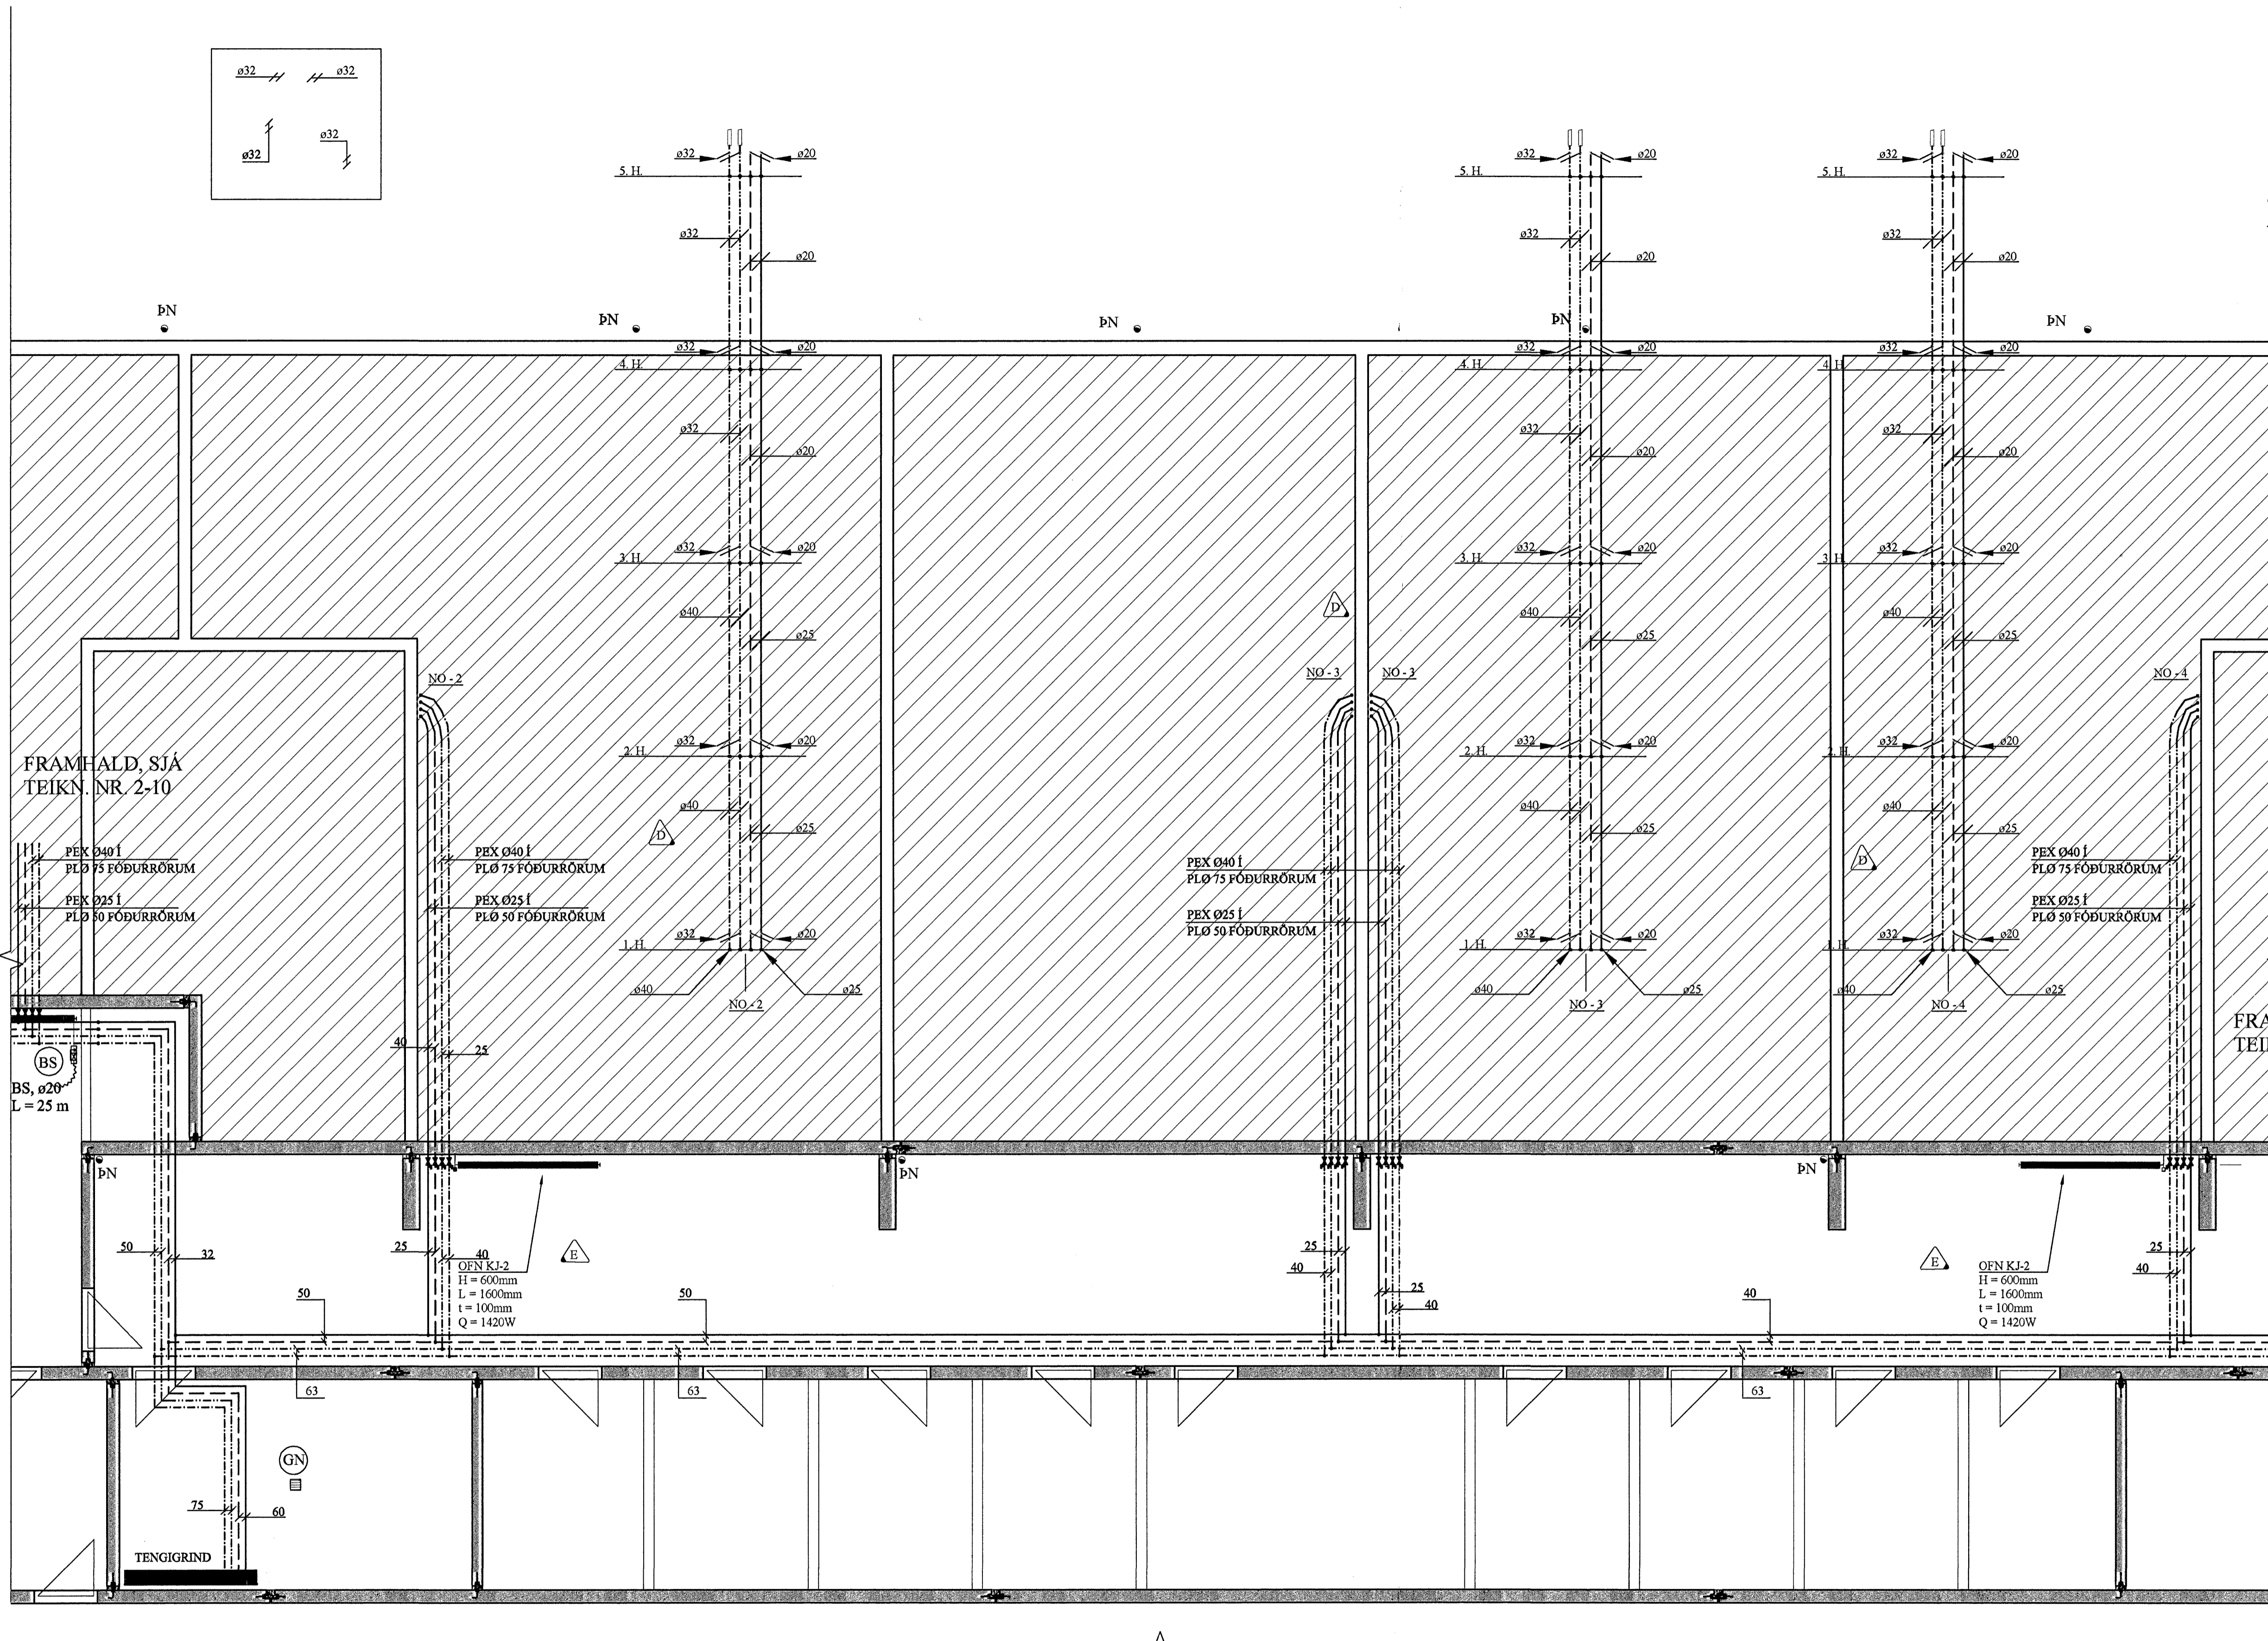


# HITA- OG NEYSLUVATNSKERFI 1.HÆÐAR, GRUNNMYND. 1:50

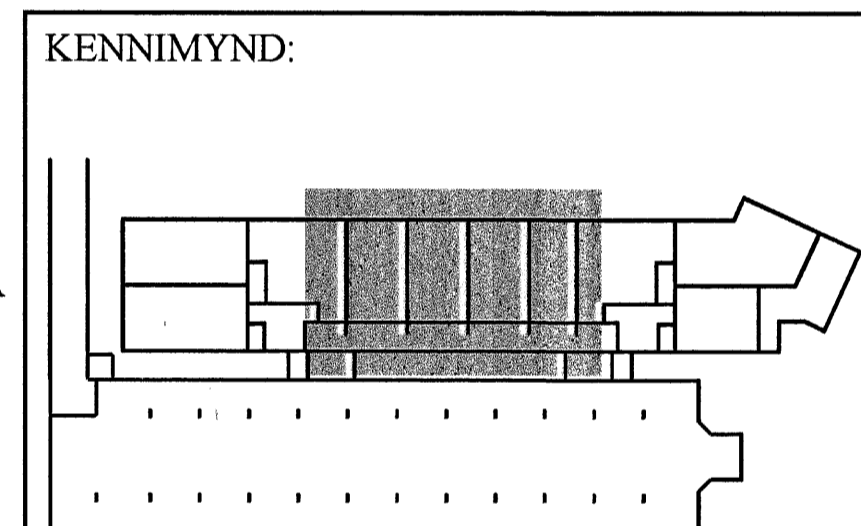

## TENGIGRIND, RUMMYND. 1:20

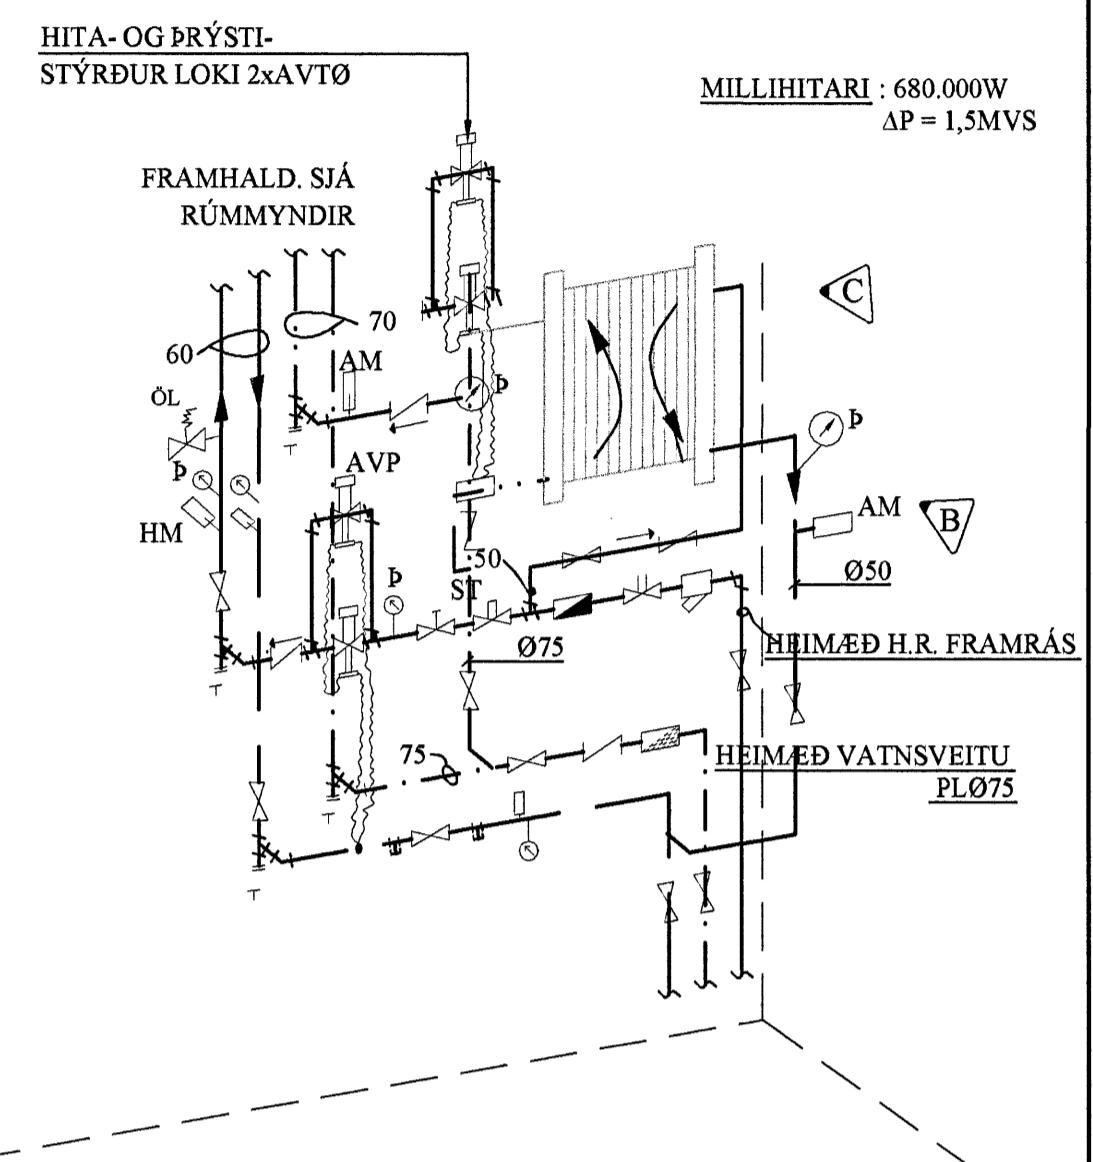

E	20.10.06	OFN KJ-1	Jón Kr.
D	05.04.06	STOFNAR	Jón Kr.
C	22.03.06	MILLIHITARI Á NEYSLUVATNSLÖGN	Jón Kr.
B	18.03.06	TENGIGRIND	Jón Kr.
A	14.03.06	PÍPUSTÆRDIR	Jón Kr.

BREYTINGAR

**TILVÍSANIR:**  
SKÝRINGAR..... SJÁ TEIKN. NR. 2-01

Samþykkt bann  
07 NOV. 2006  
Byggingafulltrúi - Hafnarfirði  
Eh. Sigurjartur Halldórsson

*[Signature]*

FRAMHALD, SJÁ  
TEIKN. NR. 2-14

Reikn.	JKR/AJG	Mai. '05	Útgáfud.	25.11.2005
Teikn.	AJG	Mai. '05	Kvarði.	1:50
Ath.				
Samþ.				
<b>FLATAHRAUN 1</b>				Nr.
Hafnarfirði				2-11
Verkhlu HITA- OG NEYSLU- VATNSKERFI KJALLARA, GRUNNMYND OG SKÝRINGAR.		Jón Kristjánsson Byggingafræðingur EYFI Skúlagata 19 101 Reykjavík Sími: 595-9620 Gsm: 863-2154 KÍ 210764-829 Netfang: jkr@dmrnet.is http://www.VJK.is		