



DAGS:	NR:	BREYTINGAR:	SAMÞ:
ST.08.05	△	REYNDARTEKNING	

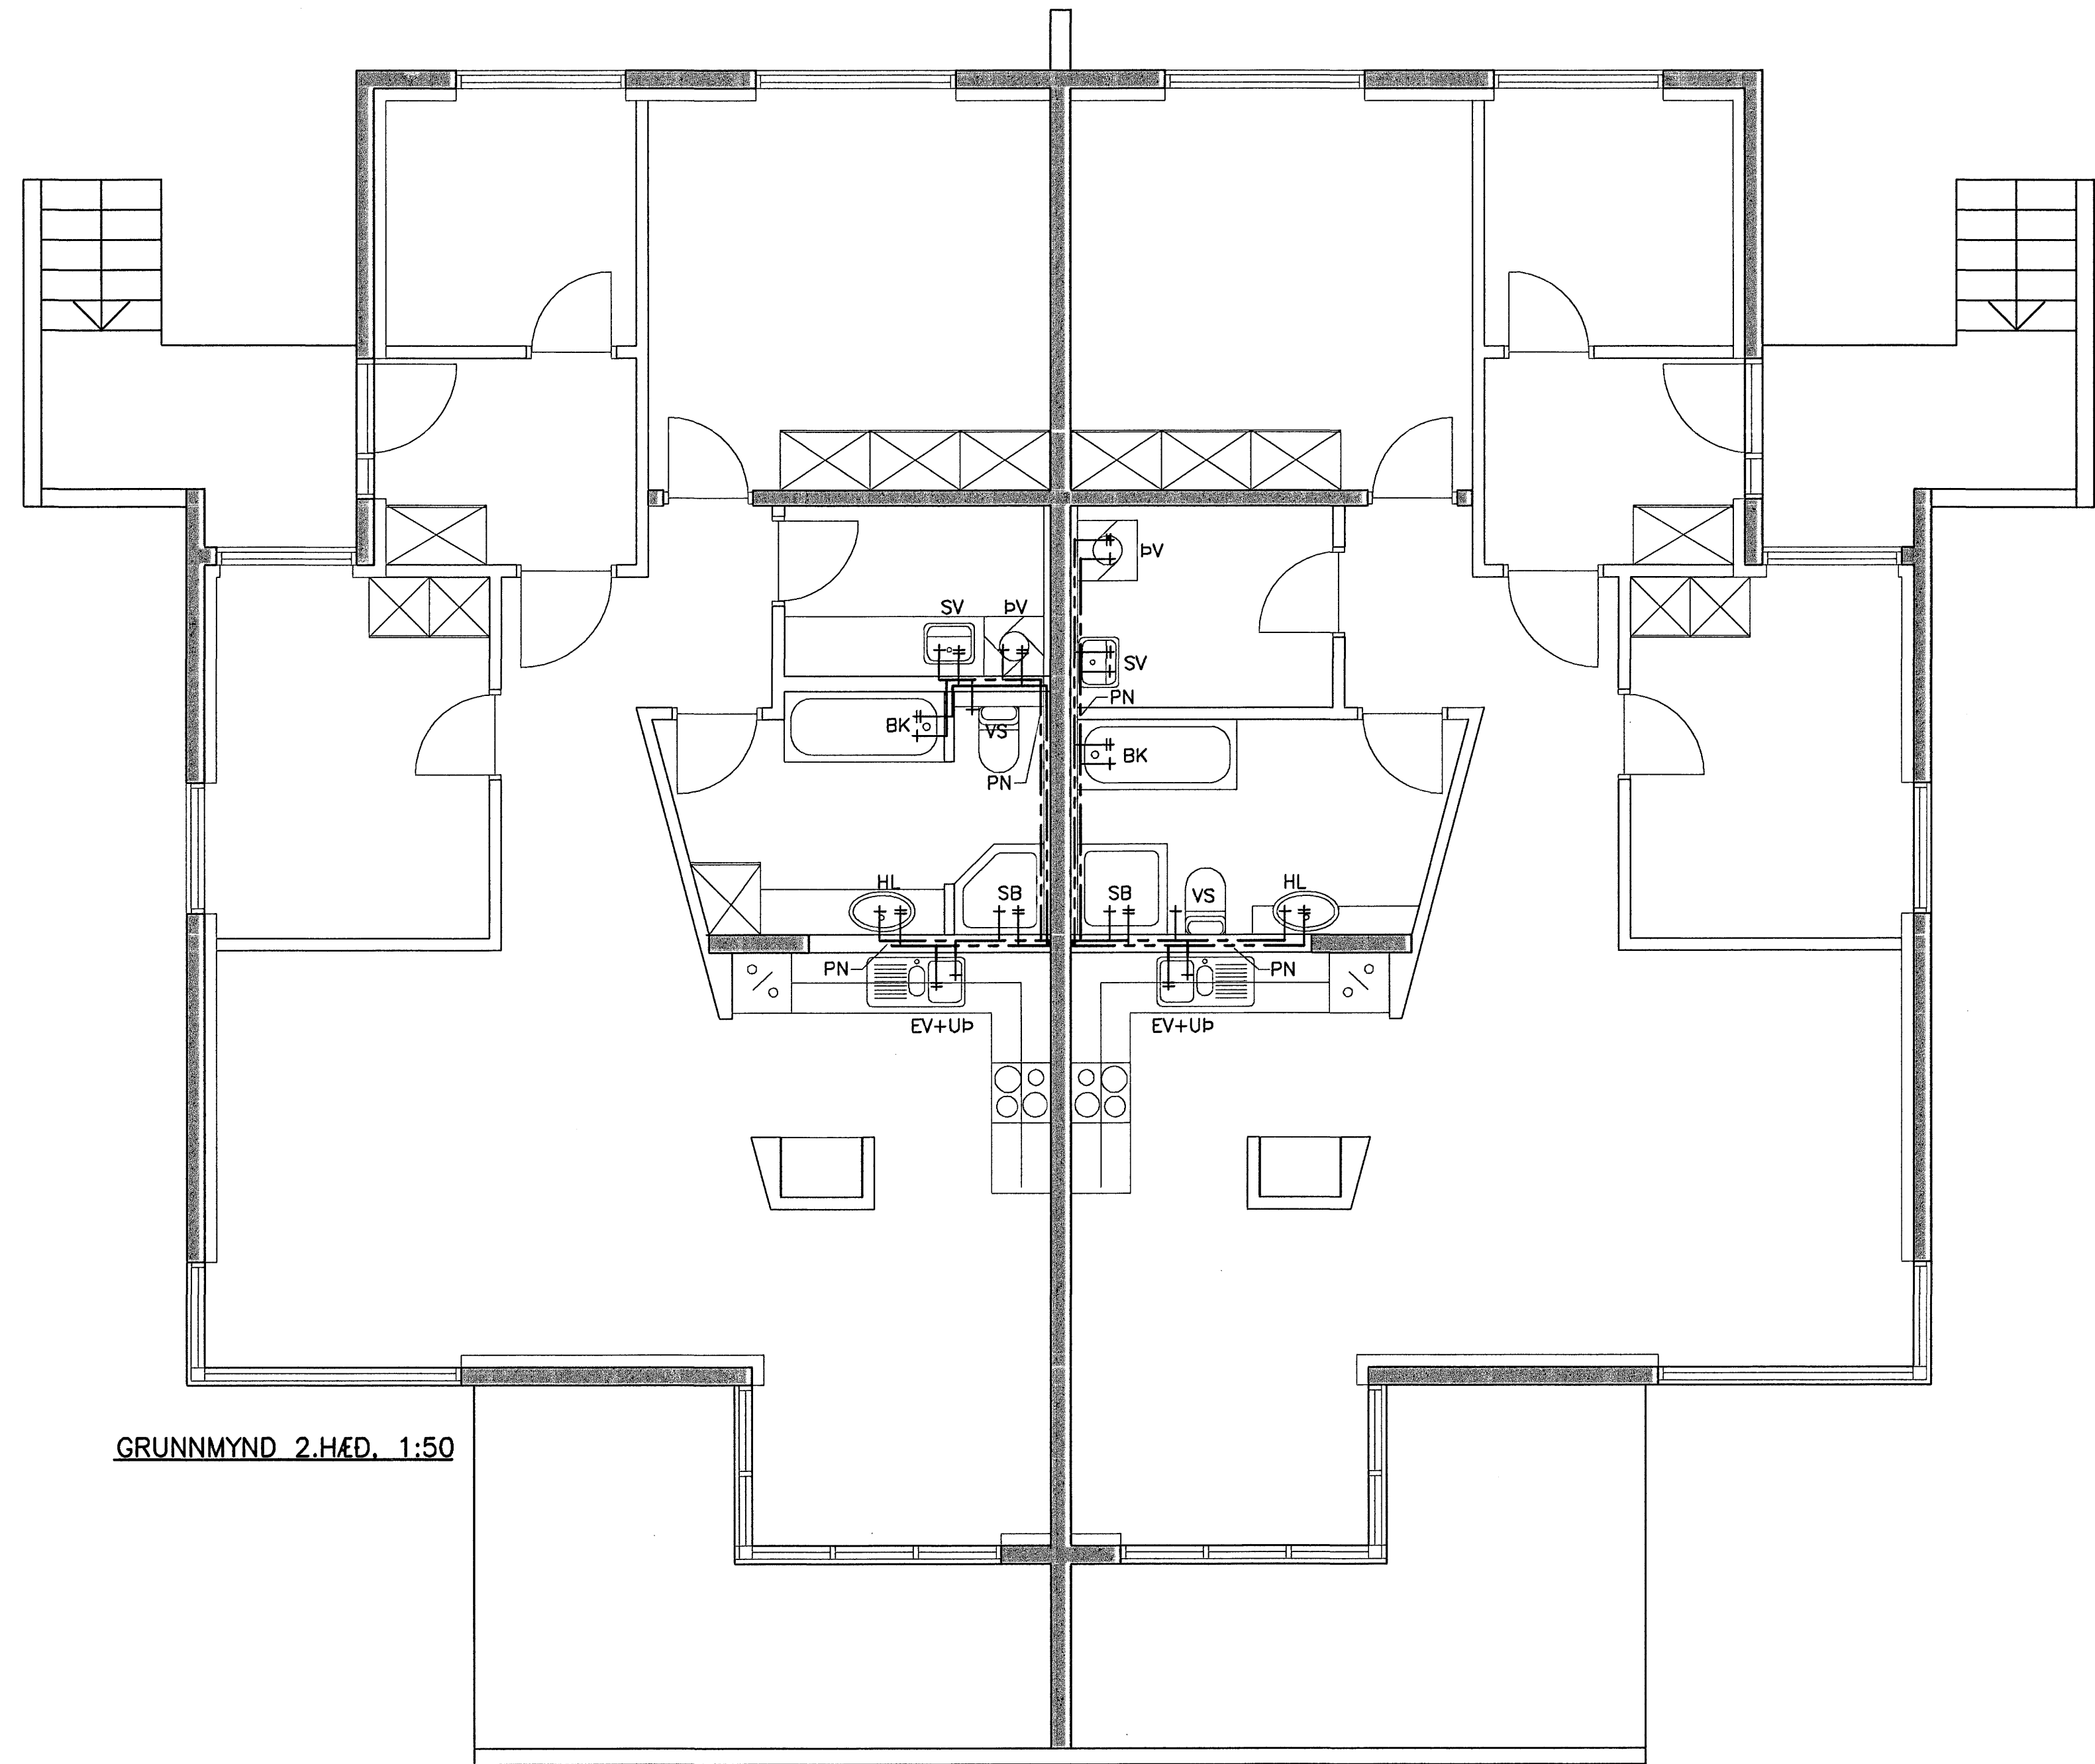


GRUNNMYND 2.HÆÐ. 1:50

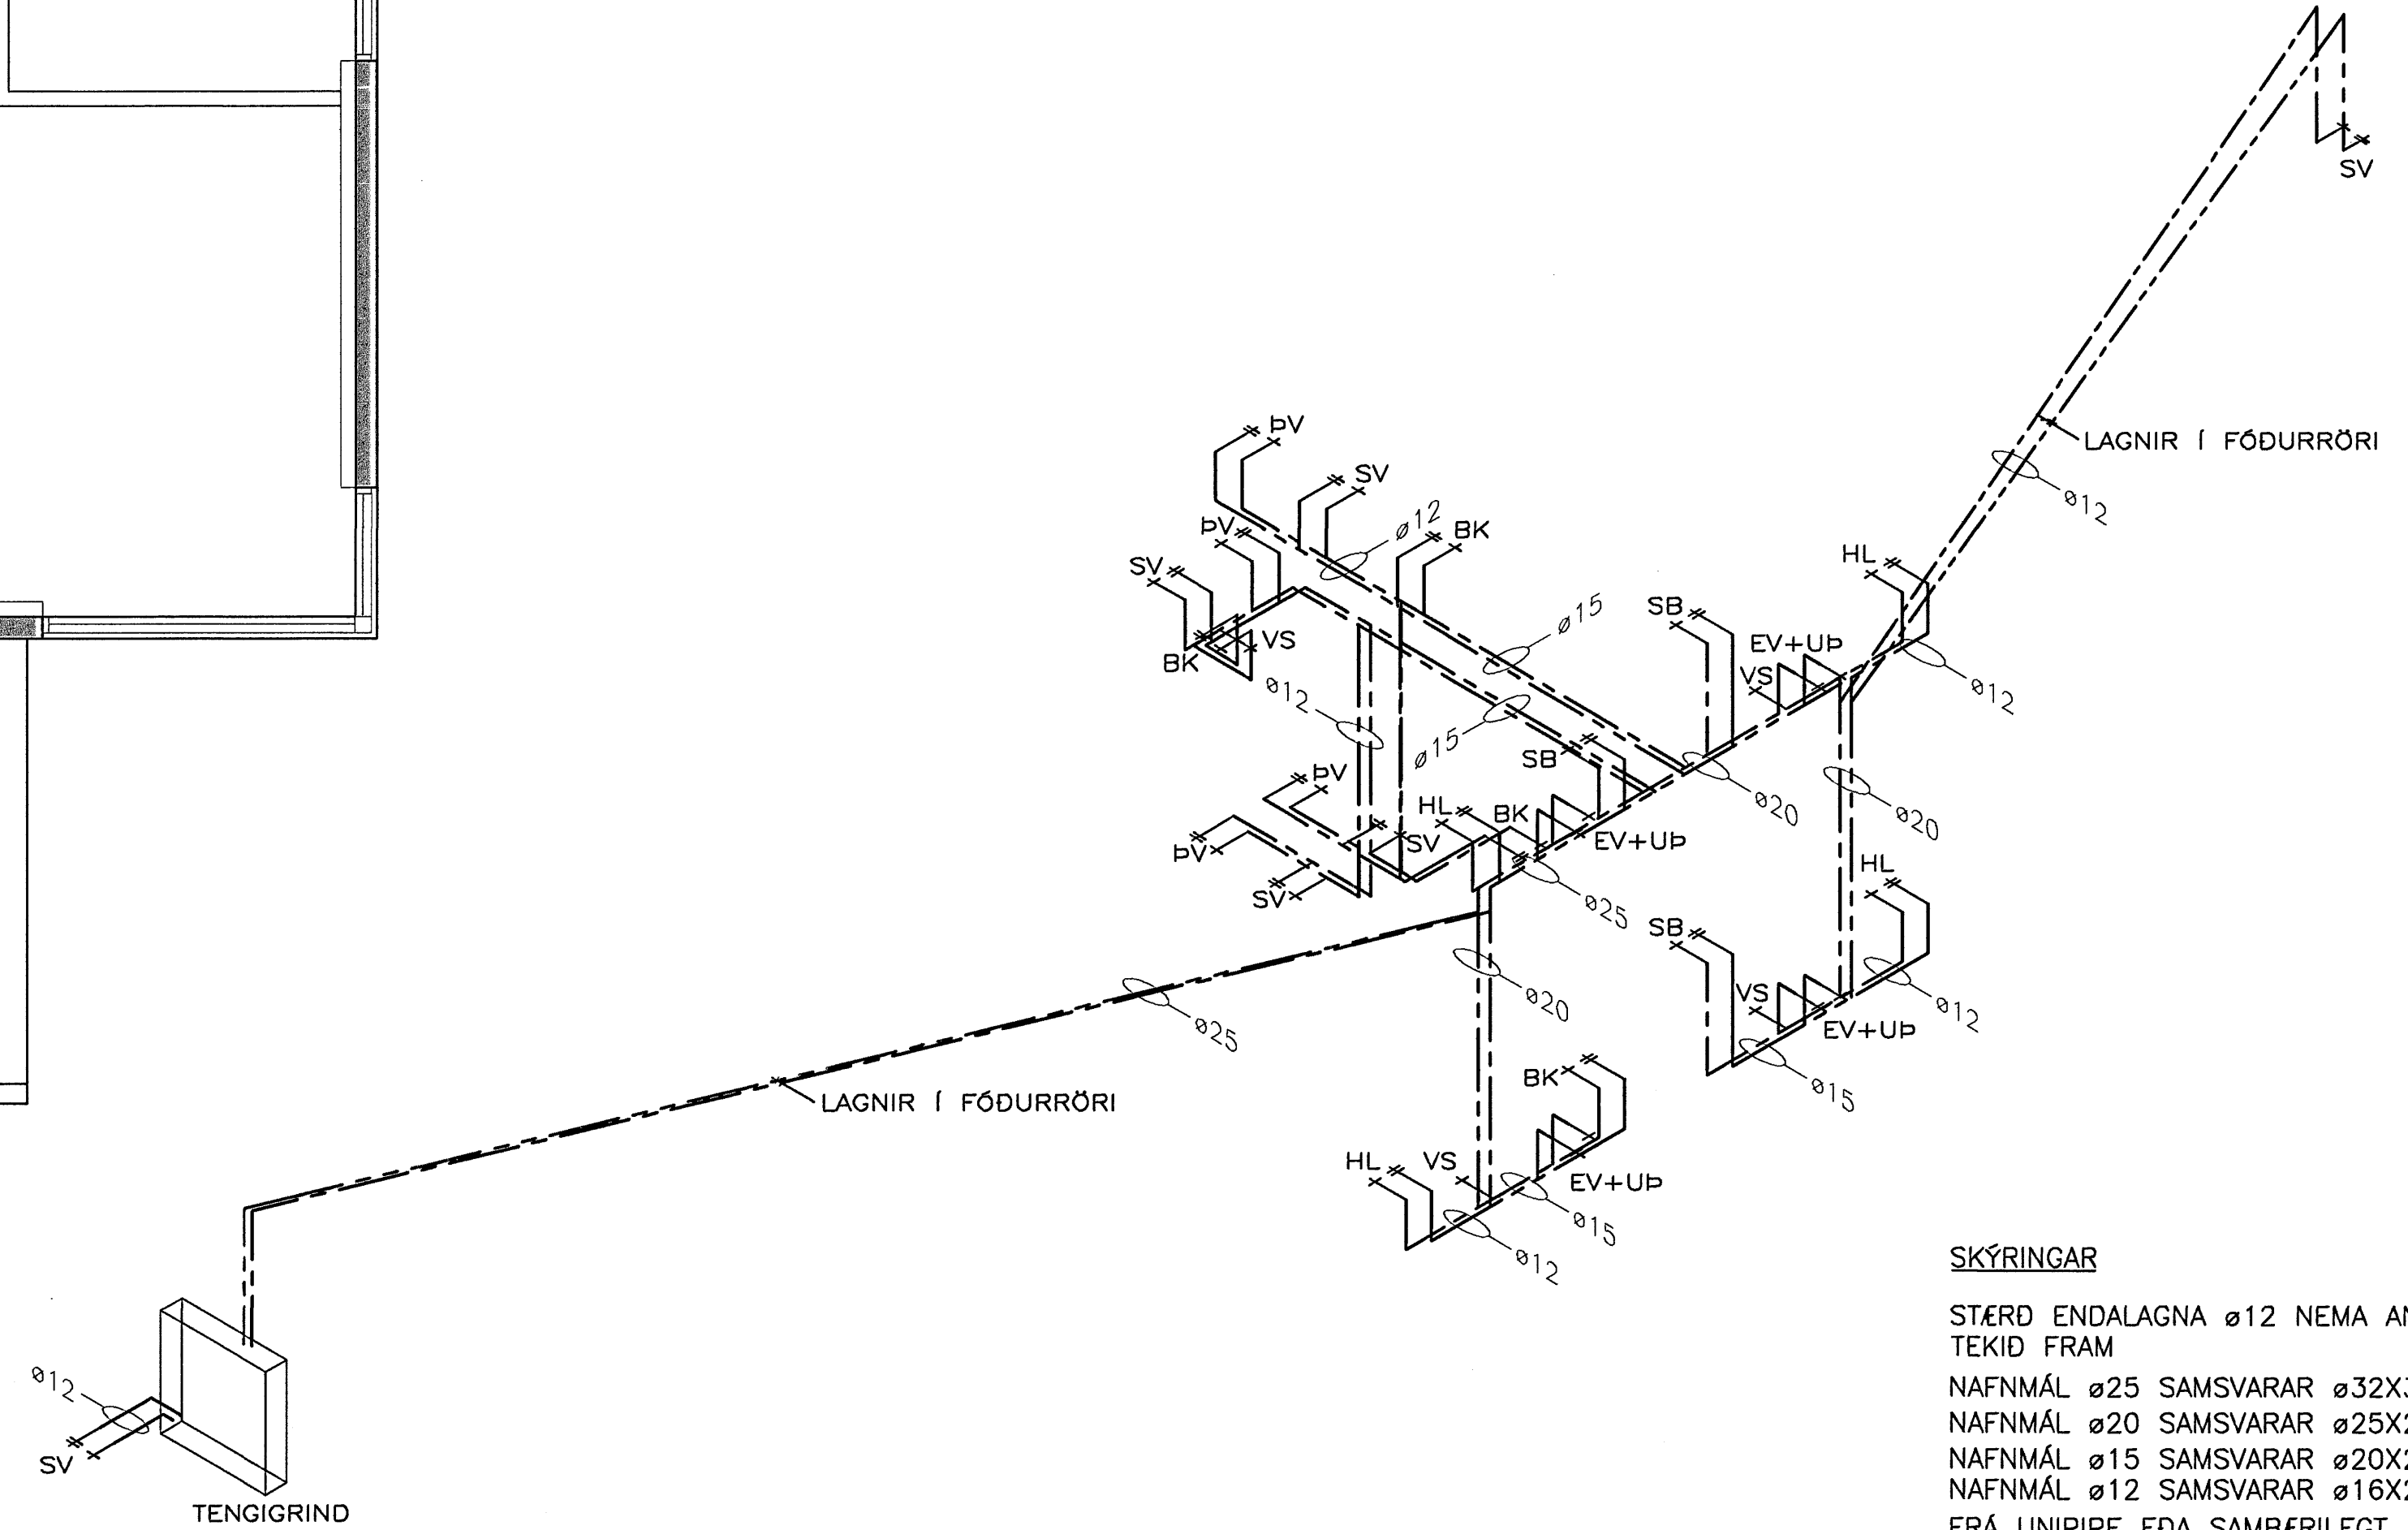

RÖMMYND. 1:50

SKÝRINGAR


STÆRD ENDALAGNA ø12 NEMA ANNAD SÉ TEKID FRAM
 NAFNMÁL ø25 SAMSVARAR ø32X3,0 ALPEX
 NAFNMÁL ø20 SAMSVARAR ø25X2,5 ALPEX
 NAFNMÁL ø15 SAMSVARAR ø20X2,25 ALPEX
 NAFNMÁL ø12 SAMSVARAR ø16X2,0 ALPEX
 FRÁ UNIPIPE EDA SAMBÆRILEGT

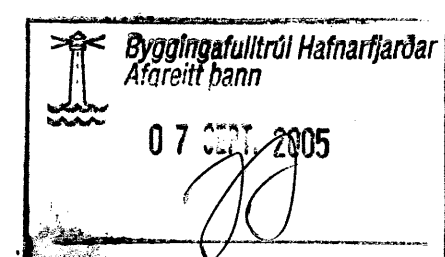

Móttaki:	ASK
Samþ:	5.09.05



VERKFRÆÐIÞJÓNUSTAN EHF

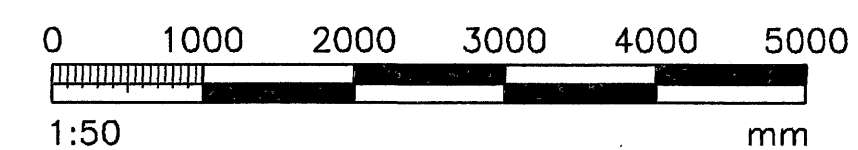

