




DAGR:	NR:	BREYTINGAR:	SAÐP:
01.09.05	△	REYNDARTEKNING	

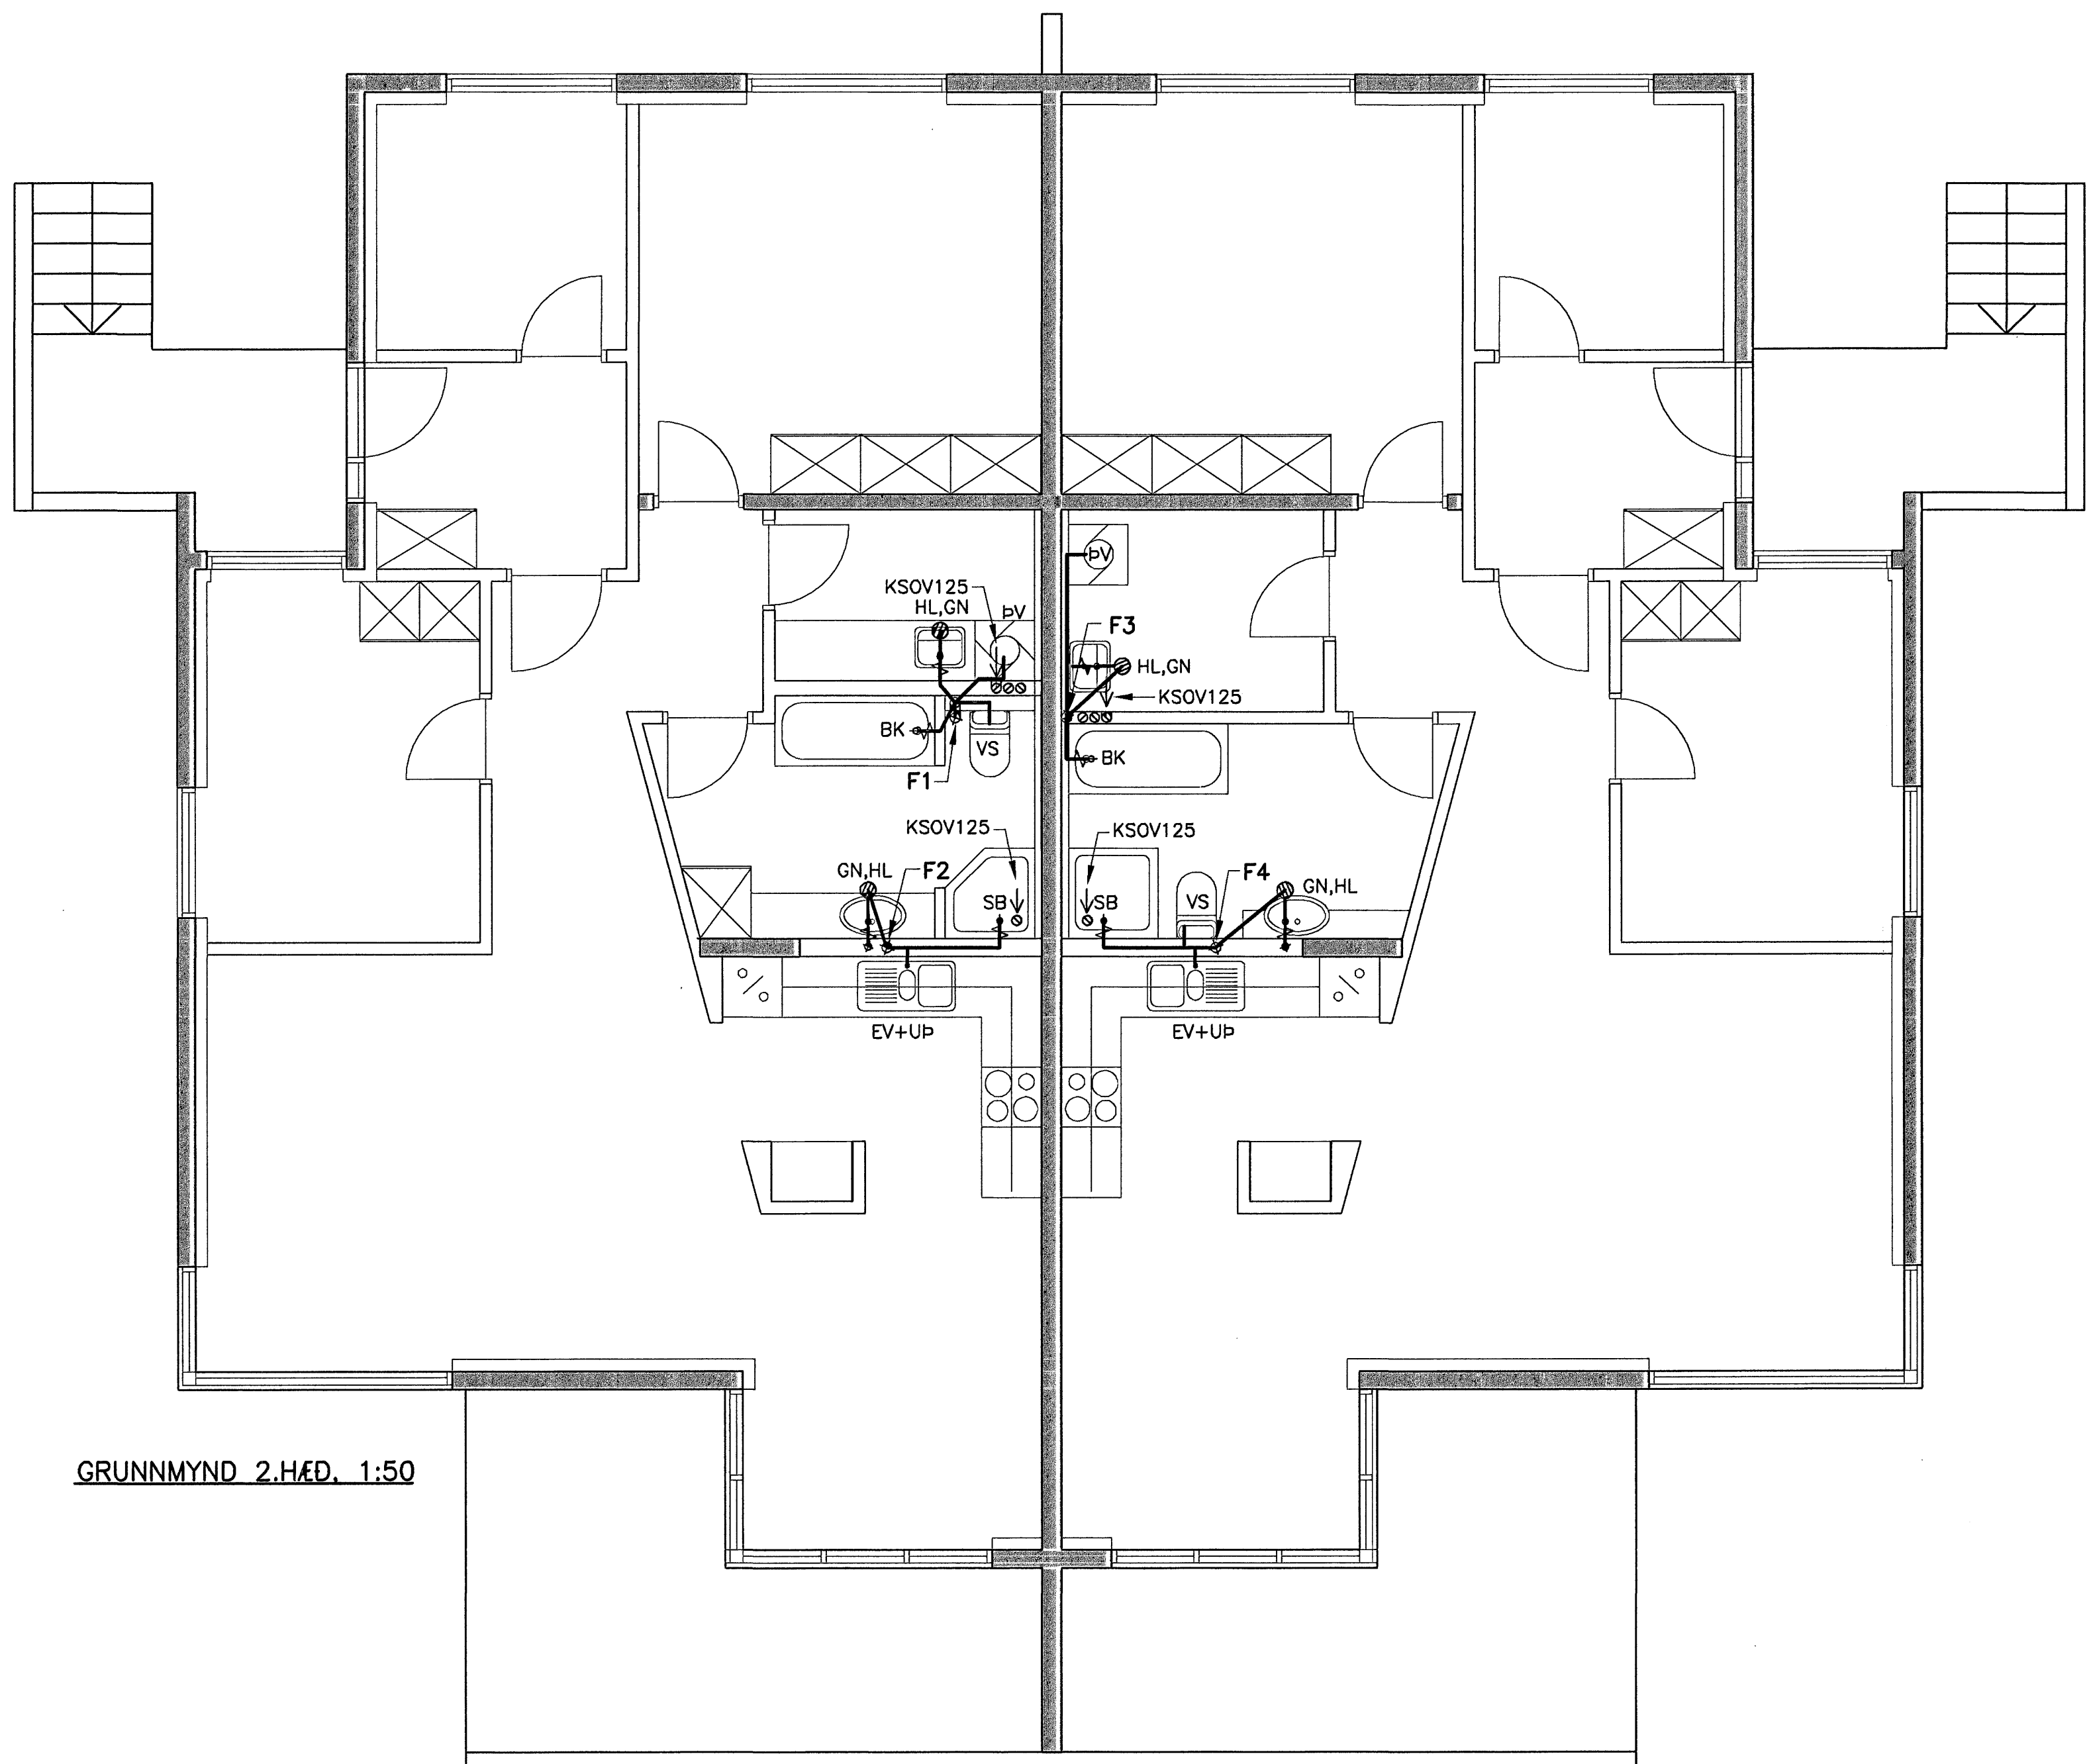

GRUNNMYND 2.HÆÐ. 1:50

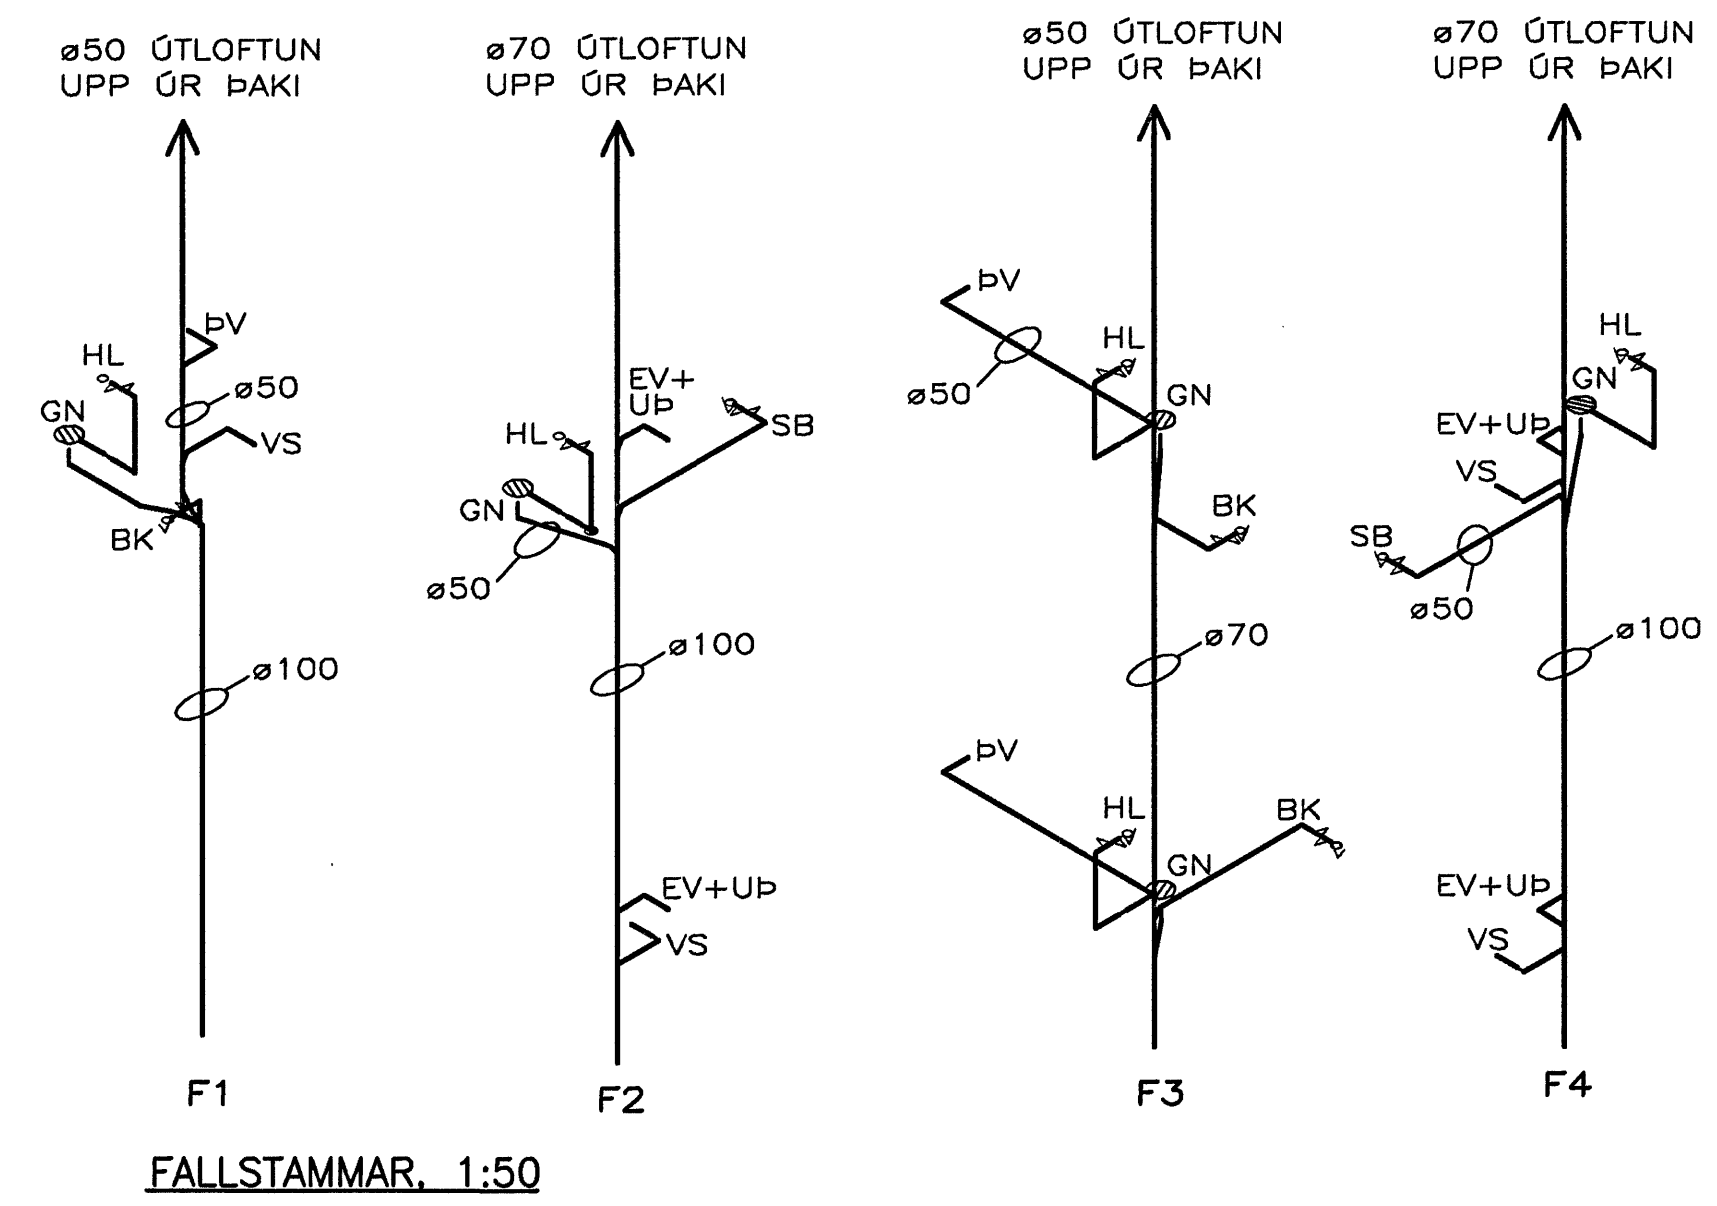

FALLSTAMMAR. 1:50

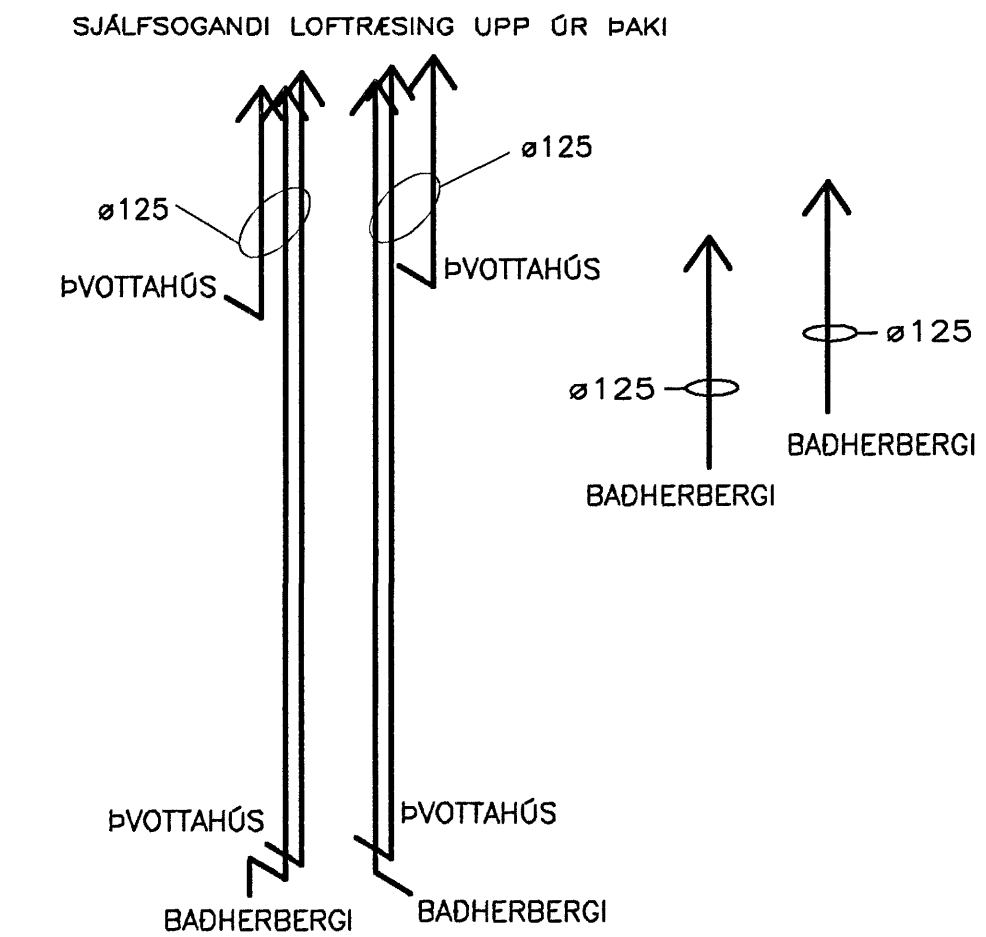


EINLÍNUNUMYND LOFTRÉSING. 1:50

SKÝRINGAR SJÁ TEIKN 301

Byggingafulltrúi Hafnarfjarðar
Algreitt þann
07 SEPT. 2005

Móttekið: **ISK**
Samb.: S. Ö. Ö.
Hafnarfjörður

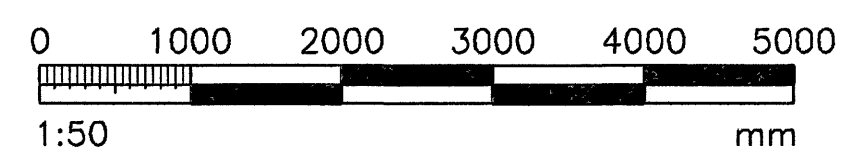

VERKFRÆÐIÞJÓNUSTAN EHF
GRENNASÁVEGUR 3 · 108 REYKJAVÍK · Sími: 500 9980 · Netfang: jona@teknika.is

PROJ. NÖMUR:	15.10.04
LYNGHVAMMUR 6	04.30
HAFNARFJÖRÐUR	321
FRÁVEITU- OG LOFTRÉSISKEMUL:	STEYPT HÚS
2.HÆÐ GRUNNMYND	Jón Guðmundsson
FALLSTAMMAR OG EINLÍNUNUMYND	280255-4329
SKÝRINGAR:	321