



GRUNNMYND
1:50

ATA! FRÁRENNISLÖGN FRÁ HÚSI
SJÁ TEIKNINGU LAENIR Í GRUNNI


SNIB / SVALIR
SJÁ TEIKN. PLATA YFIR SNIB

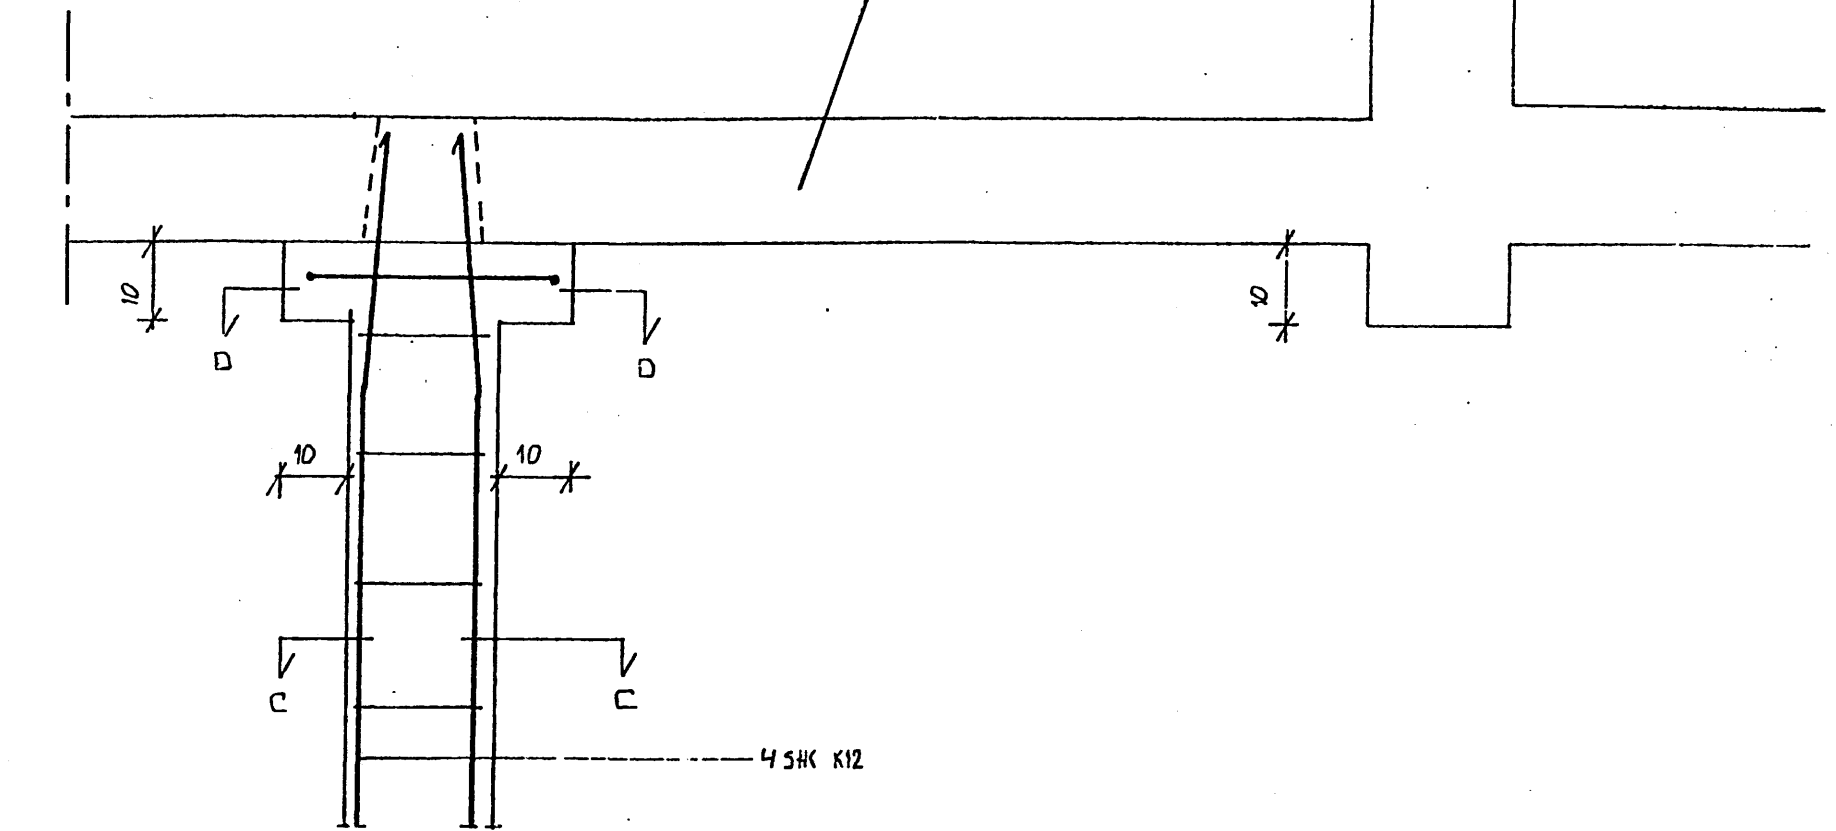


SNIB A-A
1:10

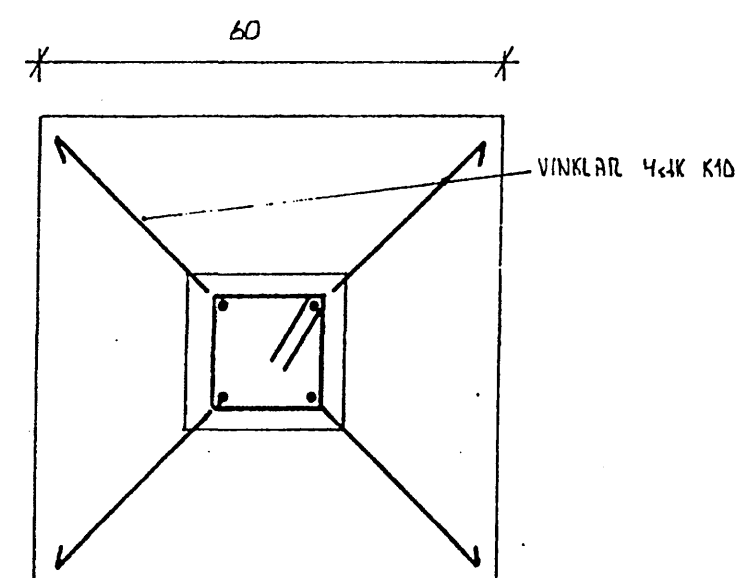


SNIB B-B
SÚLU FÓTUR
1:10

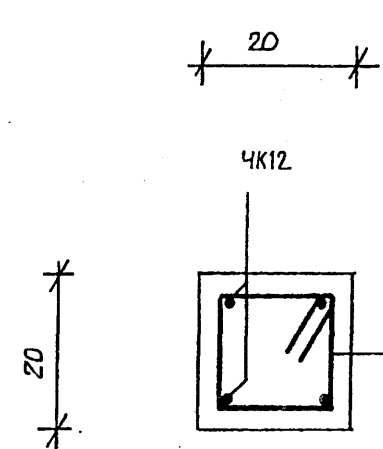

SNIB C-C
SÚLA ÞVERSNIÐ
1:10

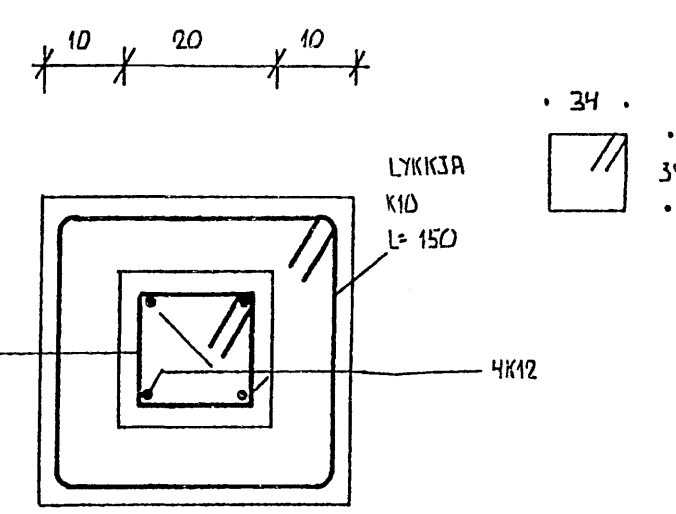

SNIB D-D
SÚLU HAUS
1:10

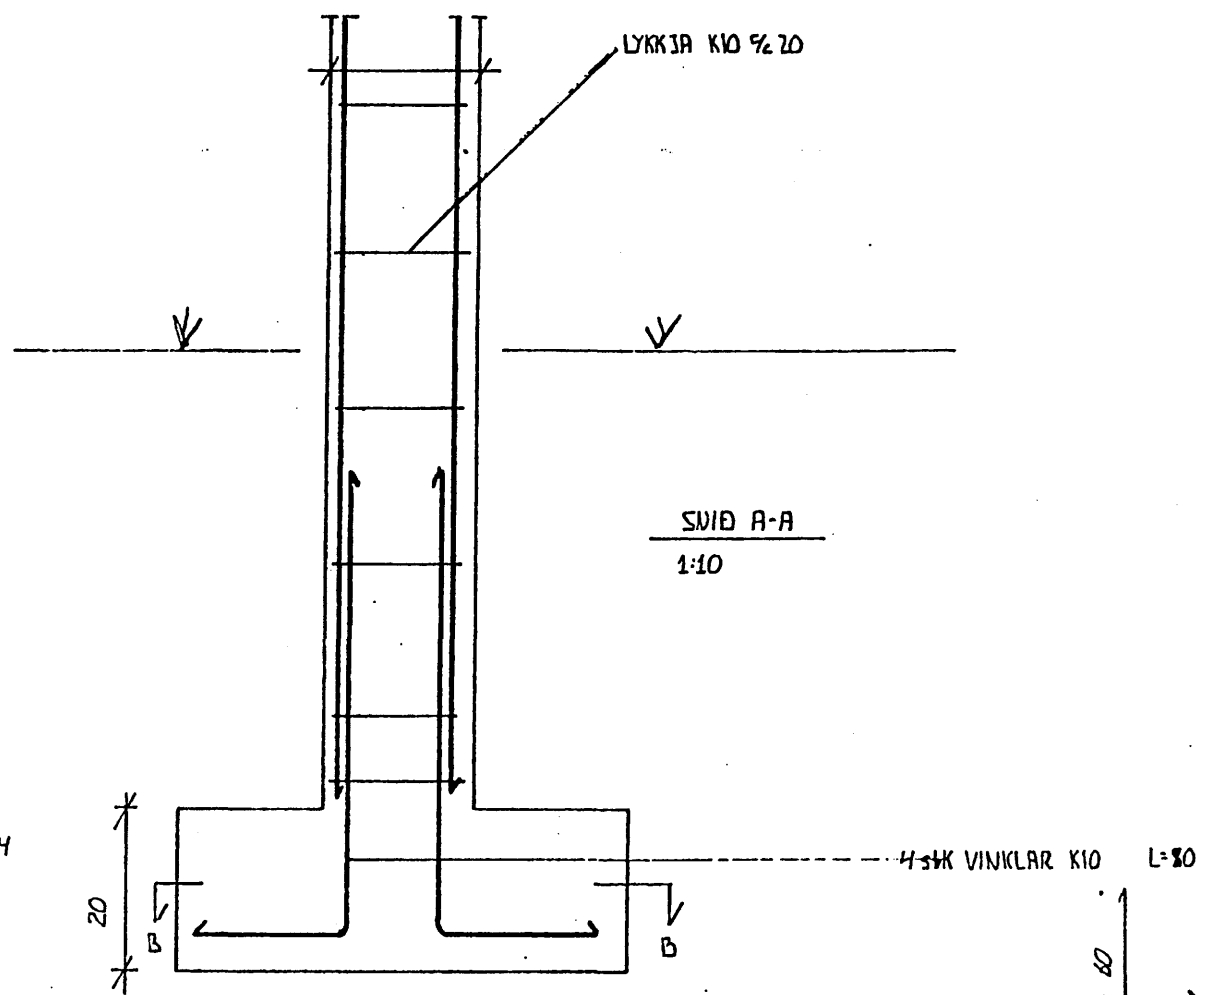

SÚLA S1

Byggingafultrúi Hafnarfjarðar
Alfreitt bann
20. SEPT. 2005

16.09.2005
Eggjalfr Valgússon
NÚ: 280857-4/09

BÆTT VIÐ SÚLU (S2); DAGS.: 16.09.2005	
LÆKJARBERG 25 HAFNARFIRÐI	DAGS JULI '90 MKI 1:50 1:10
SÚLA UNDIR SVALIR	REIÐJ E1 SAMP E1
EYJOLFUR JALGARÐSSON BYGGINGA TEIKNI FRÆÐINGUR	BEIÐARFRÁVAÐI 2 SÍM 54793