


Breytingar:
 (a) 14.08.05 Vindstýfum breytt og gluggum í þeim bilum
 (b) 13.11.05 Vindstýfum breytt.

Verk. 556-17 Steinhella 8, Hafnarfirði.

Teikning: Langveggir

Mál: 1:50
 Dags: 10.08.05 (a) 14.8.05 (b) 13.11.05

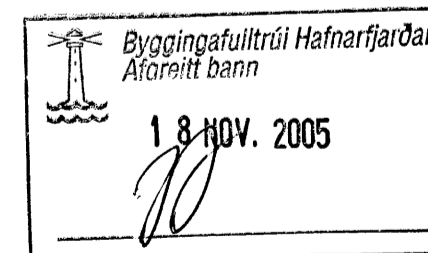

Guðmundur Gunnarsson
 byggingaverkfræðingur
 Langagerði 15
 108 Reykjavík
 sími/fax 5888786
 GSM 897 8786
 kt. 010754-5939
 netfang noinoi@simnet.is