



ÁRITUN BYGGINGARFULLTRÚA

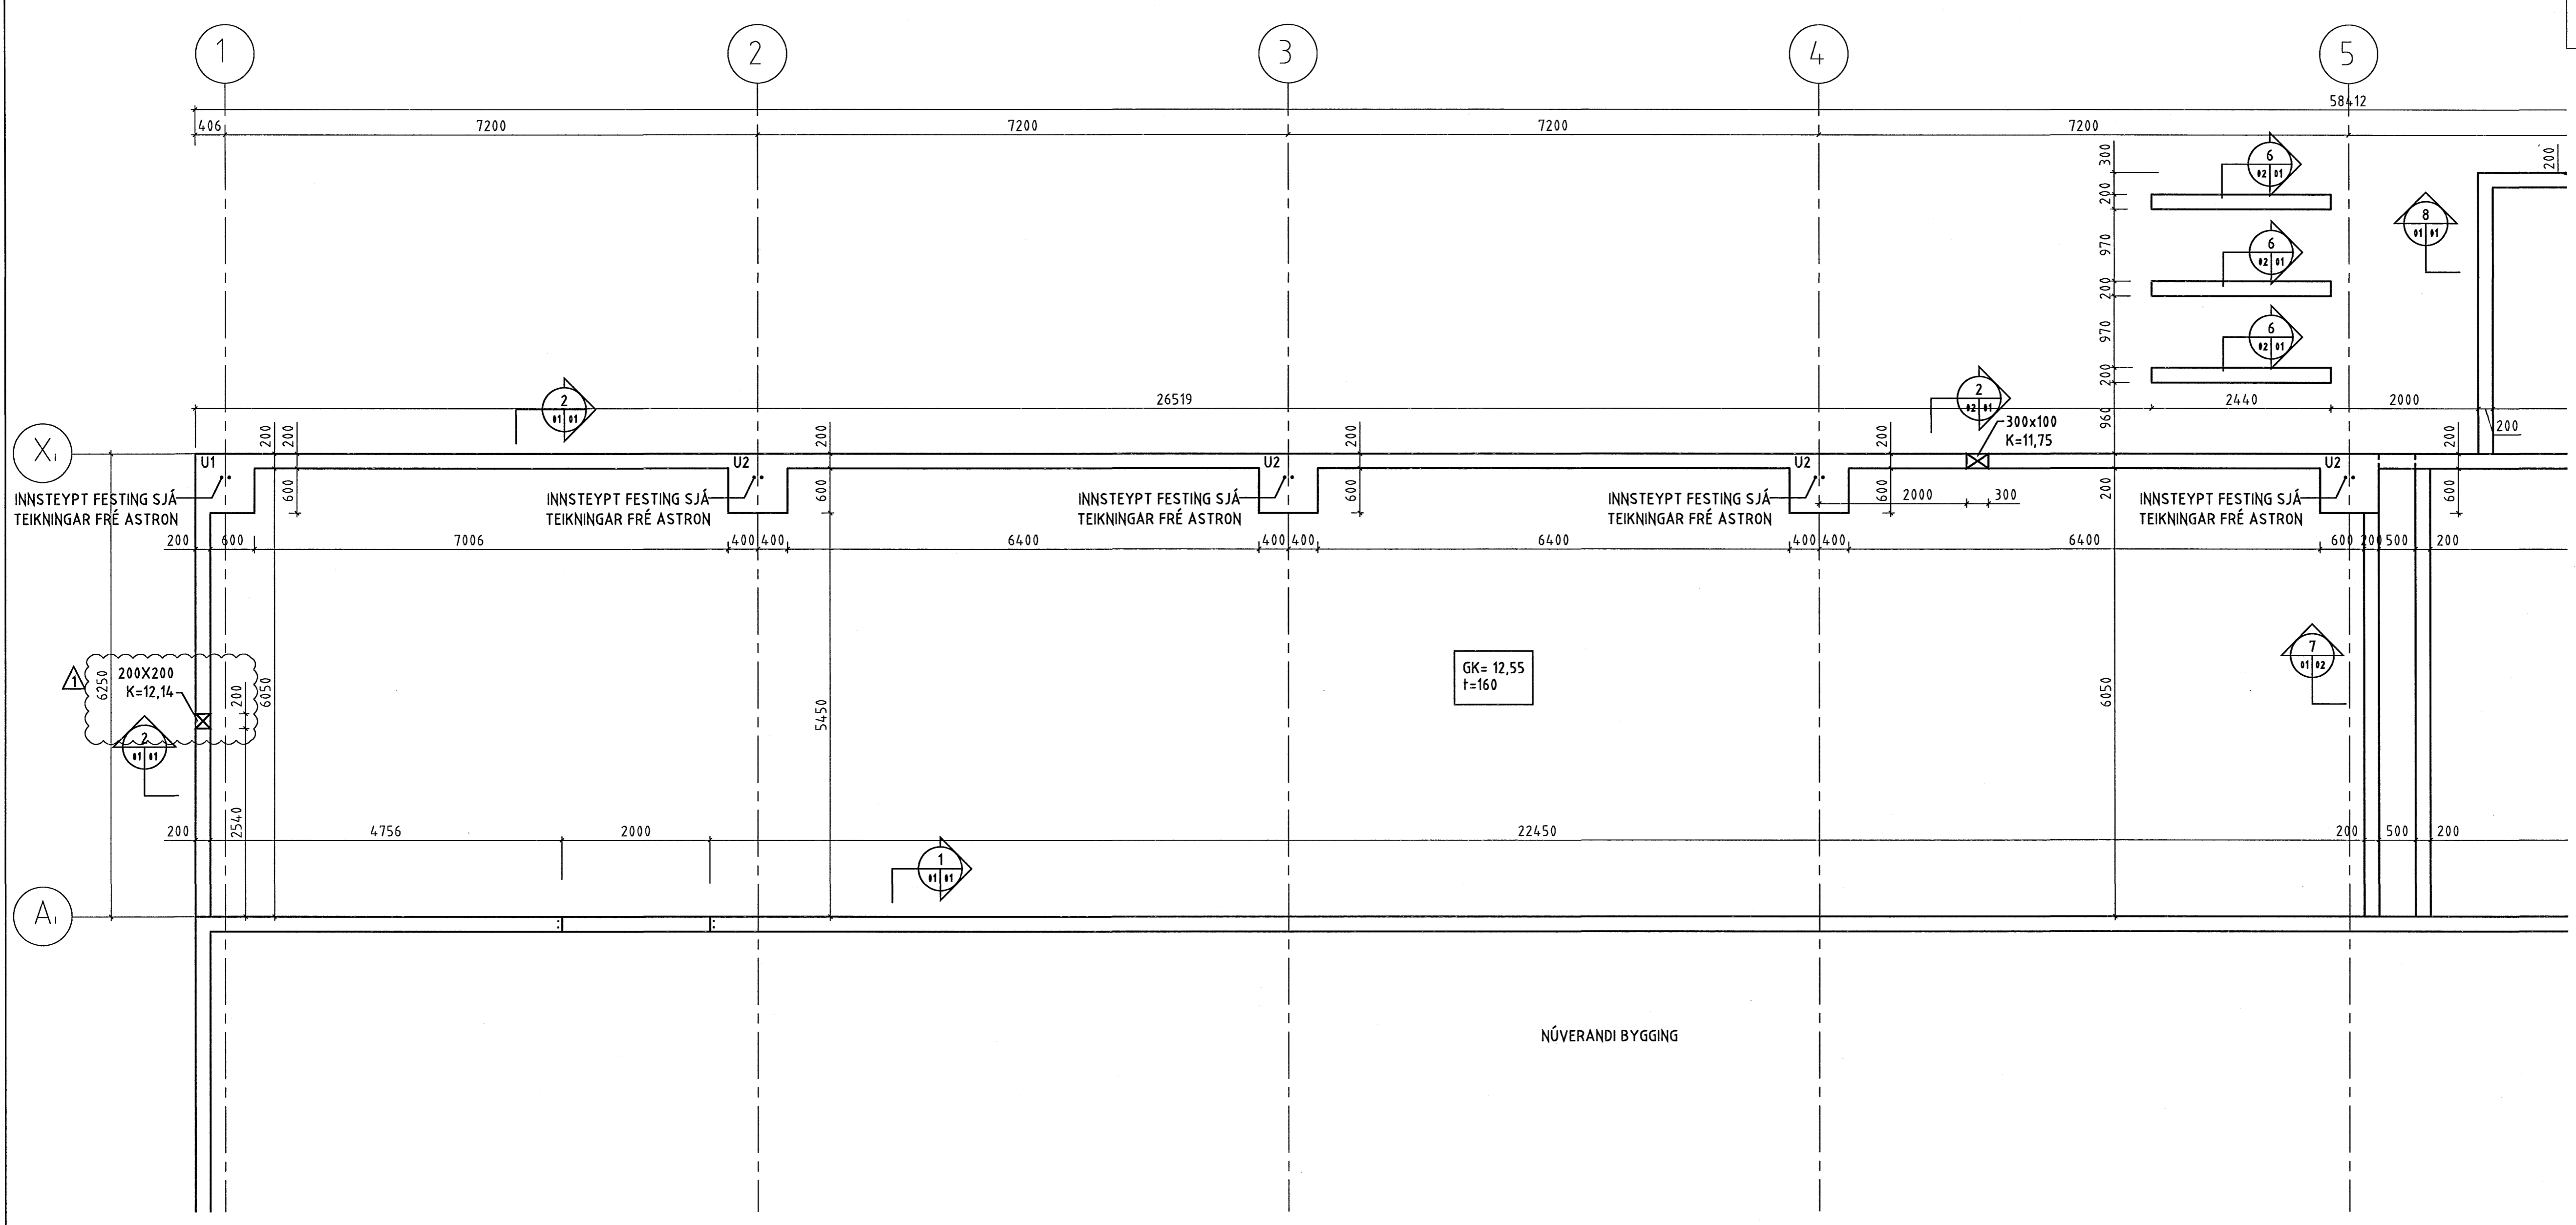


Byggingafultrúi Hafnarfjarða
Alfreitt barn
30 MARS 2006
VFS


1
01/01 M 1:20

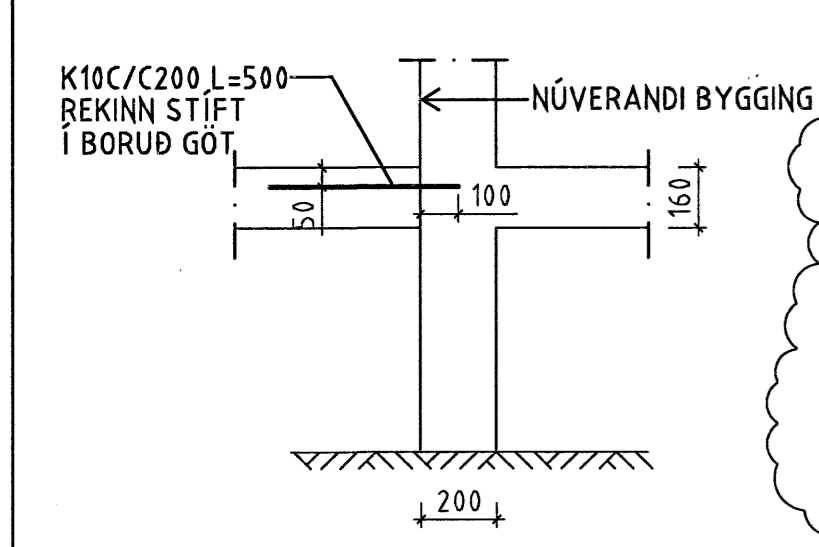


2
01/01 M 1:20

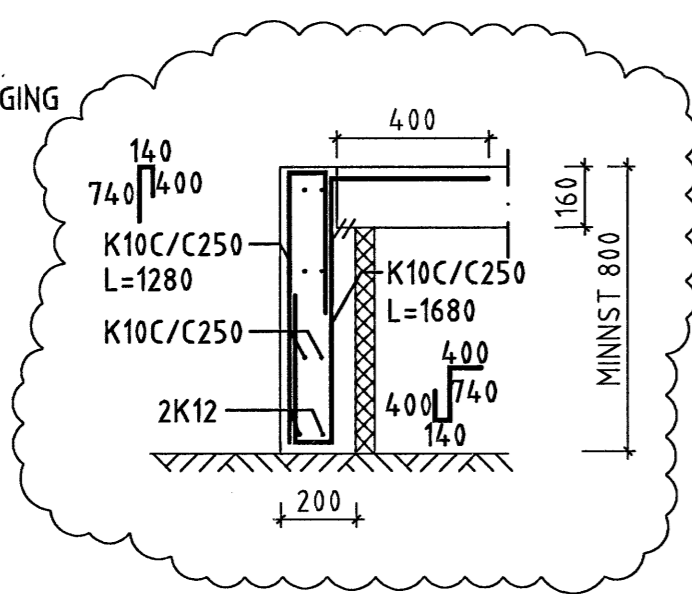


3
01/01 M 1:20

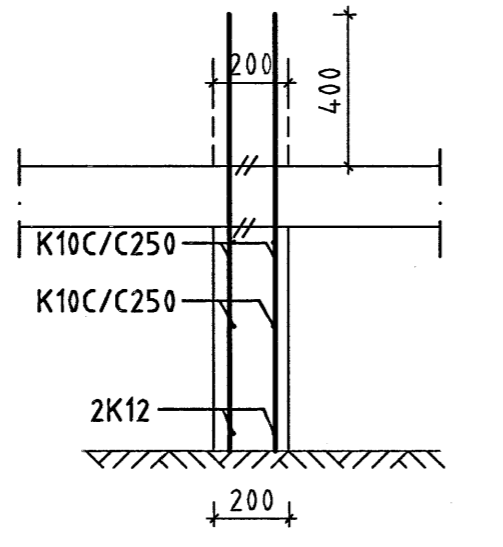


4
01/01 M 1:20

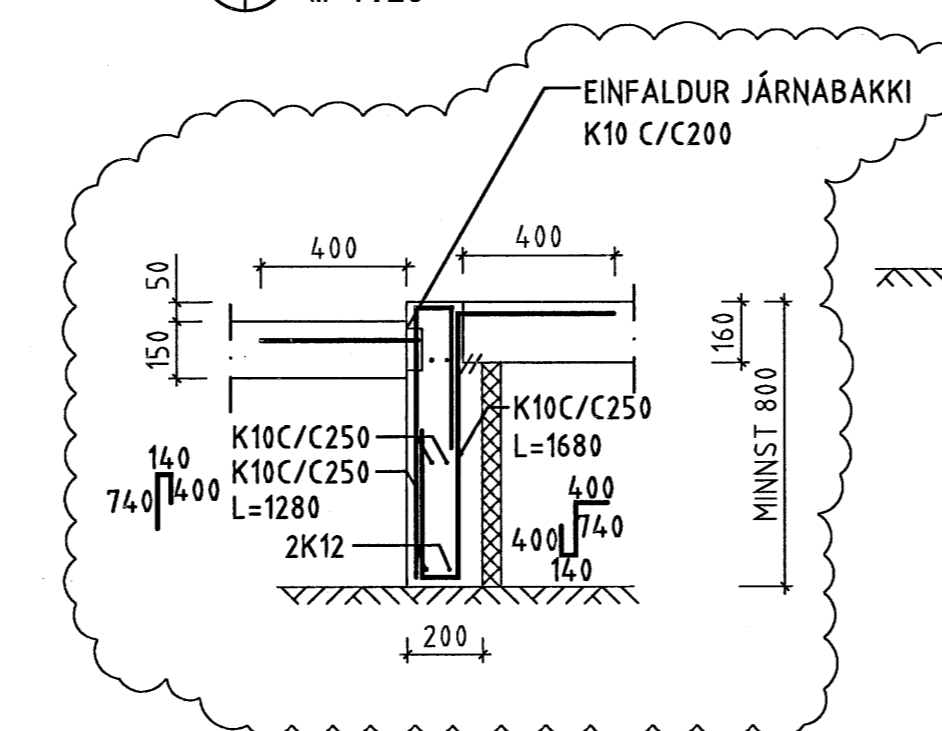


5
01/01 M 1:20

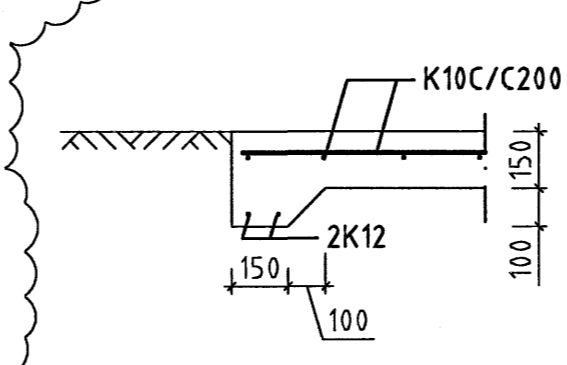

6
01/01 M 1:20

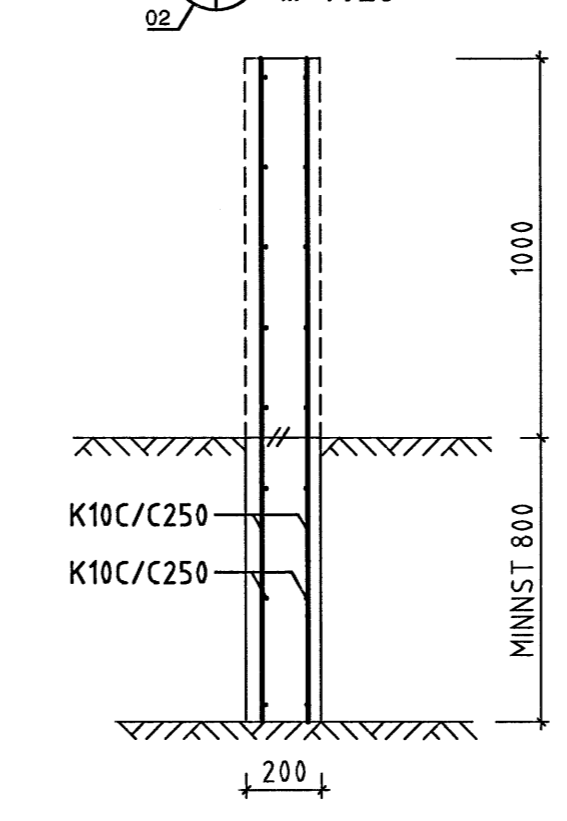

SNID Í GÓLFPLÖTU M 1:10

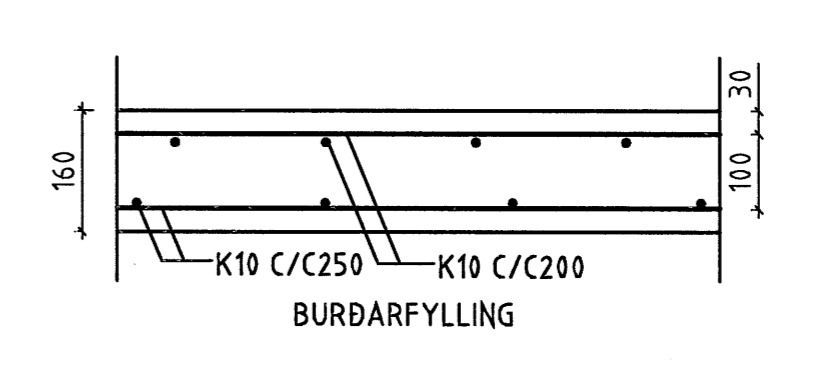

ÁRITUN ABALHÖNUBAR KT
110254-3346
SJÁ SKÝRINGAR Á TEIKN NR. -1-00

1	17.03.06	SNID 2 OG 4, GAT Í SÖKKUL	
NR	DAGS	BREYTING	SAMP



ÍSHELLA 8
STÆKKUN
GRUNNMYND
UNDIRSTÖÐUR

MKV	TEKN/HÖNN	DAGS ÚTG	TEIKN NÚMÉR
1:50, 1:20, 1:10	JBP/FpS	08.03.06	1077-1-01
ÁRITUN ABALHÖNUBAR	KT		SAMPYKKT
HÖNNUÐUR BREYTINGAR	171260887	DAGS BREYTINGAR	BREYTING NR
		17.03.06	1

Ferill ehf. Mörkin 1 108 Reykjavík Sími: 575-1614 Fax: 575-1611 Netfang: ferill@ferill.is