


SNID 7-7 1:10

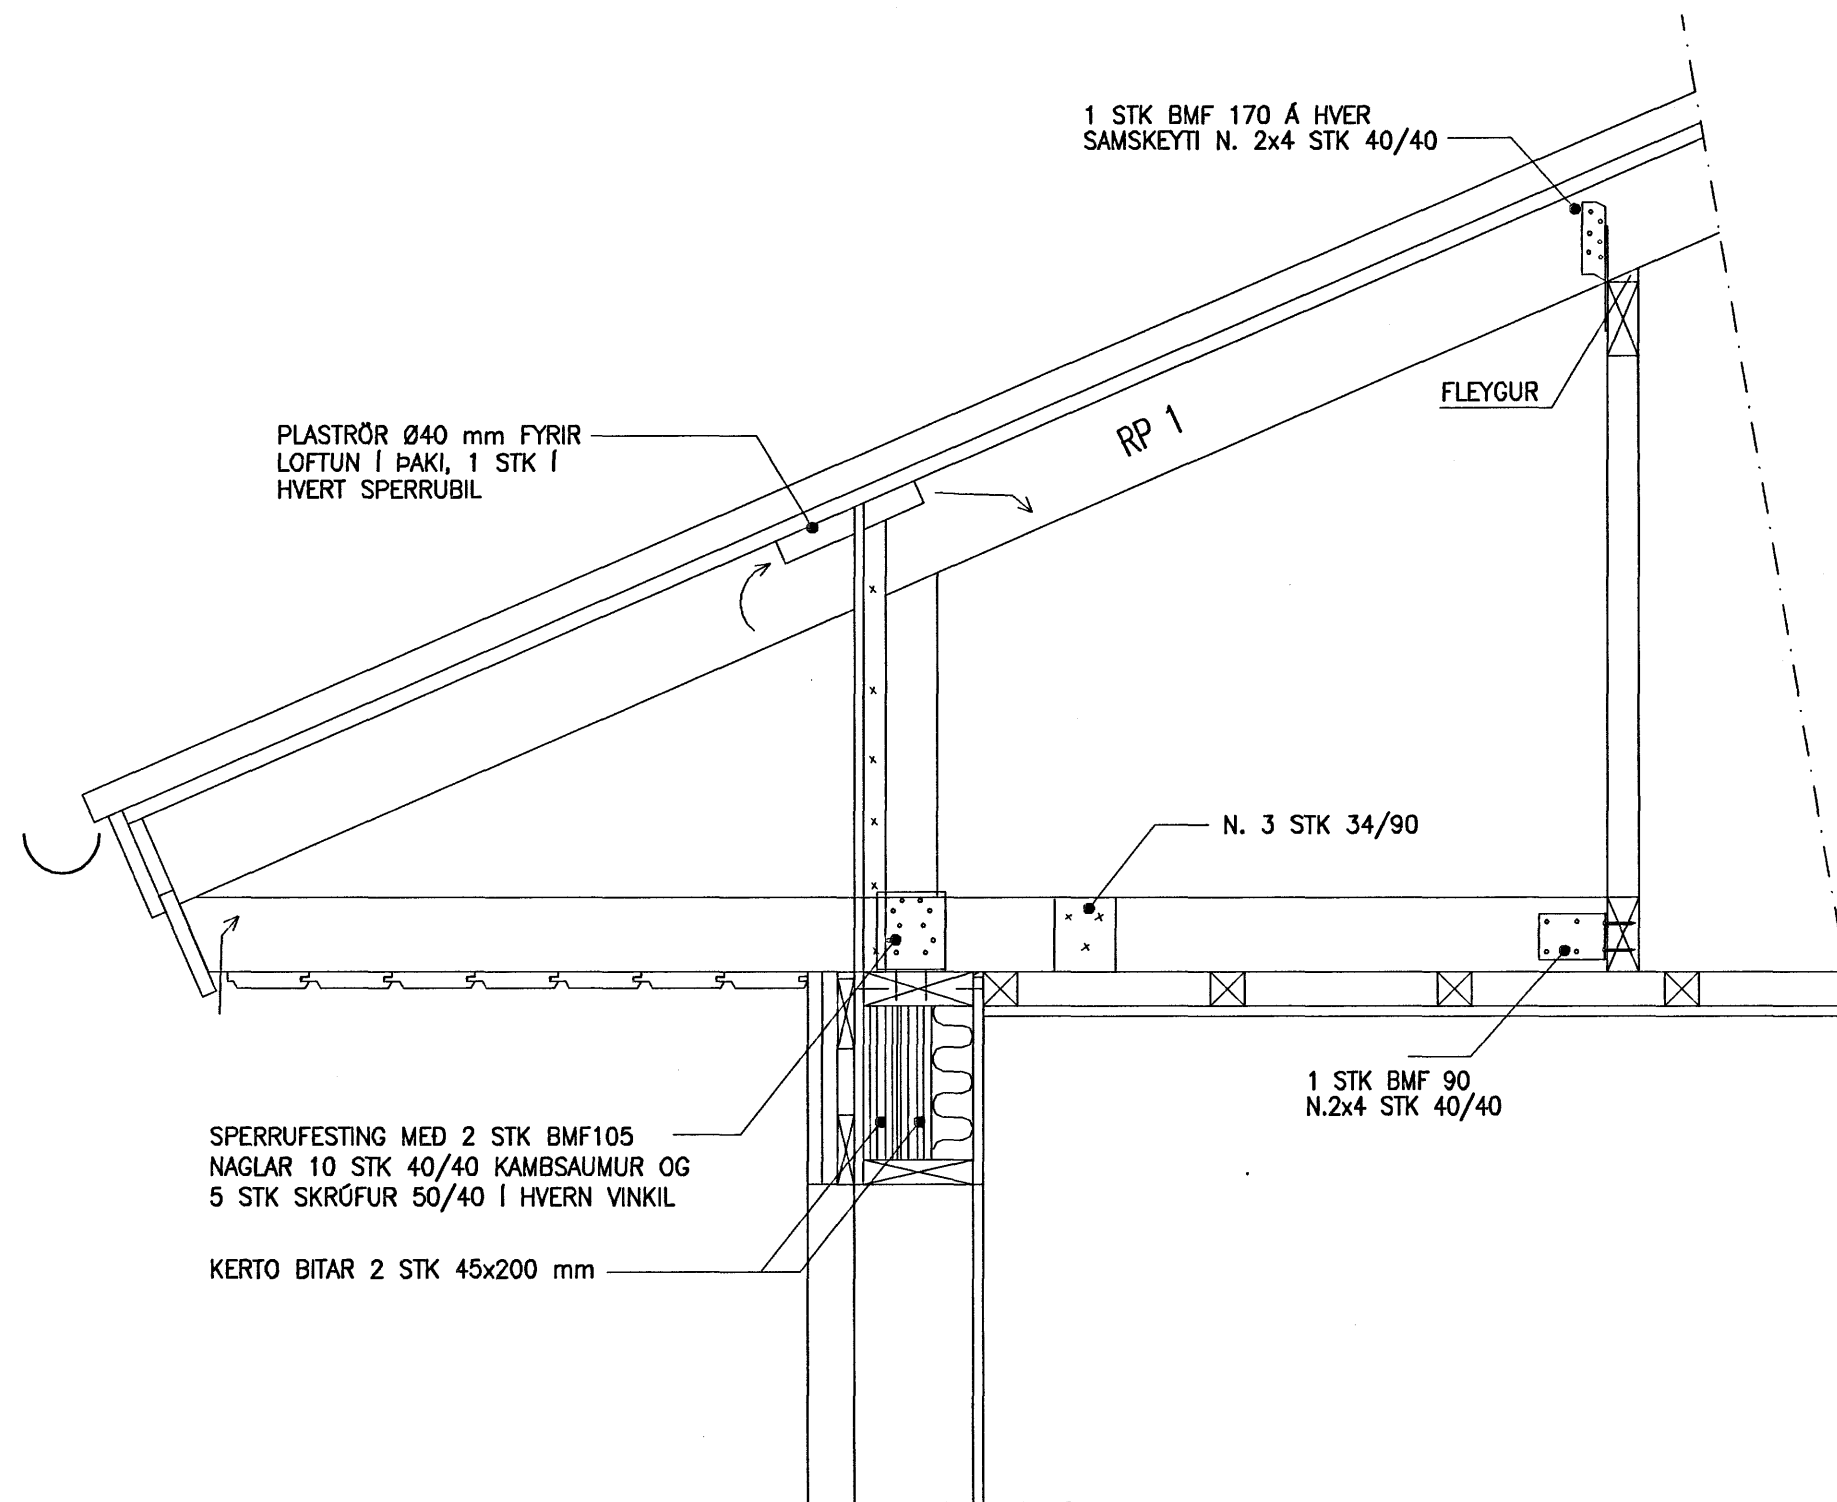

SNID 8-8 1:10

Byggingafultrúi Hafnarfjarðar
Afgreitt bann
19 JAN 2006

| NR. | DAGS. | BREYTING |
|-----|----------|----------------------|
| A | 09.01.06 | BREYTT LOFTUN Í ÞAKI |

SKÝRINGAR

10/1/06

SEMUNDUR EIRIKSSON 261249-2949

FLÉTTUVELLIR 9
220 HAFNARFJÖRÐUR

KLÖPP

KLÖPP ARKITEKTAR-VERKFRÆÐINGAR EHF
NETHYL 2, PÓSTHÓLF 10050, 110 REYKJAVÍK
SÍMI 577 2277, 699 7747 FAX 577 2280

HEITI TEIKN. BURDARÞÓL
SNID OG SÉRMYNDIR

MELIKVARDI 1:10 DAGS. DES 2005

TEIKNING B 024 VERK V 05-310
BREYTING A YFIRFARID S.E.