

SNID 9-9 1:10

SNID 10-10 1:10


NR.	DAGS.	BREYTING
A	09.01.06	BREYTT LOFTUN Í ÞAKI

SKÝRINGAR

10/1 '06

SÆMUNDUR EIRIKSSON 261249-2949

FLÉTTUVELLIR 9
220 HAFNARFJÖRÐUR

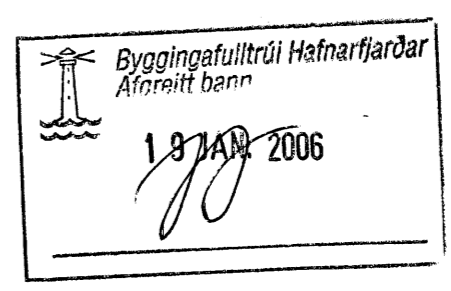

KLÖPP

KLÖPP ARKITEKTAR-VERKFRÆÐINGAR EHF
NETHYL 2, PÓSTHÓLF 10050, 110 REYKJAHÖK
SÍMI 577 2277, 699 7747 FAX 577 2280

HEITI TEIKN.	BURDARÞOL SNID OG SÉRMYNDIR
MÆLIKVARDI	1:10 DAGS. DES 2005
TEIKNING	B 025 VERK V 05-310
BREYTING	A YFIRFARID S.E.