



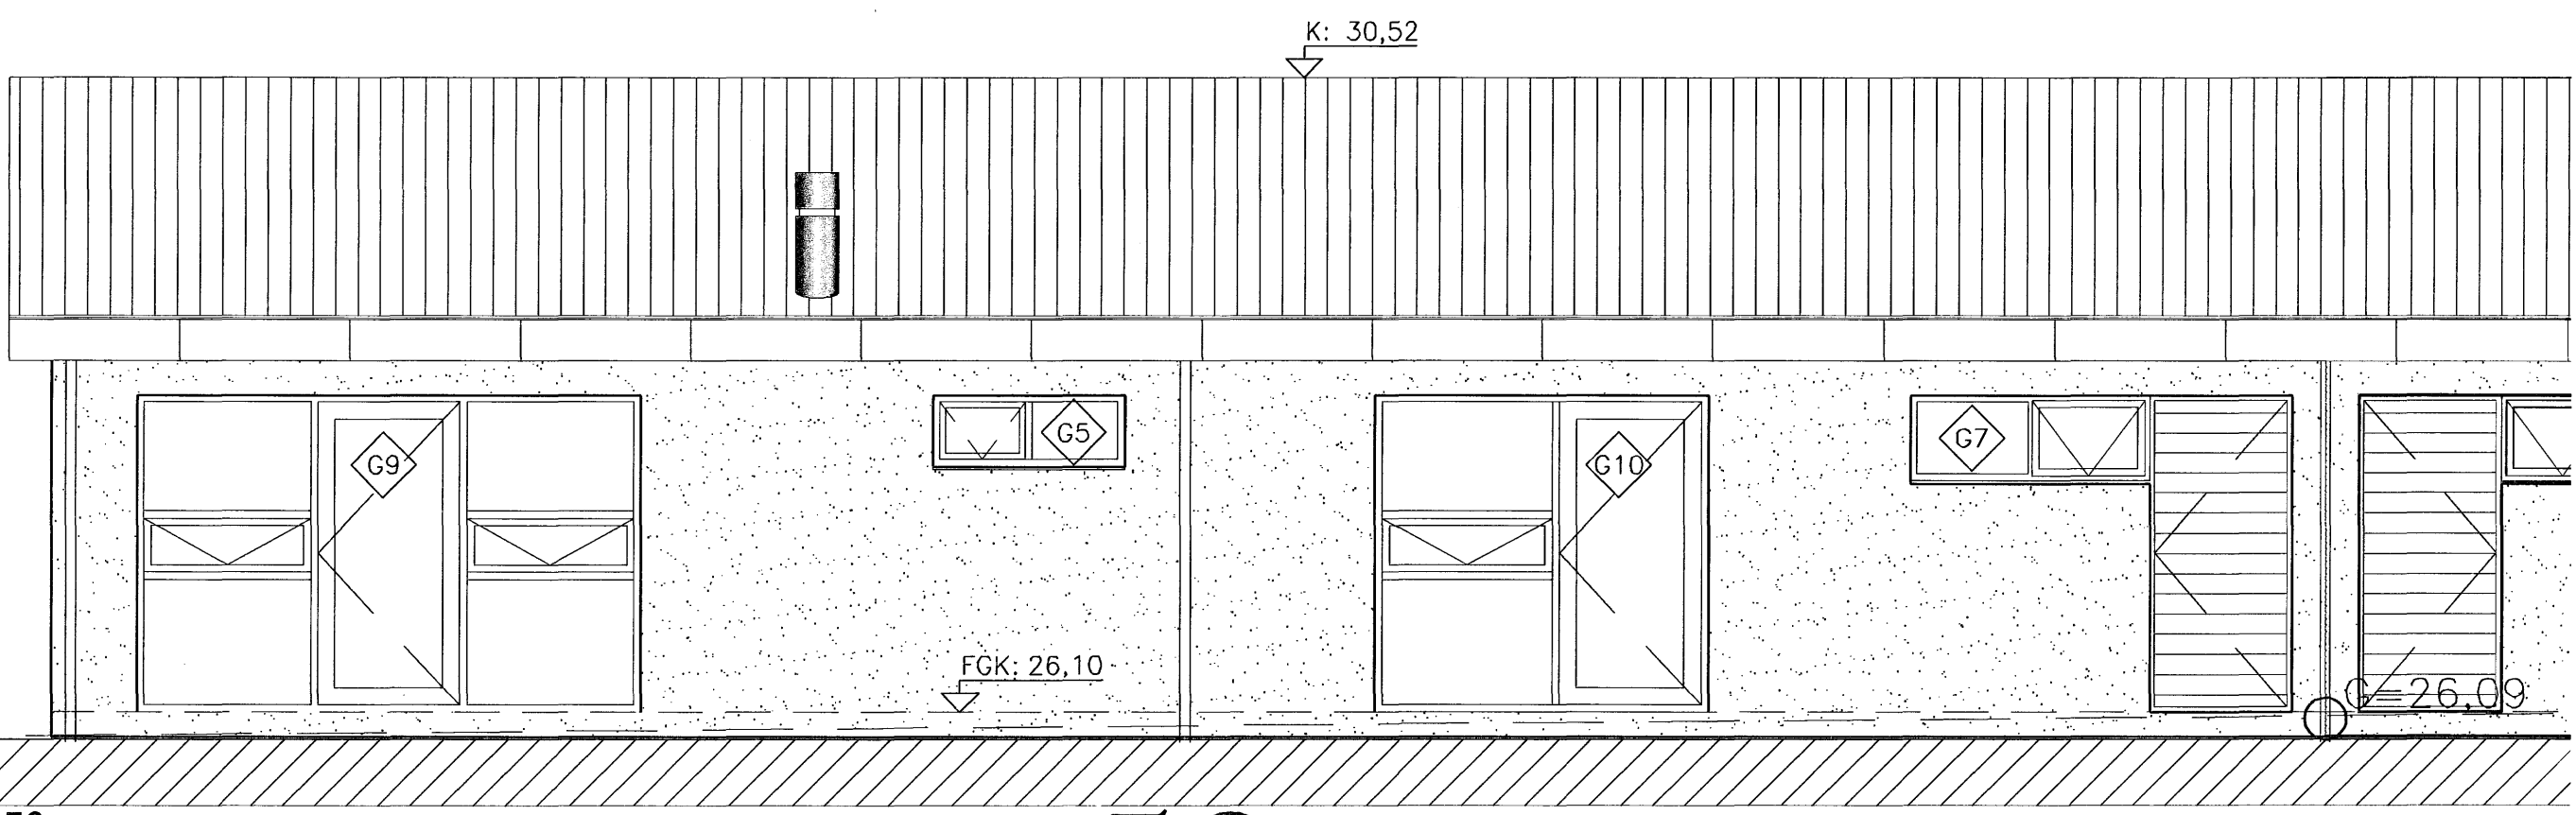





Samþykkt þann
31 JULI 2007
 Byggingfulltrúinn í Hafnarfirði
 F.h.Sigurbjartur Halldórsson

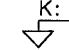

- TÁKN Á UPPDRÆTTI:
-  K: 74,20 HÆDARKÓTI
 -  FGK: 00,00 FGK=FULLBÚINN GÓLF KÓTI
 -  G2 GLUGGA/HURDANÓMER
 -  B1 BREYTINGARNÓMER
 -  03 DEILITEIKNINGARNÓMER
13 TEIKNINGARNÓMER

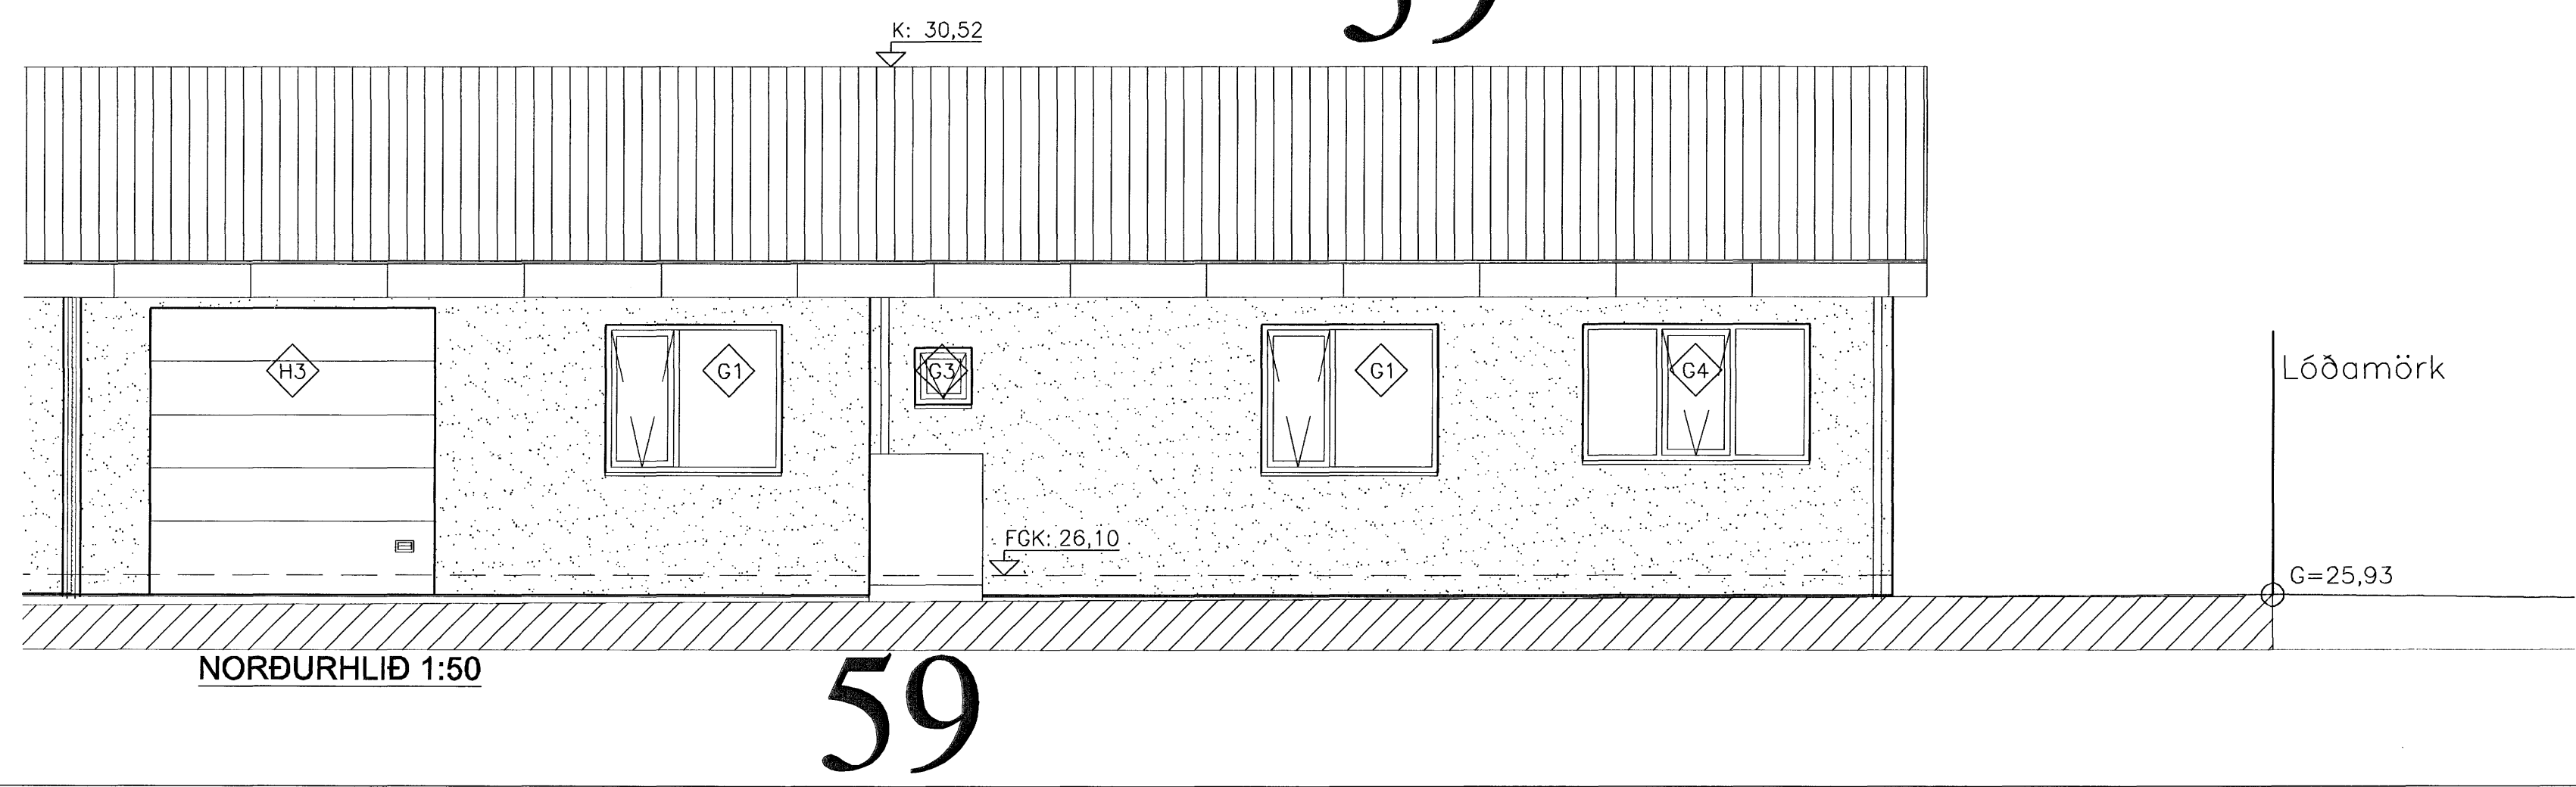

BREYTT				
1) 16.04.07 Þakklæðingu og þakkanti breytt DK				
HEITI VERKS: Drekavellir 55-59 (59)				
HEITI TEIKNINGAR: 220, Hafnarfjörður				
ÚTLITSMYNDIR				KVAFRI: 1:50
HANNAÐ: DKK	TEIKNAD: DKK	VERKNR: 1.087	BREYTINGNR: 00	DAGS: 31.10.2006
SAMPYKKT: 				TEIKN. NR: 09
TEIKNISTOFAN H.R. ehf Húsbyggingar og ráðgjöf David Karlsson Byggingafræðingur BFI Næfurás 2, 110 Reykjavík				
SIMI: 567 6111 FAX: 567 6111 E-MAIL: dkk@internet.is KT: 231256-2539				