


Mött 26/7 2007
 G. Hall

FLENSBOGARGSKÓLI

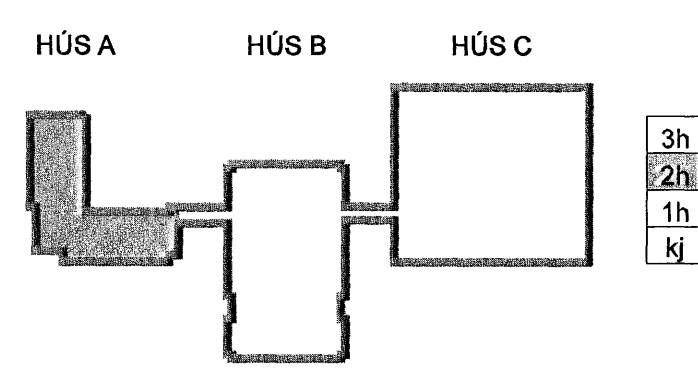

A 28.08.07 FJÖLGUN GREINA BSG/ÖG
 Útg. Dags. Skýring Hannas/Yfirfaró
 ARKITEKTASTOFAN ÖG VSB
 Söltunil 1, 105 Reykjavík
 KÍ 020235-4629
 VERKFRÆÐISTOFA

BÆJARHRAUN 20 · 220 HAFNARFJÖRÐUR · KENNIT. 710796-2899
 vsb@vsb.is · Sími 585 8600 · Fax 585 8610 · www.vsb.is

Áritun sérhönnuðar		Örn Guðmundsson Kt: 220861-2739	
Verkefni			
BREKKUGATA 19 HAFNARFJÖRÐUR			
Verkhúð			
RAFKERFI EINLÍNUMYND GREINATAFLA A2-T2			
Hannas	Teiknað	Yfirfaró	Kvarði
BSG	BSG	ÖG	-
Dags.	Verkefni	Teikning	Útgáfa
03.02.2006	04836	A-R1-E3-1	A