



SNID D-D - ÚTLIT AUSTUR

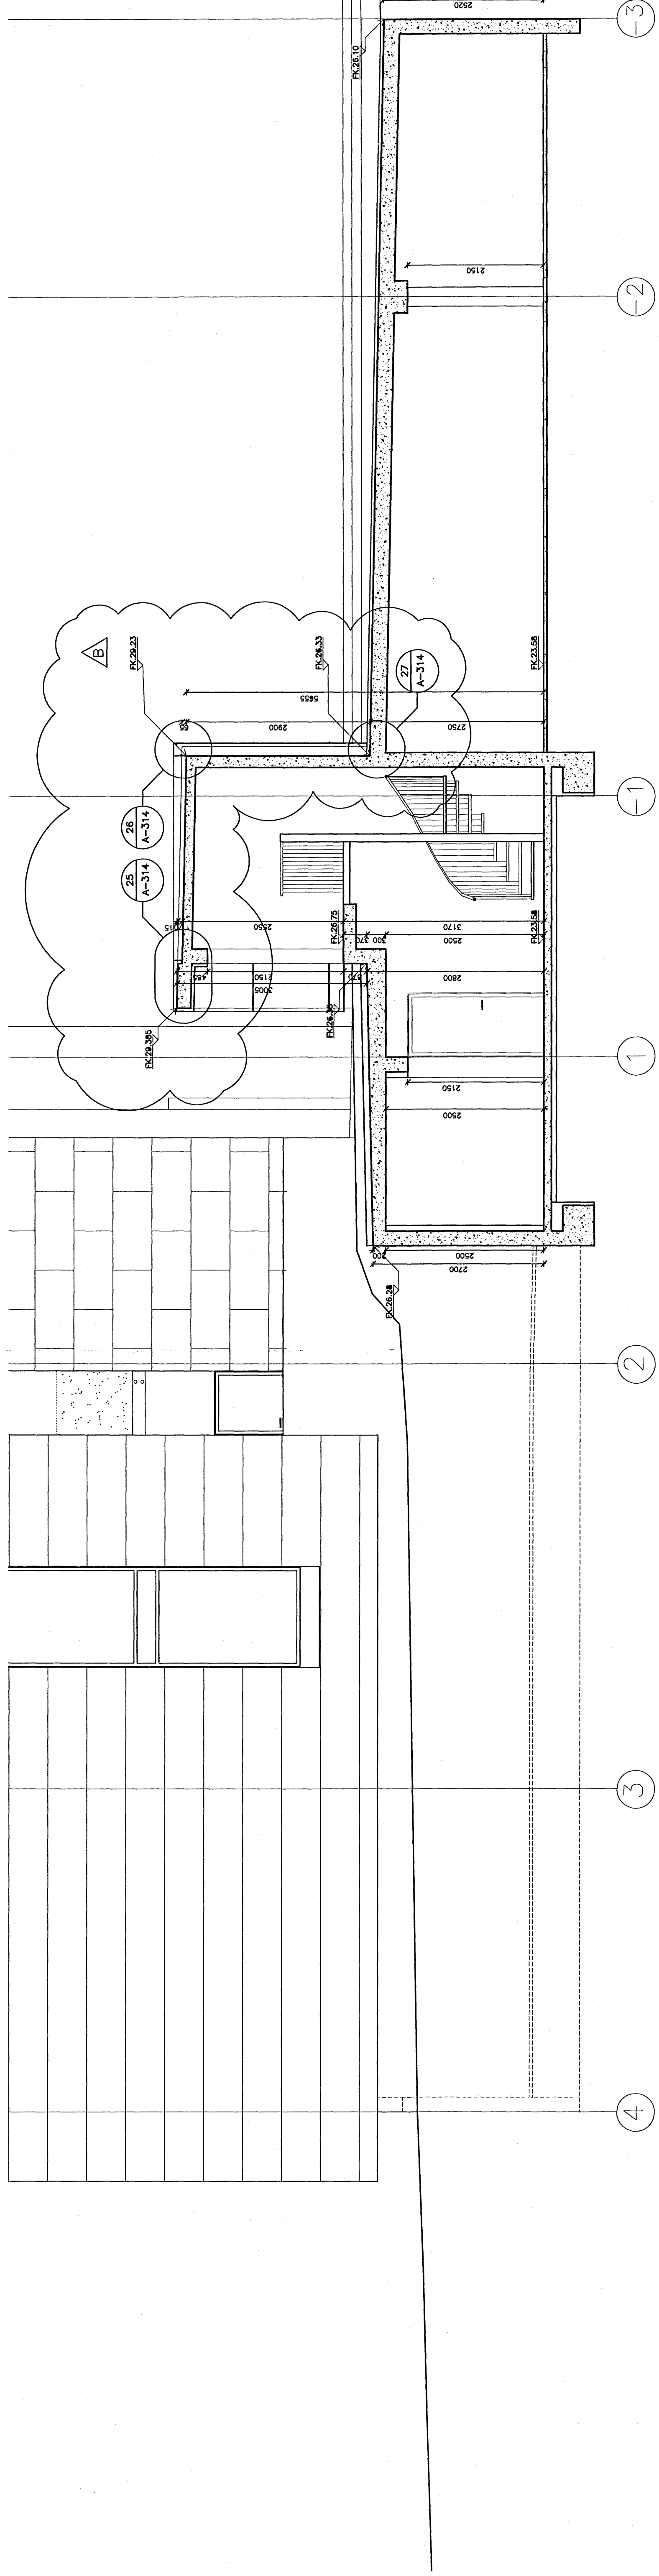

SNID E-E - ÚTLIT VESTUR

C:  
 B. Sérhúsmælingar and E-E  
 A. Plötur yfir hörgrymslu einhella.  
 Breytingar  
 07.06.06  
 19.10.04  
 DMS

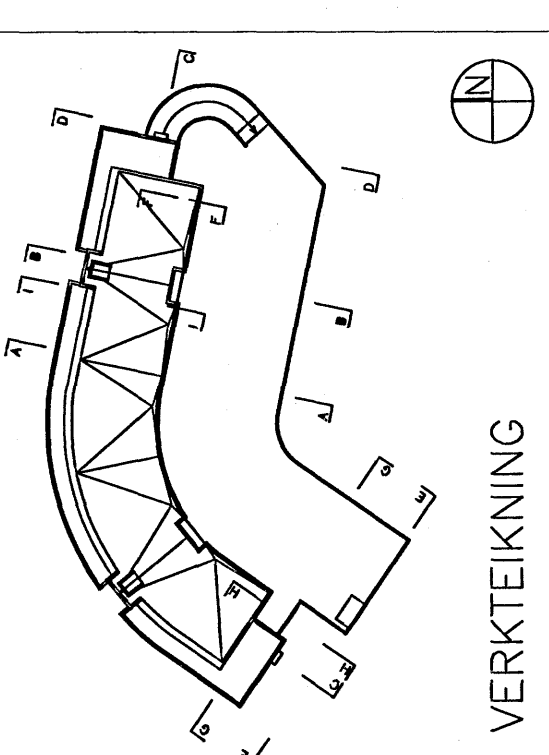

VERTEIKNING

Dalshraun 1, Hafnarðírói  
 Ris eftir  
 Dýringarbraut / Risarvegur  
 Algjarnarhluti  
 23 JUN 2008  
 DALS 0406  
 1:50  
 KVADR.:  
 09.09.04  
 TEKNI:  
 08  
 SNID 0-D-01 E-E

**ÚTI INNI**

**ARKITEKTAR**

ÞINGHOLTSSTRÆTI 27 101. REYKJAVÍK  
 SIMAR 552 7860 & 562 7860 FAX 552 7861  
 NETFANG  
 BALDUR O. SWANESSON  
 120357-5116  
 ARKITEKTOR FM  
 JÓN LÖR ÞORVALDSSON  
 021255-7579  
**B**  
**A-238**