


Samykktt þann
 21 JUNI 2007
 Byggingulfrúnni í Hafnarfjörð
 F.h.Sigurjartur Halldórsson

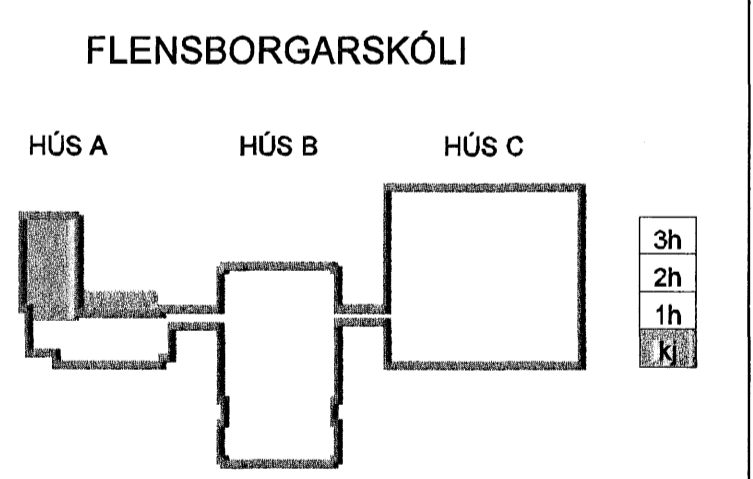

A 12.06.07 Breytingar á lögnum KMJ/SAS
 Útg. Dags. Skýring Hannadóttir/Hafnarfjörður

ARKITEKTAS TO FAN
 SÖLUGATA 1, 105 REYKJAVÍK
 Hannadóttir/Hafnarfjörður
 KÍ 020235-4829

VSB
 VERKFRÆÐISTOFA

B.EJARRHALIN 20 • 220 HAFNARFJÖRÐUR • KENNIT. 710700-2899
 vsb@vsb.is • Sími 585 8600 • Fax 585 9810 • www.vsb.is

Ártun sérhönnuðar
 Sveinn Áki Sverrisson KÍ: 230855 5806

Verkhúsi
BREKKUGATA 19
HAFNARFJÖRÐUR

Verkhúsi
LAGNIR
GRUNNLAGNIR N

Hannadóttir	Teiknað	Yfirfarð	Kvarði	Síða
KMJ	KMJ	SAS	1:50	/ A1
Dags.	Verkefni	Teikning	Útgáfa	
03.02.2006	04836	A-P2-G U1	A	

V:\2006\04836\Project\04836\Sheets\A-hal\A04836_A-P2-G_U1.dwg