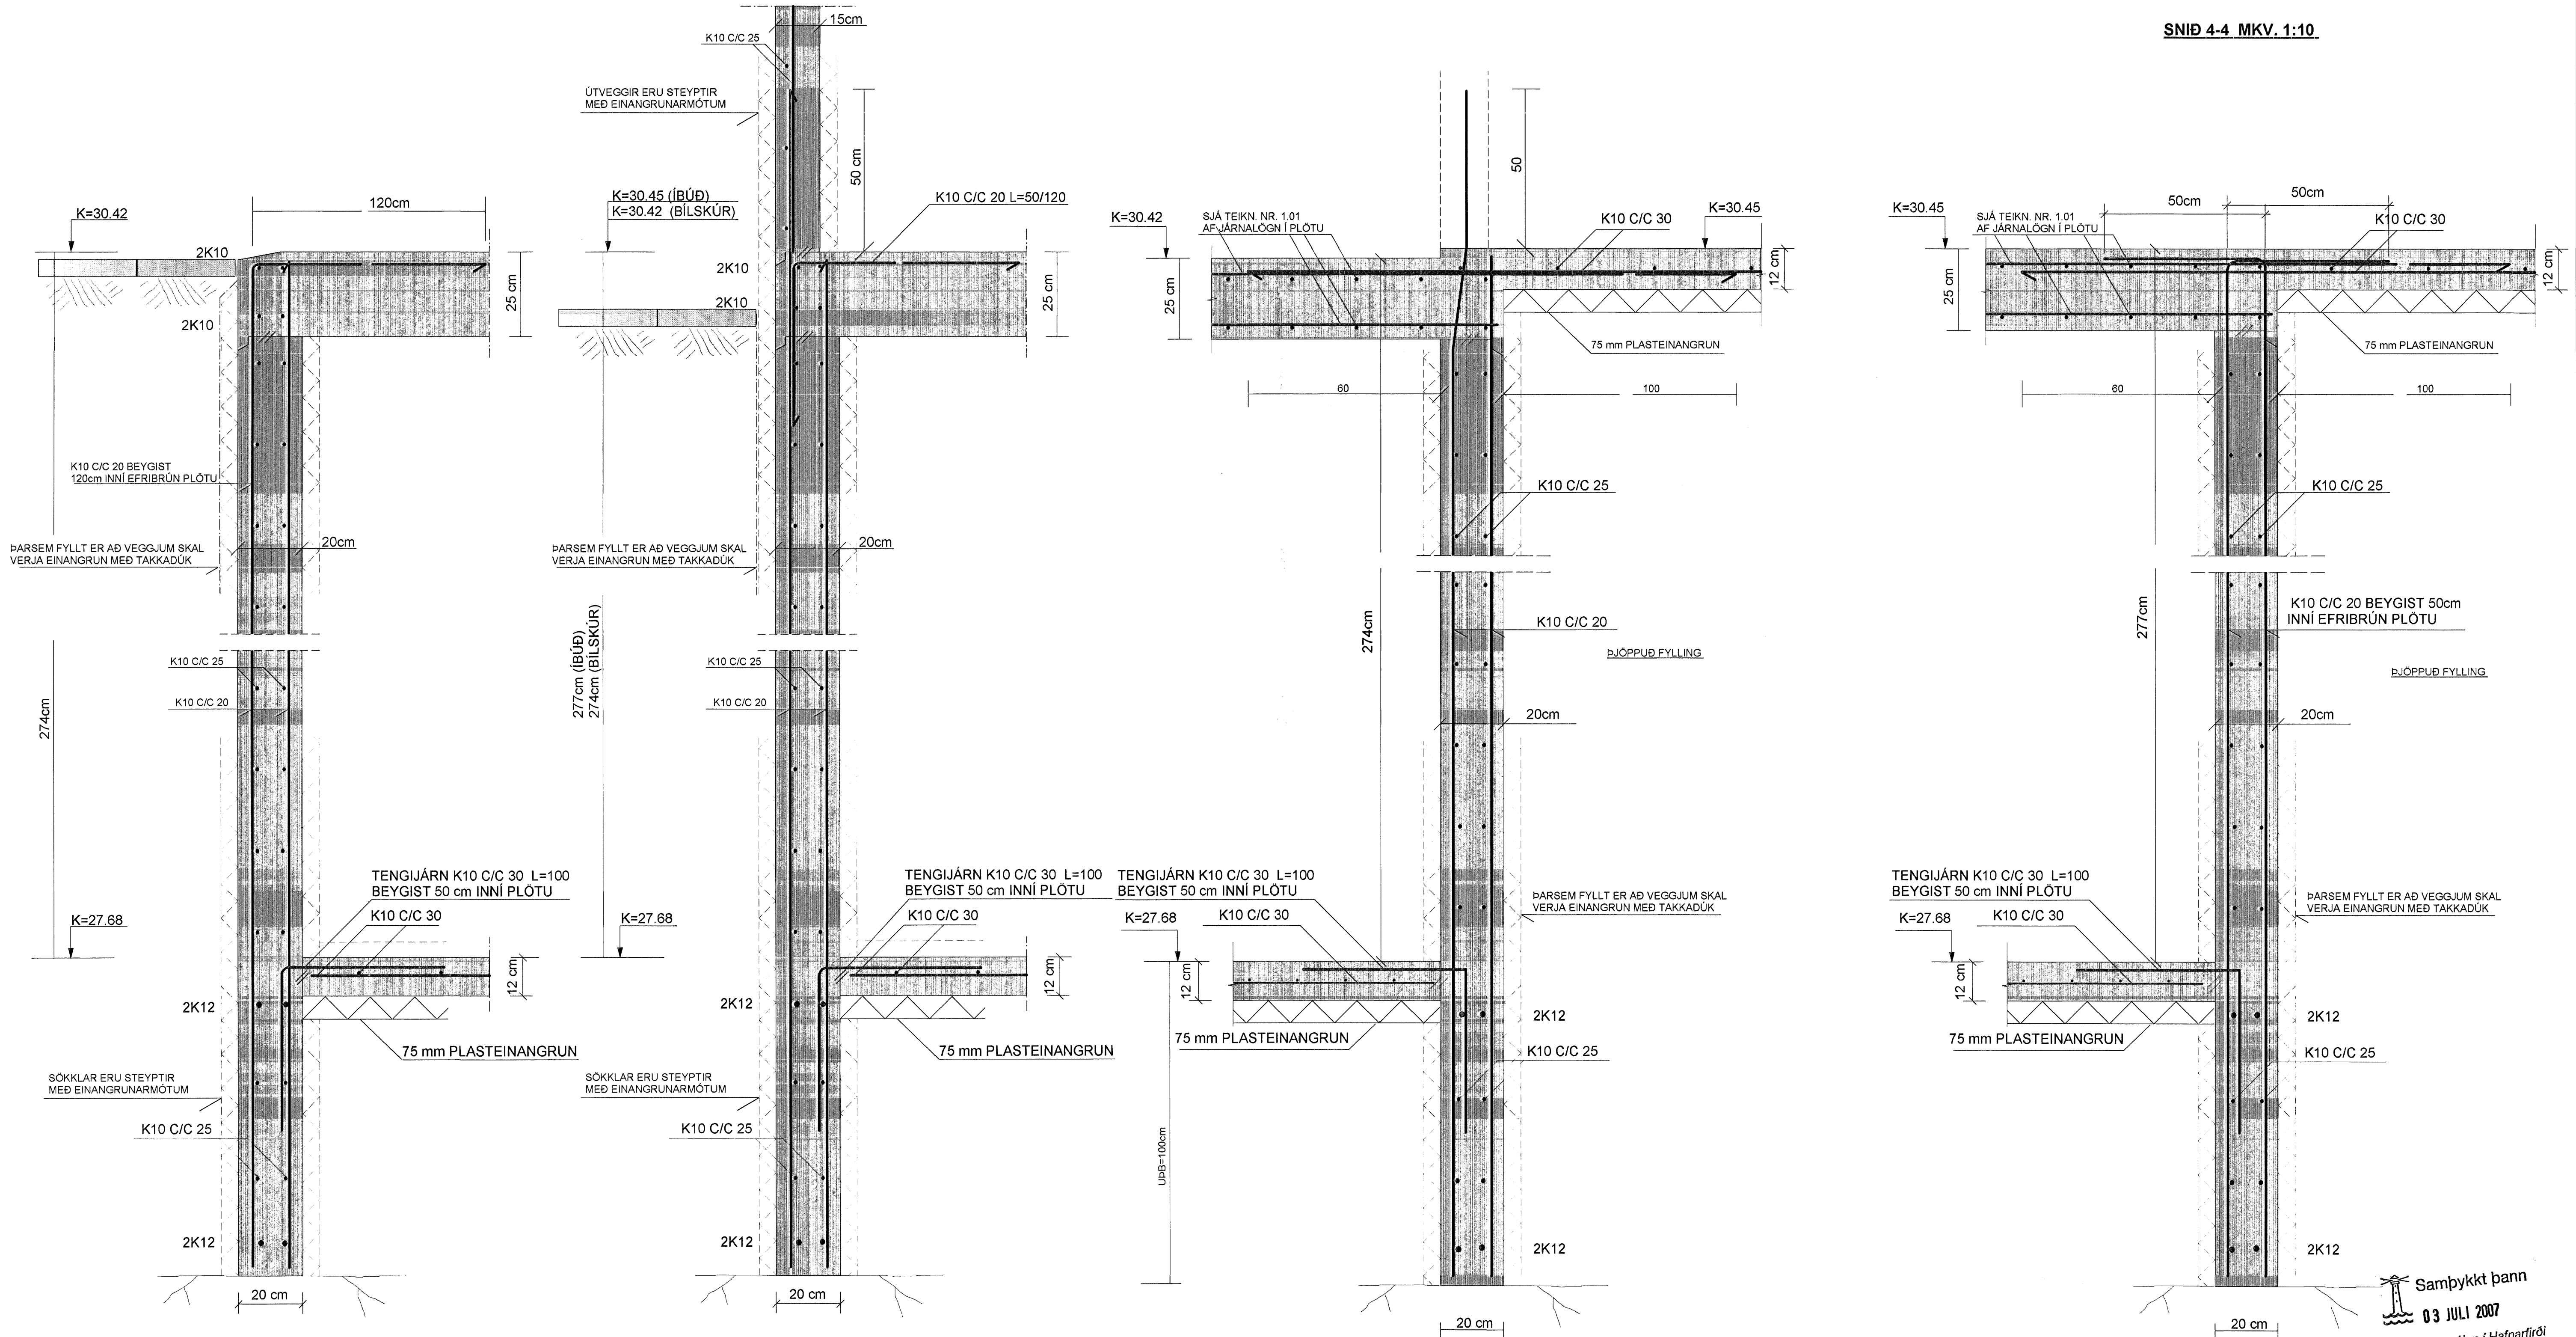


SNID 1-1 MKV. 1:10

SNID 2-2 MKV. 1:10

SNID 3-3 MKV. 1:10

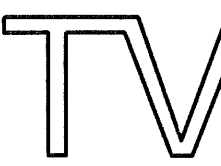
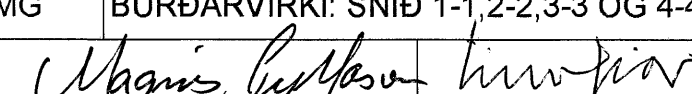
SNID 4-4 MKV. 1:10



Samþykkt þann  
03 JULI 2007  
Byggingufulltrúinn í Hafnarfirði  
F.h. Sigurbjartur Halldórsson

SJÁ SKÝRINGAR Á TEIKNINGU NR. 1.01

① BREYTT: 02.08.2007 (Sníðum breytt, sökkjar og kjallaraveggir steyptr í einni steypu)

TEIKN.NR. 1.02	 Tæknivangur ehf. Kennitala 450586-1889 Kirkjustétt 26, 113 Reykjavík Sími 564 22 44, 6902325, Netf. tv@vortex.is
KVARDI: 1:10	
DAGS. MAI 2007	
HANNAÐ: MG	VERKEFNI: HNOÐRAVELLIR 42, HAFNARFIRÐI
TEIKNAD: MG	BURÐARVIRKI: SNID 1-1, 2-2, 3-3 OG 4-4 Í UNDIRSTÖÐUR
YFIRFARID:	 Magnús Gylfason (S) 201201-4199 Undirskrift Aðalhönnuðar