


ÚTLIT-NORÐUR

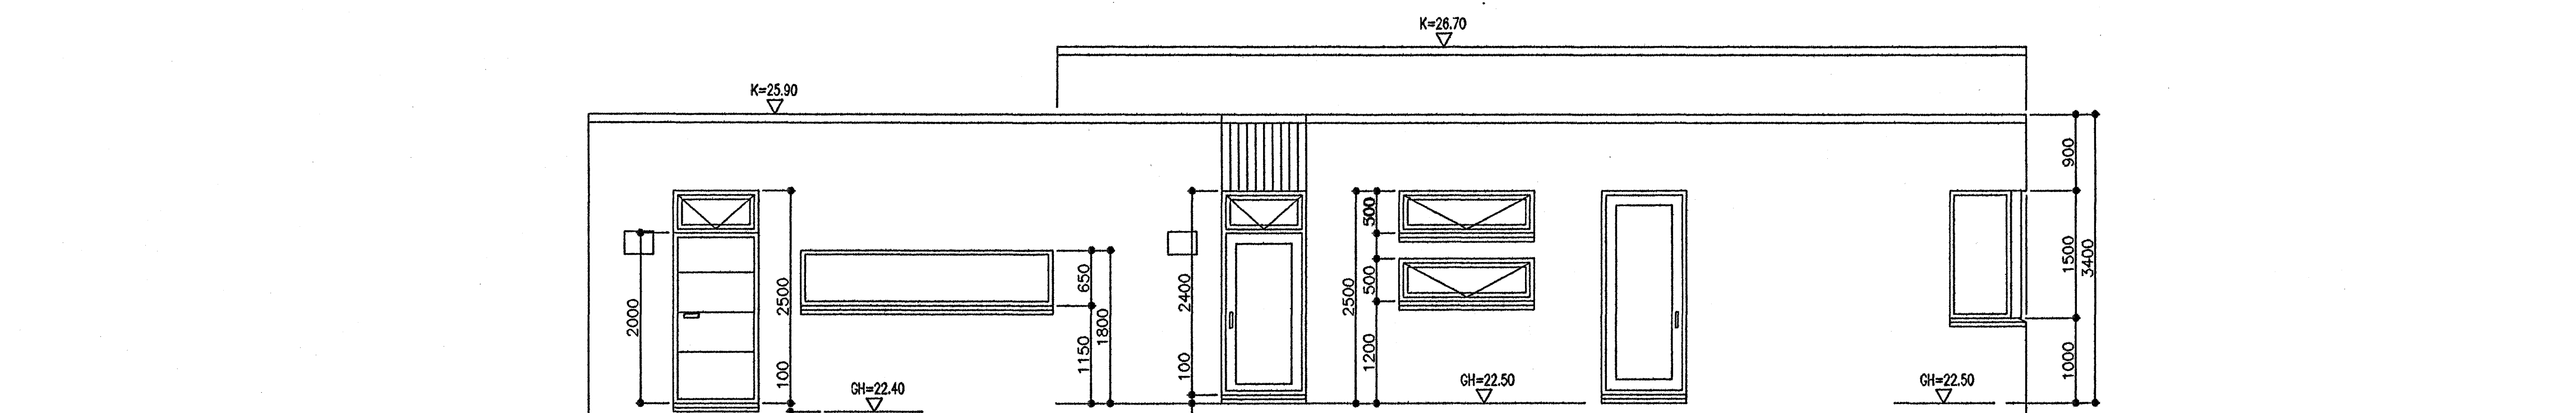

ÚTLIT-AUSTUR

Byggingafróðgættur Hafnarfjarðar
Alfreitt Þann
20 JUN 2006
[Signature]

Breytt 17.04.2006. Gilt v. innri breytinga.

FLÉTTUVELLIR 6 HAFNARFIRÐI
 ÚTLIT
 25. JANÚAR 2006. MKV. 1:50.
 Jóhannes Pétursson 010448-3959 S - 567-5107
 Sigurður Sigurðsson 010448-3959 S - 566-6613

[Signature]

ABS teiknistofa S - 566-6613 S - 567-5107 Nr. U2