




ÚTLIT SUÐUR
150

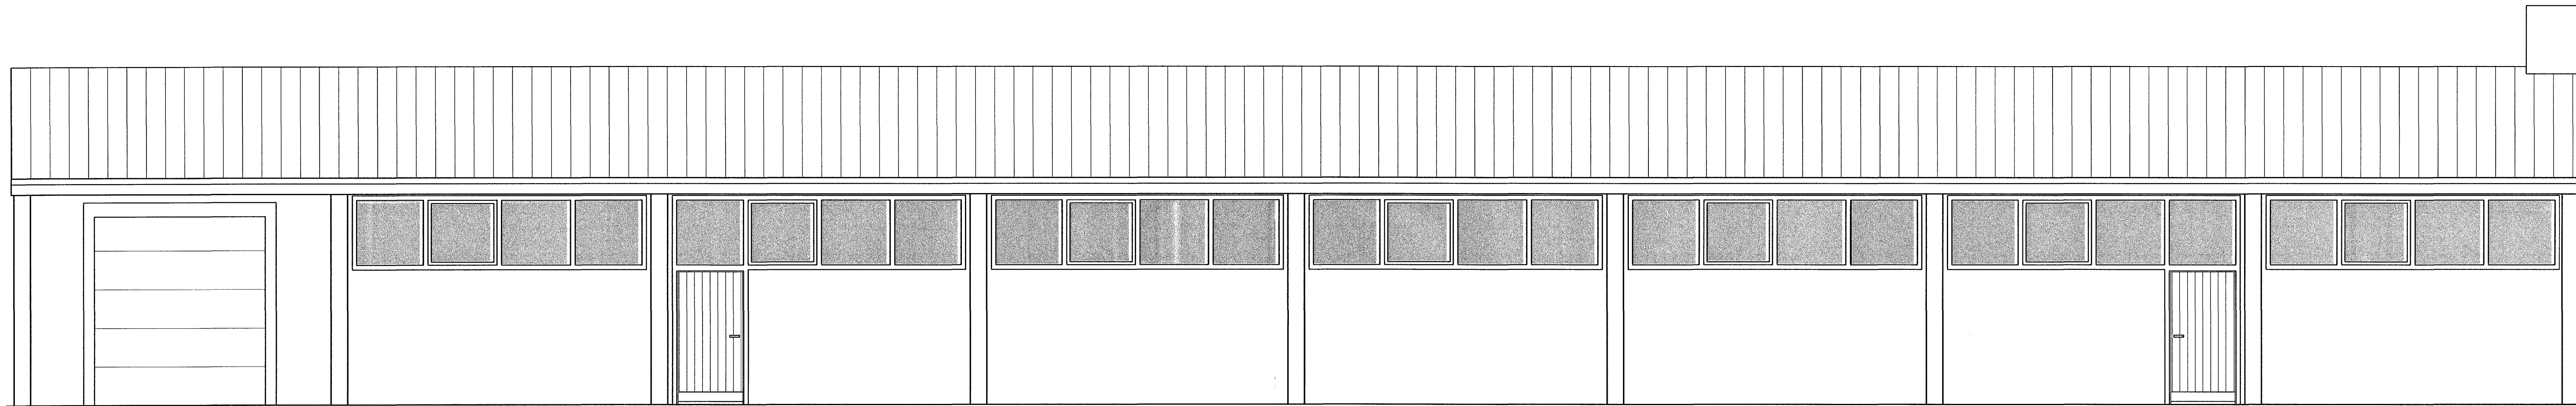

ÚTLIT AUSTUR
150

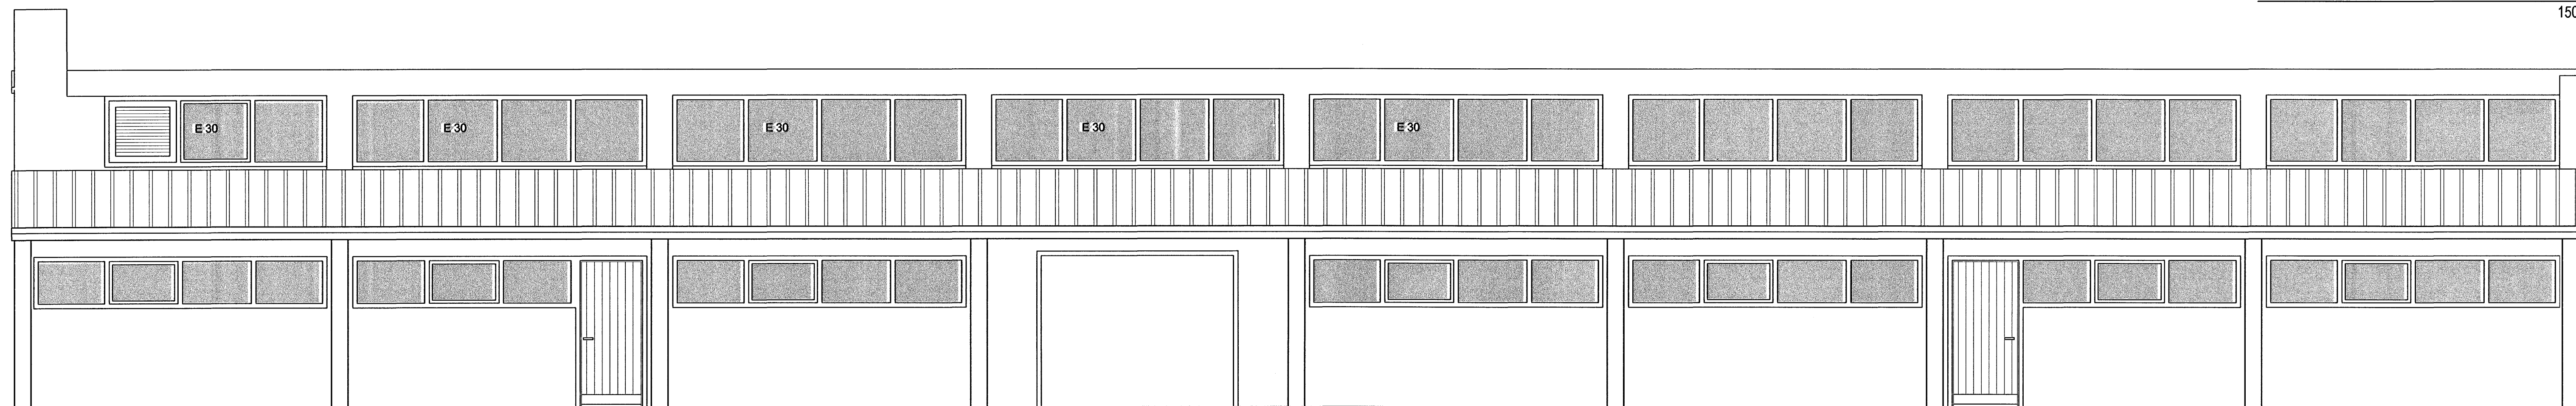

ÚTLIT VESTUR
150

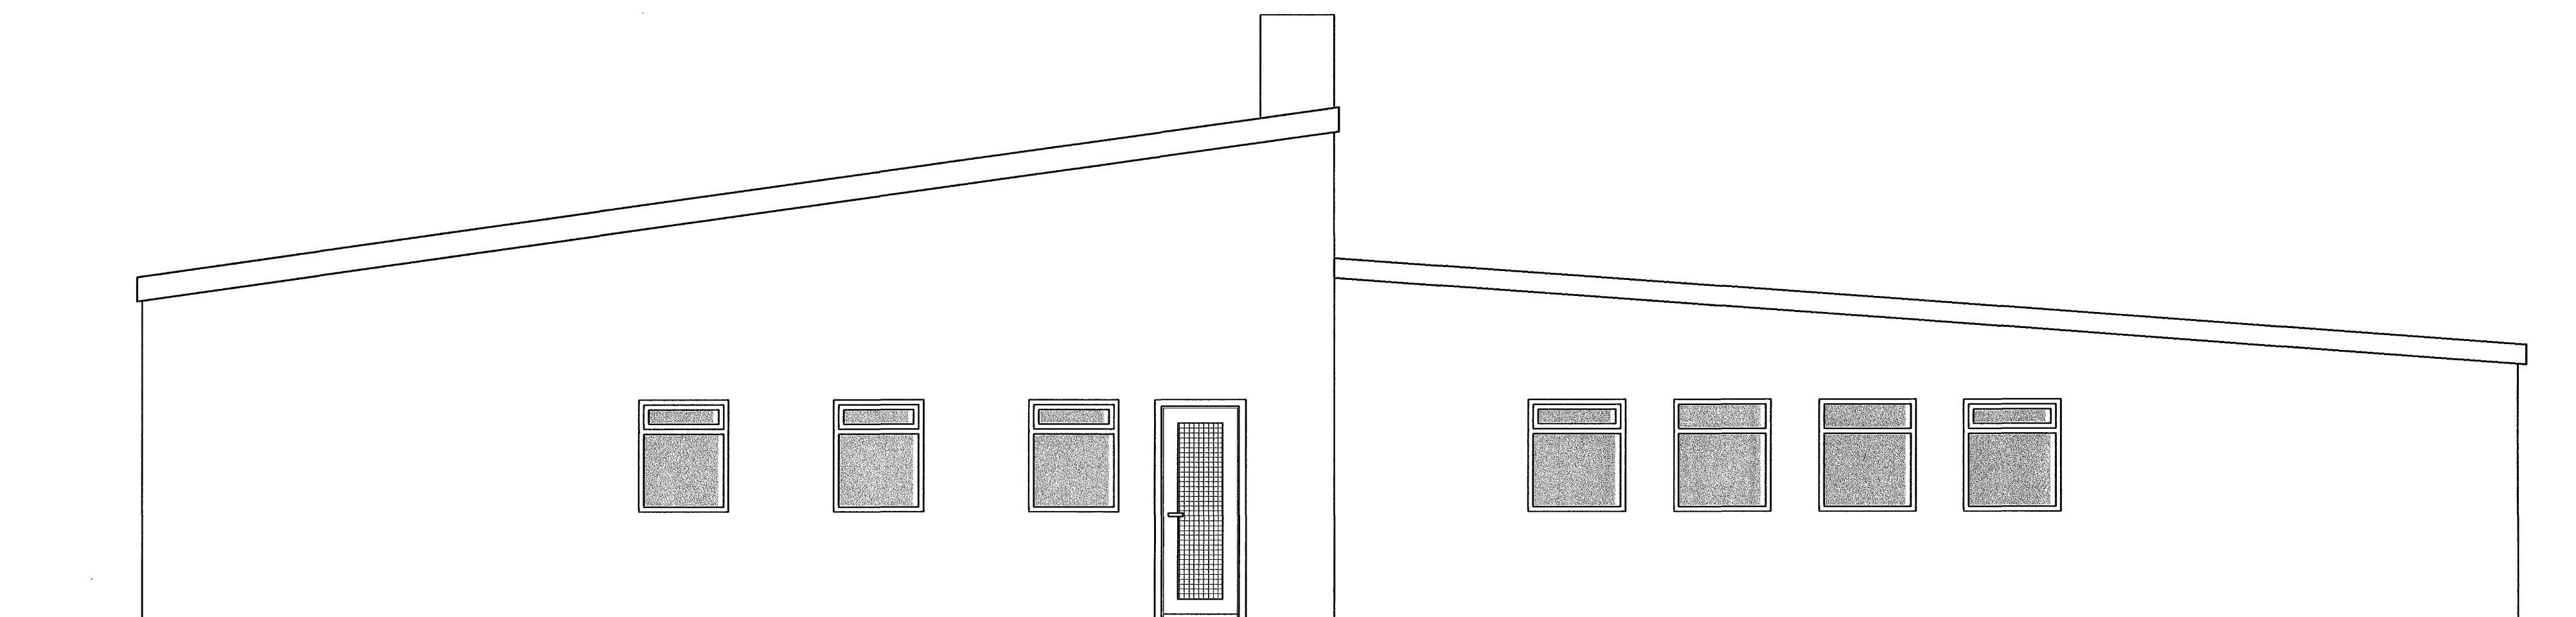

ÚTLIT NORÐUR
150

BREYTINGAR			Sb.
NR.	DAGS.	BREYTING	
1	02.05.06	Lagf. v/ lokaúttektar, brunamerkingar	

TEKTON
HÖNNUN - SKIPULAG - RÆÐGJÖF

HÁTEIGSVEGUR 7
105 REYKJAVÍK
ICELAND
KT: 471293-2109
HAUKUR HÁRÐARSON ARKIT. FAI / FSSA
GUÐM. HUÐI GUÐMUNDSSON
GUNNLAUGUR JÓNASSON ARKIT.

TEL: +354 561 1910
FAX: +354 561 1921
TEKTON@TEKTON.IS
WWW.TEKTON.IS
KT: 221162-2269
KT: 211066-5129
KT: 090462-2299

VERK
DALSHRAUN 6, HAFNARFIRÐI
ÍSLANDSPÓSTUR - DREIFINGARSTÓÐ
Byggingaáttir
Algreitt þann

TEKNING
ÚTLIT

19 JUN 2006

KVARÐI
A1) 1:50

2,5 M

DAGS.
20.09.2005

TEKNAÐ AF
GHG / GJ

TEKNING NR.
50-03

SAMDRÖKT
Gunnlaugur Jónasson