


L = 5.20

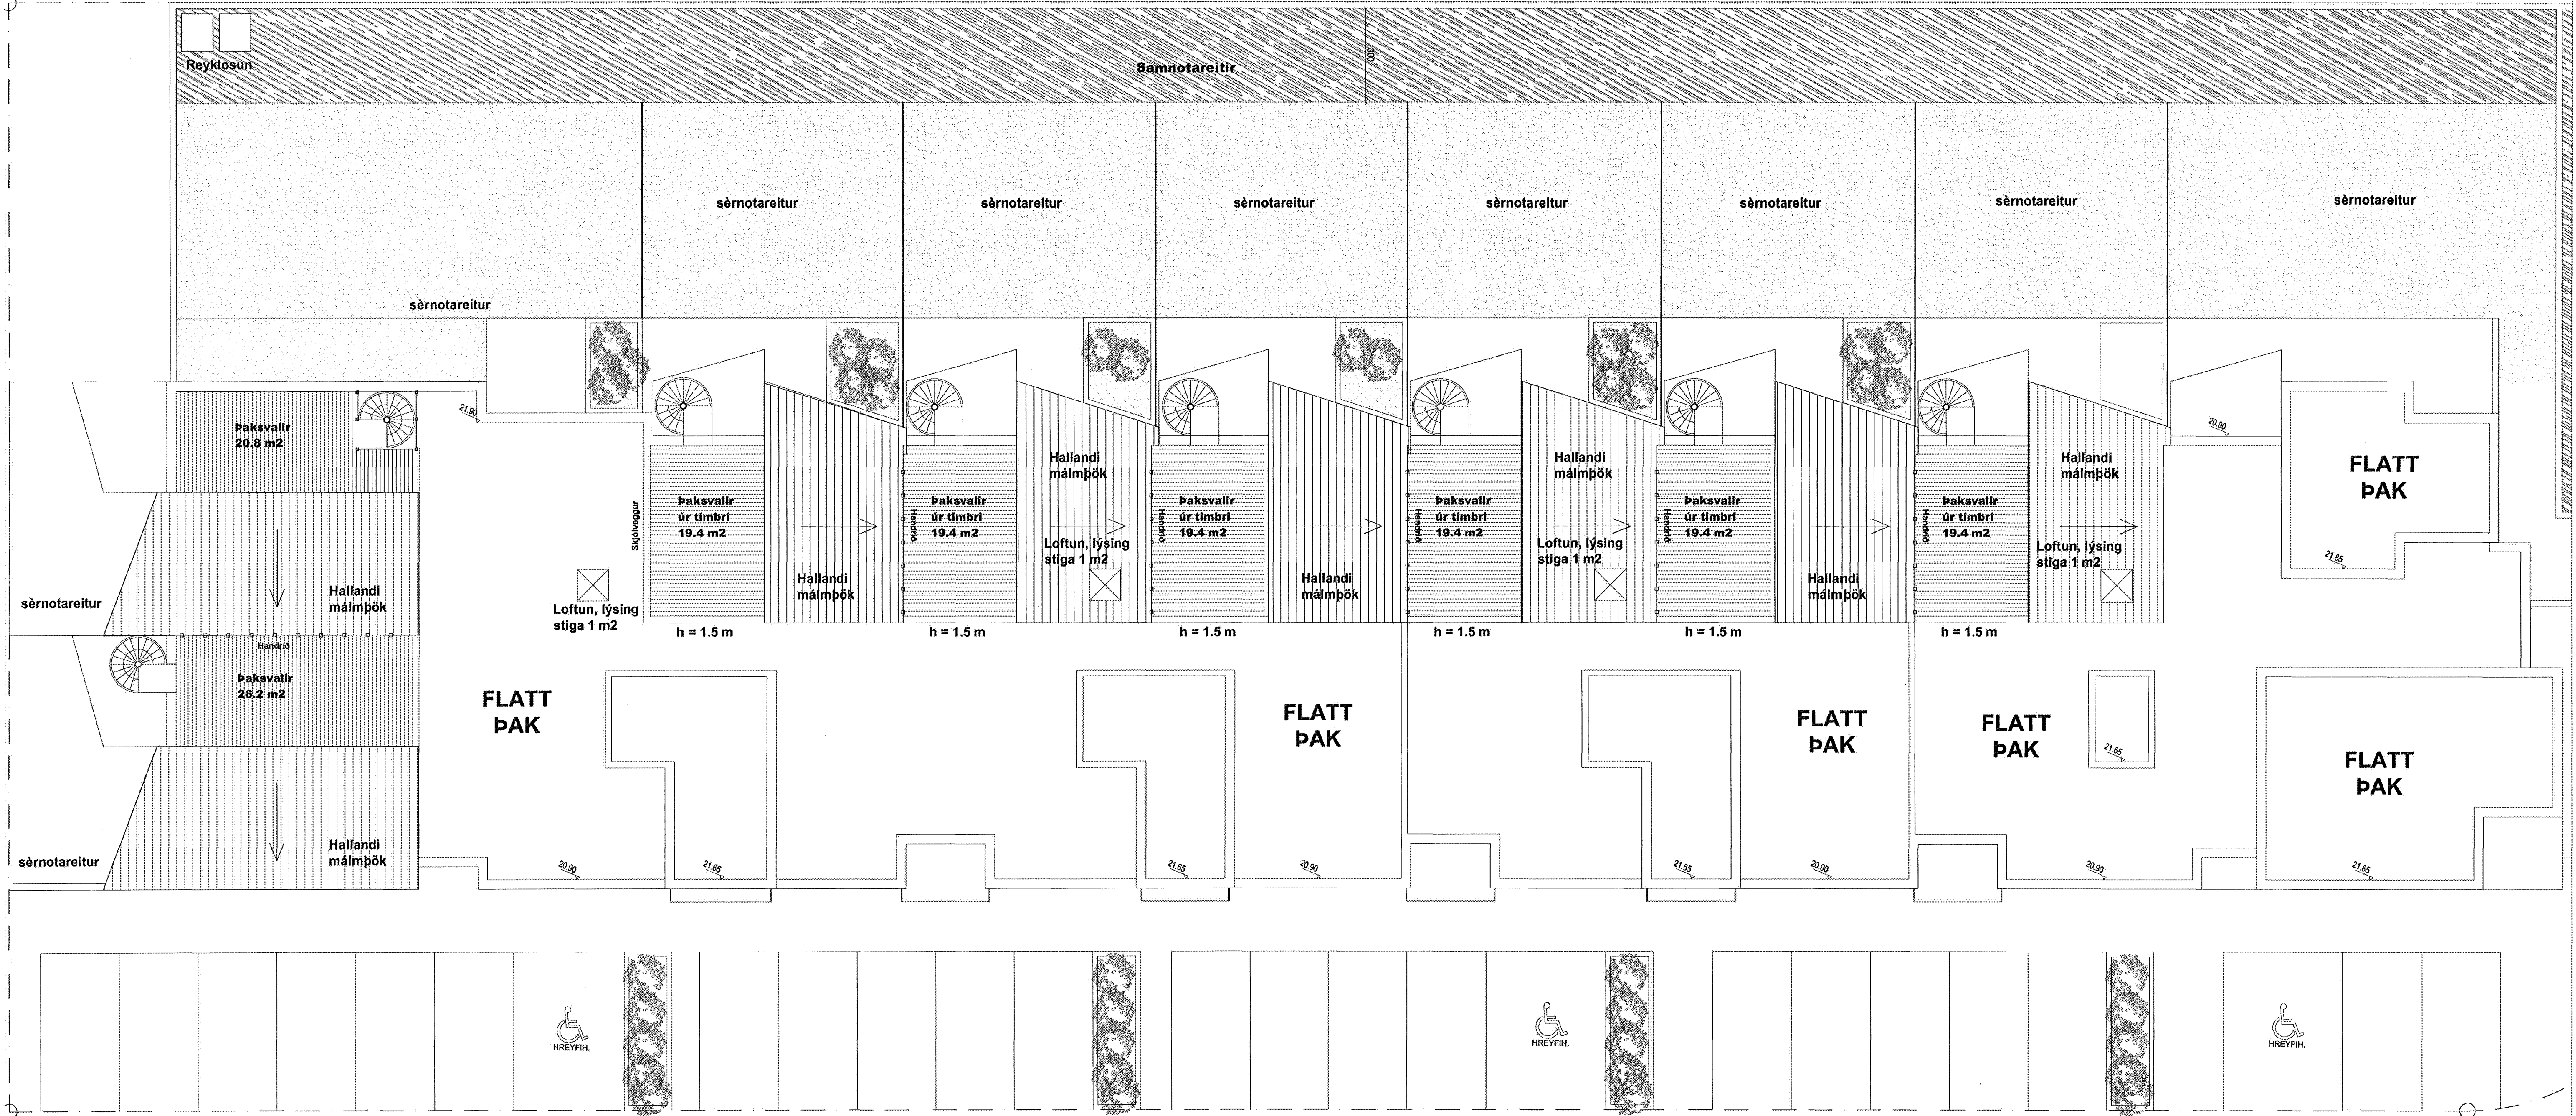

L = 4.80

L = 5.18

L = 5.27

Byggingaútlit frá Hafnarfjarðar
Afgreitt þann
13 JUN 2006
[Signature]

[Handwritten signature]