

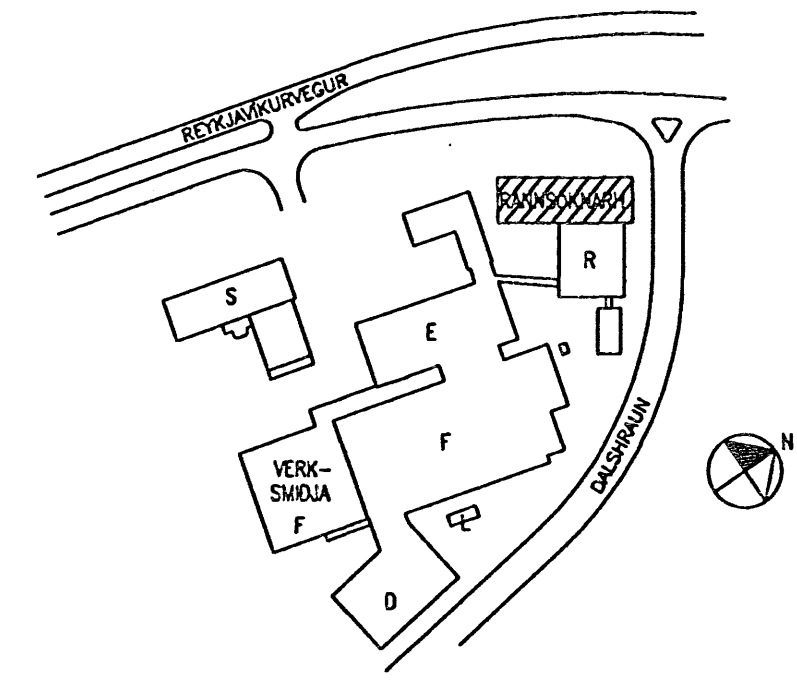
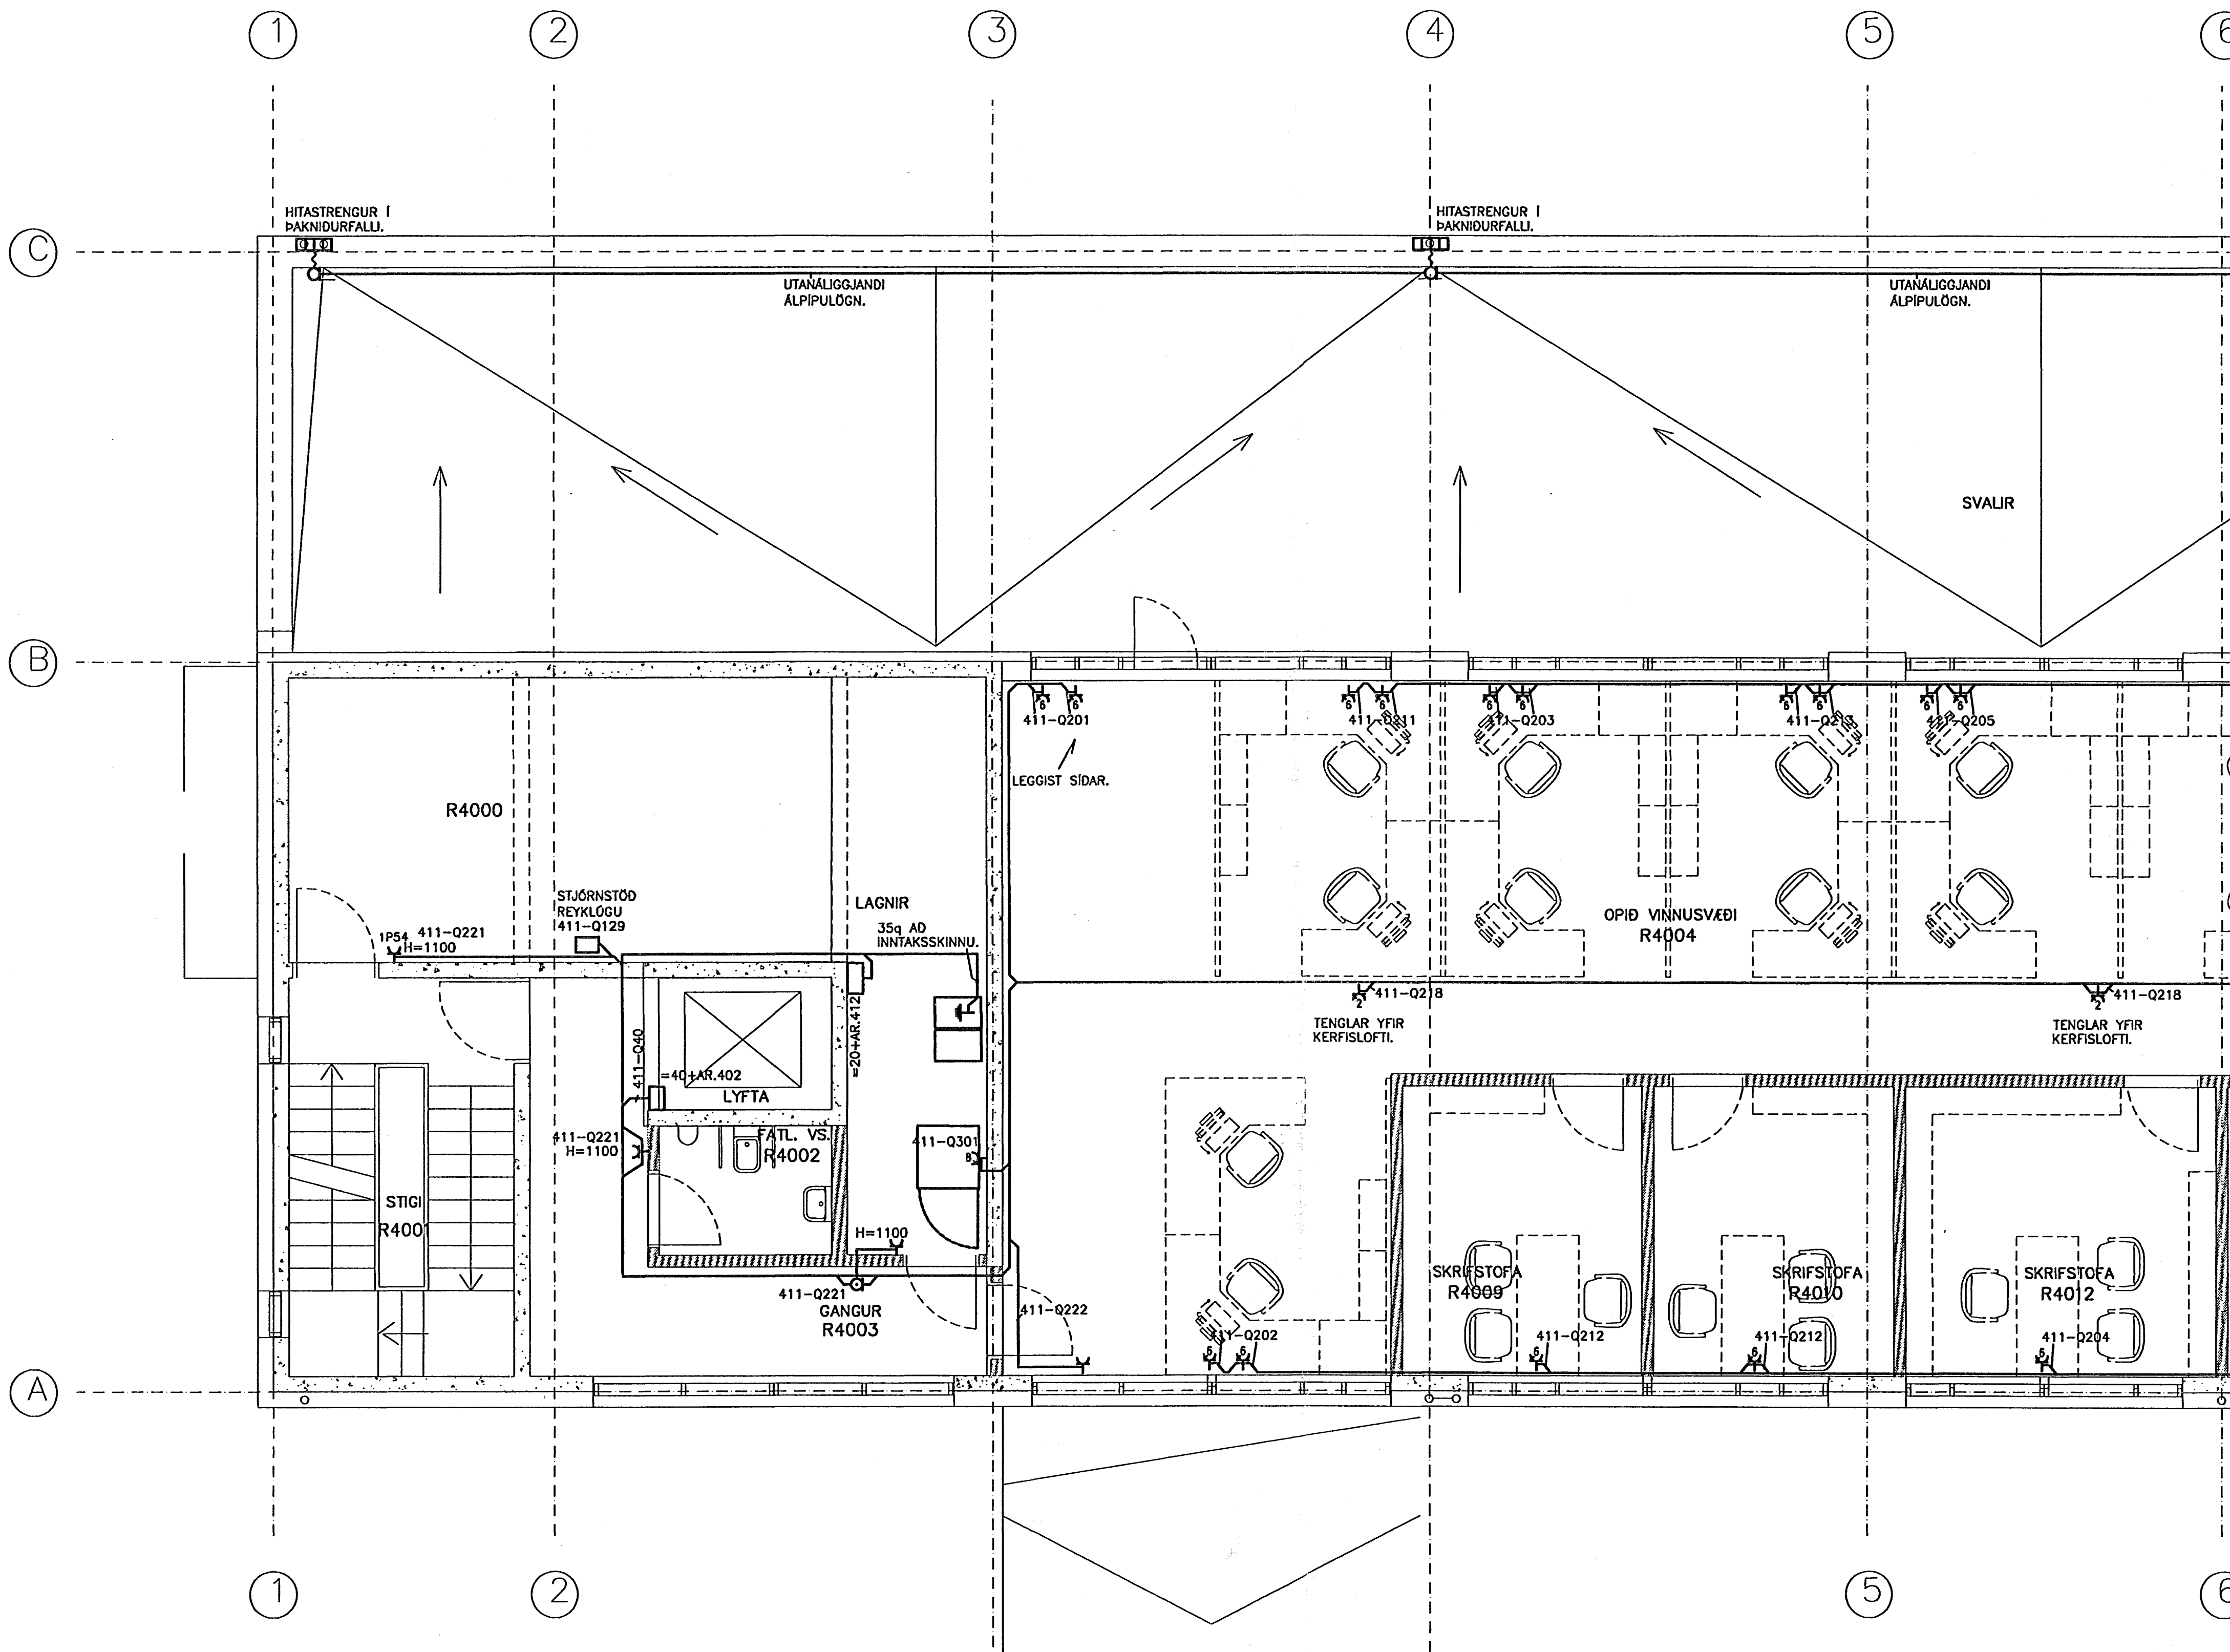


Egji með fjárháðri þessu teikningu til notkunar fyrir þrjú áhöf, né breyta henni án leyfis Rafteikningar hf.

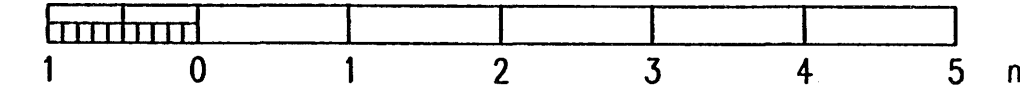

ÚTI  
ARKITEKTAR  
Jón Þór Þorvaldsson Af, FSSA  
Kt. 021256 7579

080655-4609  
Jón Þór Þorvaldsson

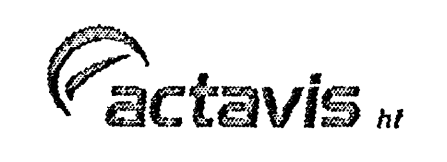

DTG.	DAGS.	TEIKN.	BREYTT	YFRF.	SAMP.	DTG.	DAGS.	TEIKN.	BREYTT	YFRF.	SAMP.	DAGS.
X	07.10.01	REYNDARTEIKNING						G.E	BIS	PH	PH	05.09.30
D	06.08.28	HITASTRENGUR I ÞAKRENNUR						RÖJ	BGH	PH	GLS	
C	06.06.08	KERFI ÖGVODAFONE OG REYKLÖGA						RÖJ	BIS	BGH	GLS	
B	06.03.22	TENGLAR FÆRDIR						RÖJ	BGH	HÞG	GLS	
A	06.01.03	BREYTINGAR VEGNA INNRETTINGA						KEG	KEG	HÞG	HG	

**RAFTEIKNING HF**  
RÁÐGJAFARVERKFRÆÐINGAR  
CONSULTING ENGINEERS



TEIKN. NR. VERKAUFA IS1R-E20-04.03D  
**REYKJAVÍKURVEGUR 80, HFJ.**  
R-RANNSÓKNARHÚS, NÝBYGGING  
4. HÆÐ - LAGSPENNUKERFI - AFLDREIFING  
TEIKN. NR. 20.5.R403 NESTA TEIKN. NR. DTG. X