
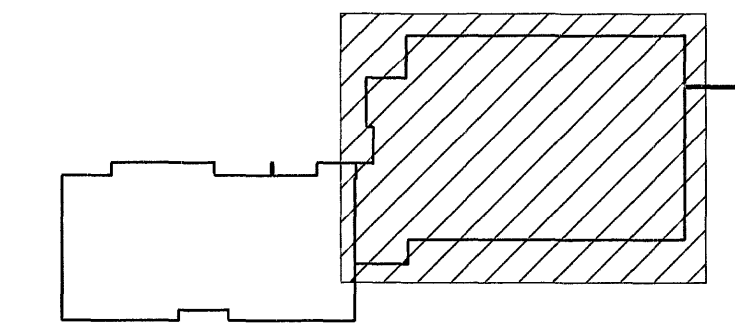


DAGS:	NR:	BREYTINGAR:	SAMB:
31.08.2007	213	BITA BÉTT VÍÐ OG BENDINGU Í PLÖTU	

Sambýkkt bann
24 SEPT. 2007
Byggingulltrúnni í Hafnarfirði
F.h. Sigurbjartur Halldórsson

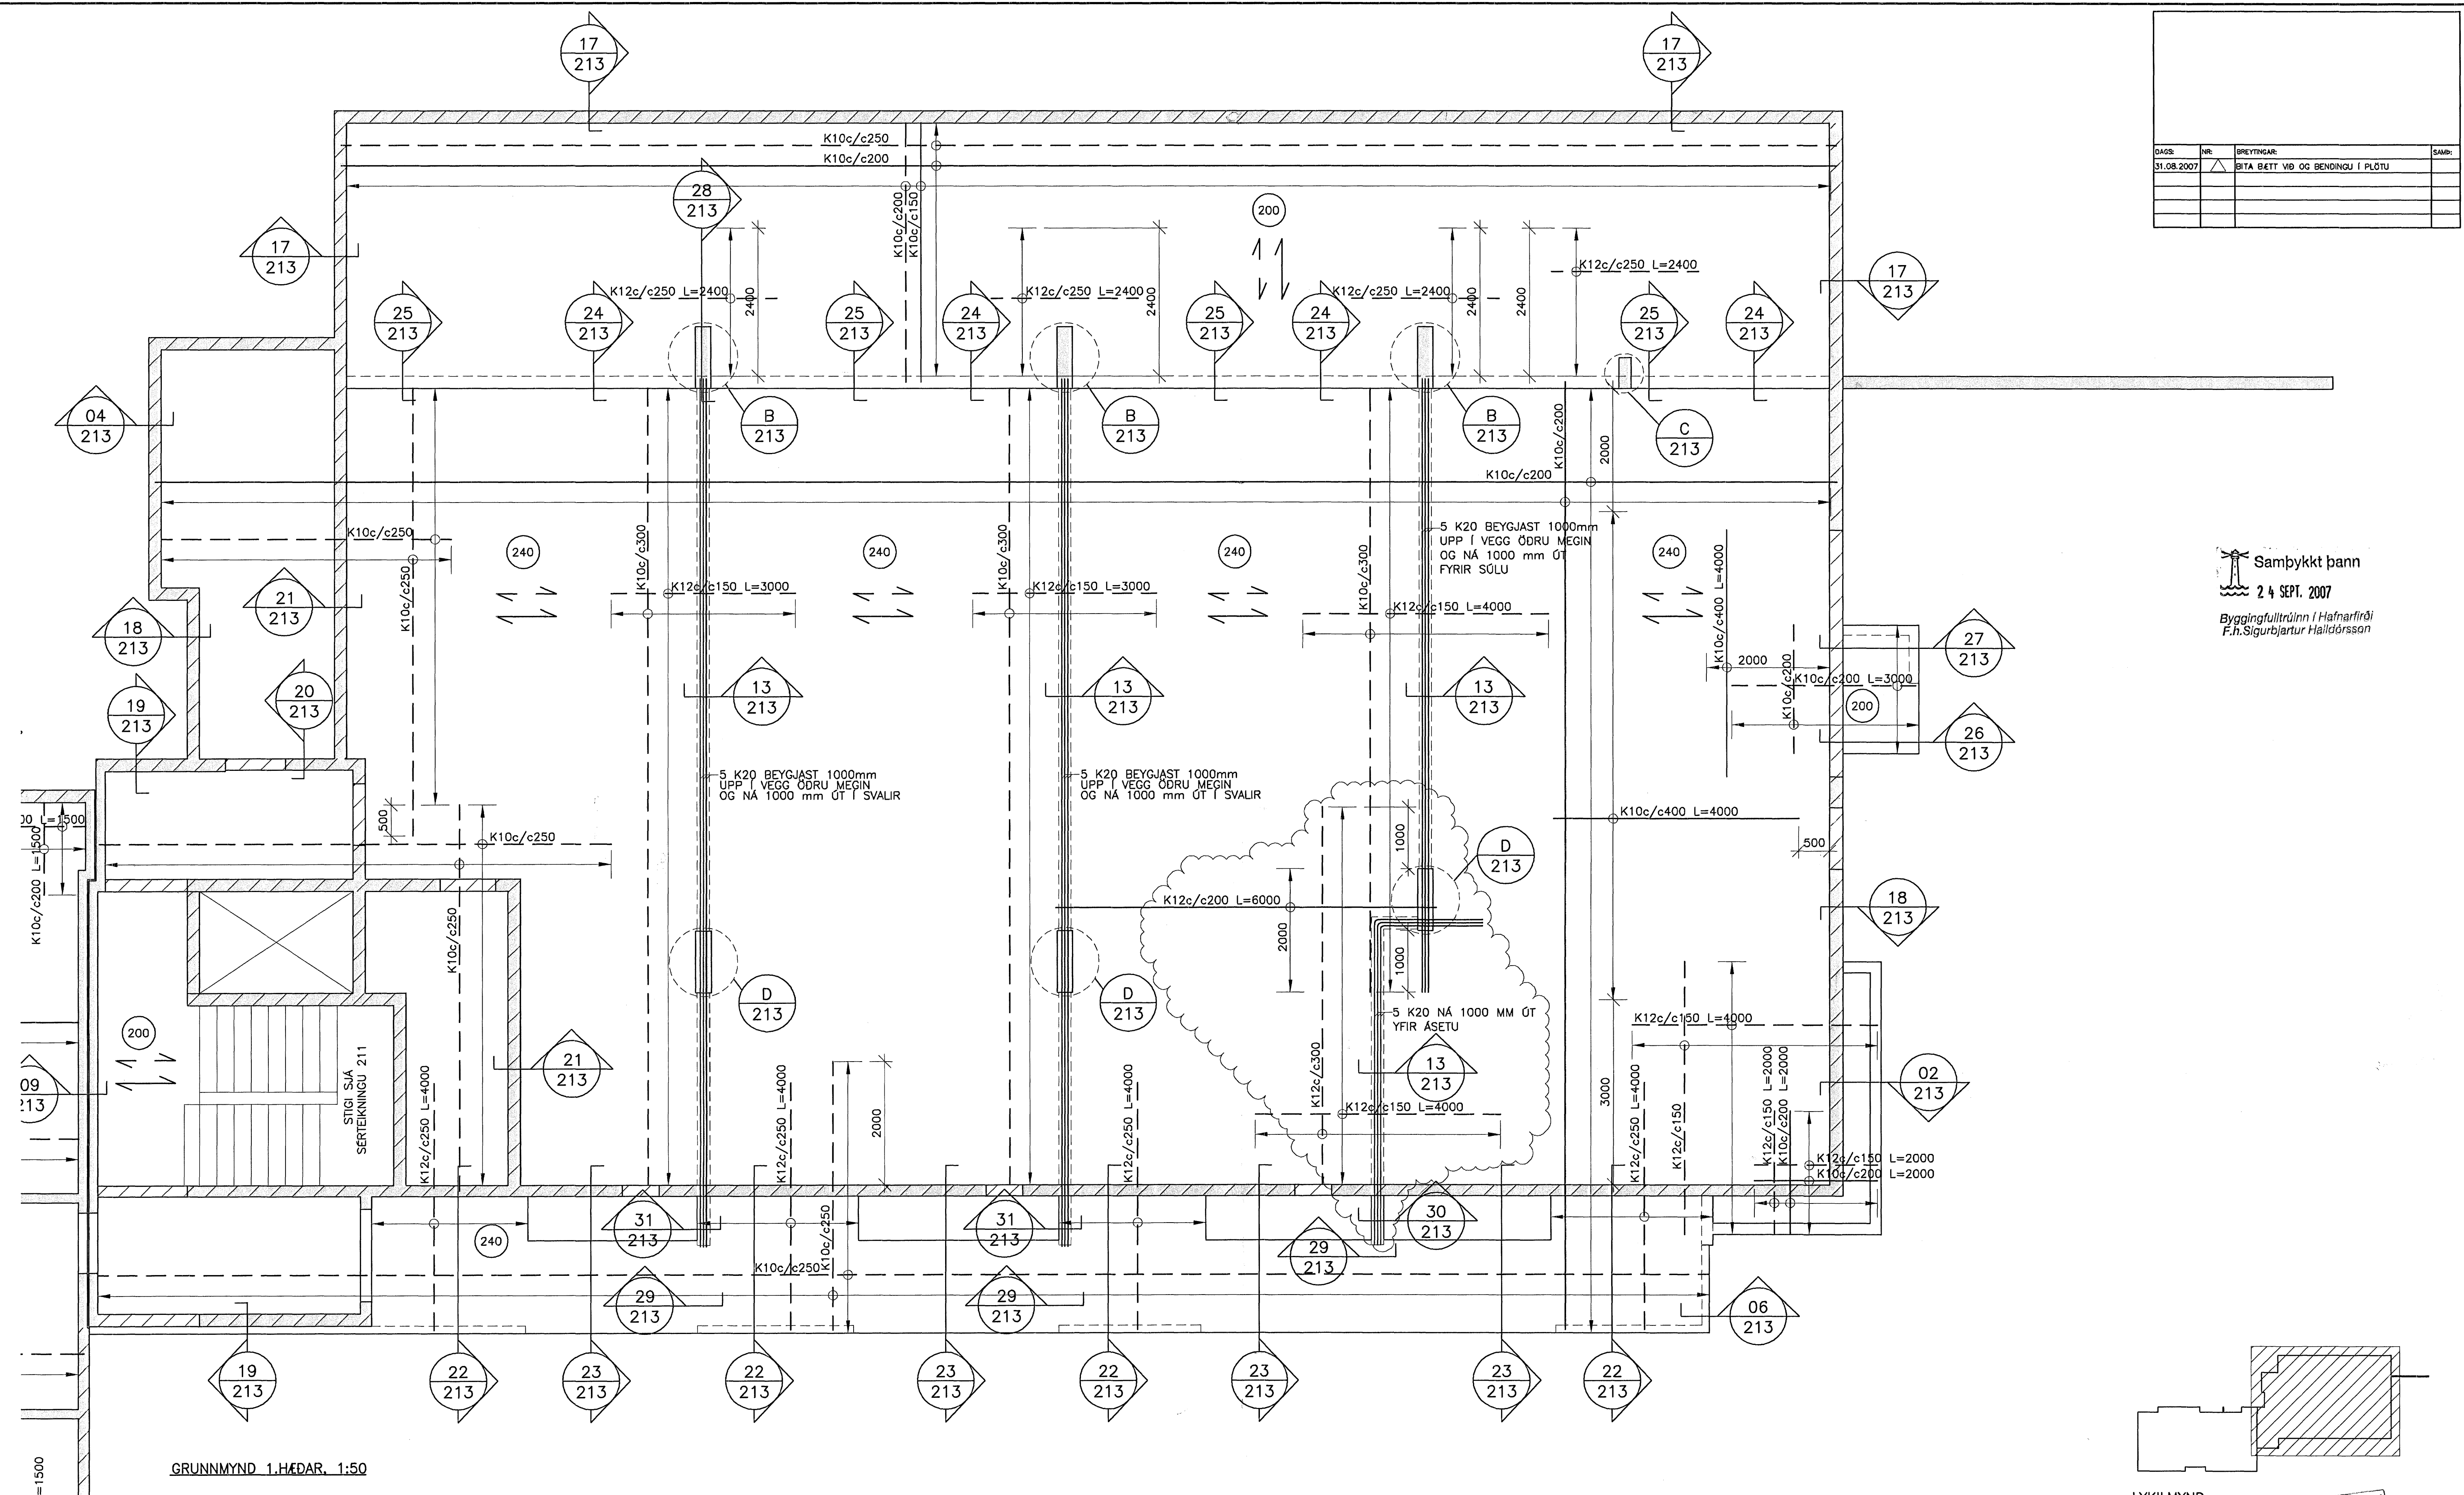

LYKILMYND

Móttaki:
Samb.: 31.08.07
Heimur

SKÝRINGAR SJÁ TEIKN. NR. 200

VERKFRÉÐIÞJÓNUSTAN EHF		DAGS: 30.03.07	
BREKKUAS 1-3		DAGS: 07.01	
HAFNARFIRÐI		DAGS: 211	
BURÐARVIKIL		DAGS: A	
PLATA FYR 1. HÆÐ		DAGS: 1:50	
GRUNNMYND		DAGS: 212	
SKYFAN 19	108-REIKNIAK	SÍMA 517 9050	NETFANG: jang@tekn.is ghor@tekn.is
VERKLEIÐI	07.01	DAGS	30.03.07
DRÖG	STEYPT HÖS	DRÖG	211
BURÐARVIKIL	Jón Guðmundsson	DRÖG	A
PLATA FYR 1. HÆÐ	280255-4329	DRÖG	1:50
GRUNNMYND		DRÖG	212
DRÖG	BÓS	DRÖG	BÓS
DRÖG	DRÖG	DRÖG	JG

JÄRNBENDING VEGGJA
 EINFÖLD GRIND K10c/c200.
 TVÖFÖLD GRIND K10c/c250.
 TVÖFÖLD GRIND K10c/c200.

